


MIDSHIP SECTION. S.S.Nº. 103

— DIMENSIONS. —

LENGTH B.P.	303' 0".
BREADTH MOULDED	42' 11½"
DEPTH "	22' 4½"

— CLASS: 100 A1. —

<u>EQUIPMENT</u>	
2 BOWER ANCHORS	42 1/2 CWTs. STOCKLESS
1 " " "	36 1/4 " "
1 STEER " "	10 1/4 " EX. STOCK
1 HEDGE " "	5 1/2 " "
STUD CHAIN CABLE	240 FMS. 1 1/2 "
STEER CHAIN	75 " 1 3/4" OR 4 1/2" STEEL WIRE
TOWLINE	100 " 12. HEMP OR 1 1/2 "
2 HAWSEYS	90 " 7 "
2 WARPS	90 " 6 "

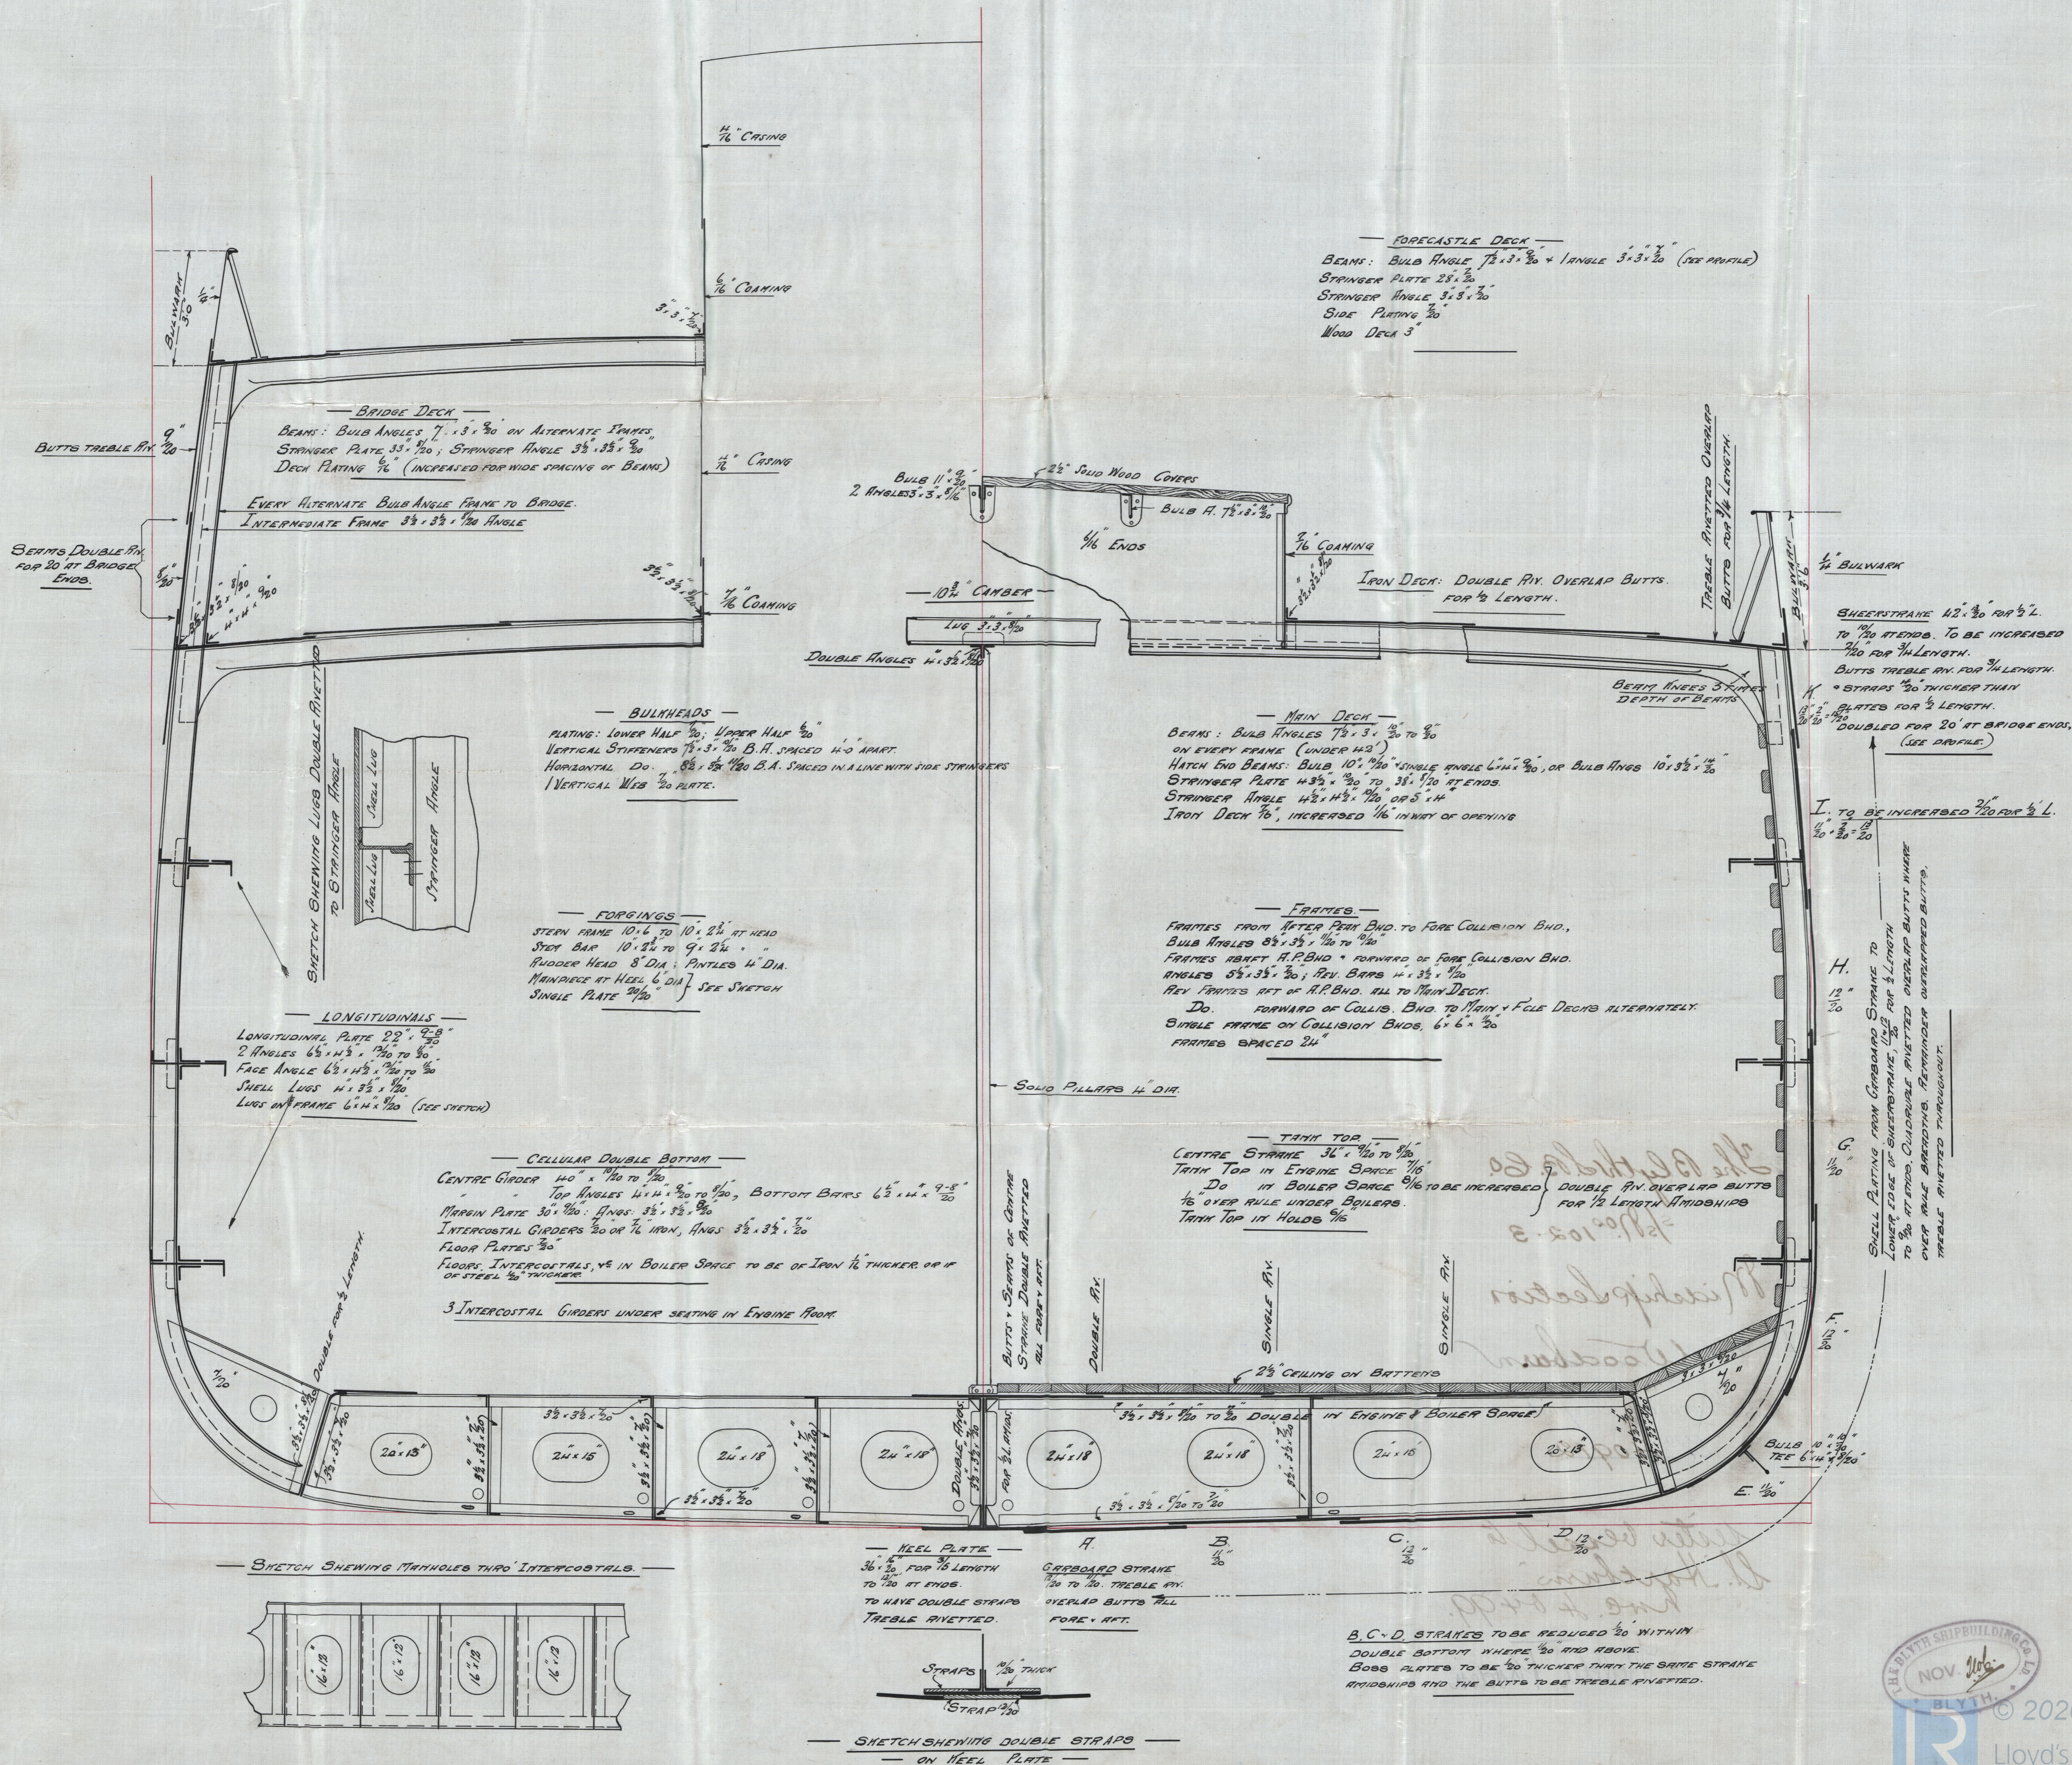

The Blyth S.B. Co.

s/s No. 102.3

Midship Section

99 Woodburn

Newcastle Report

No. 40912

Letter vessel to
S.S. "Hartburn"
h.w.c. 40499.

Halda Thoden



© 2020

Lloyd's Register
Foundation

003208-003216-0174