

2 MAY 1947


Lloyd's Register of Shipping.

Ship's Name

Hulda Thorden

Official No. ✓

Memorandum of alterations reported since ship was surveyed for assignment of Load Lines
in April 1932.

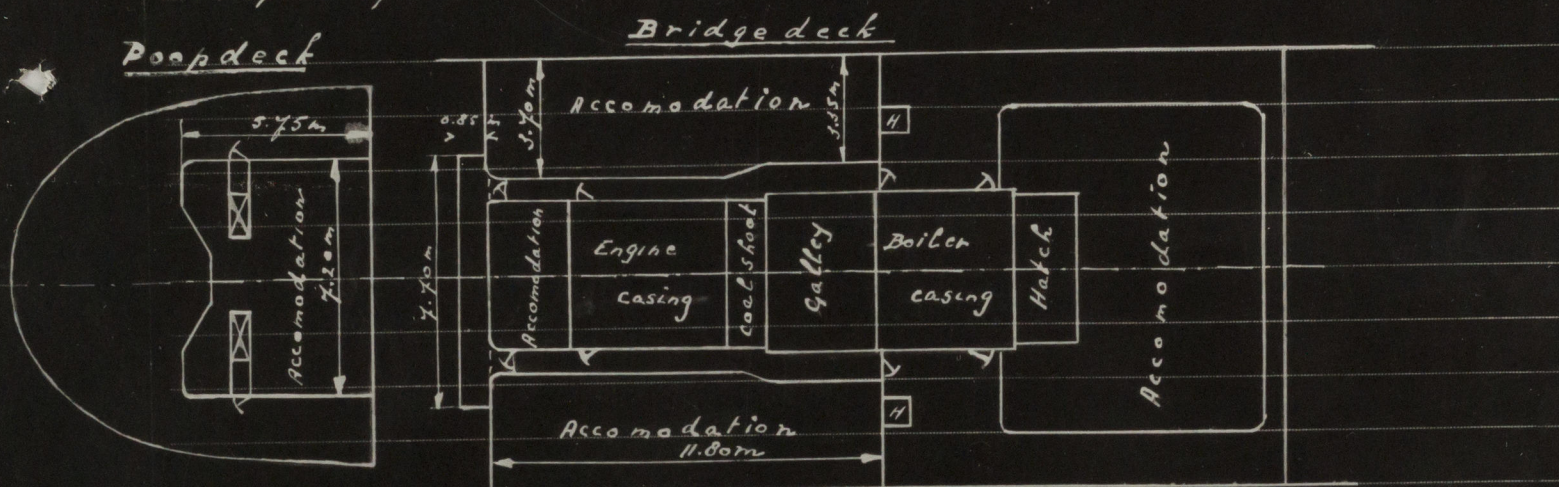

Companion way on fore castle deck removed, opening closed up. ✓
Fore castle bulkhead renewed, new opening fitted in the centre,
opening 1.60 x 1.10 m, hinged wood doors, operated from both sides, sill 18"

On the bridge deck a wing deck house has been placed (p.15) as
per above sketch, height 2.13 m, existing small wing deck houses
against engine casing removed. ✓

The coal bunker hatches have been altered and fitted in front of
both new deck houses. Dimensions 1.20 x 0.80 m, height 0.70 m, closing arrangements
as required. ✓

A platform has been fitted at after end of bridge, dimensions as per sketch.

On the poop deck a deckhouse has been built, dimensions as per sketch
height 2.13 m, enclosing a ladder way (p.15) Deck opening 1.40 x 0.65 m,
door opening 1.60 x 0.65 m, wood hinged doors, operated from both sides,
sill 18" ✓

Openings in poop front are closed up, no openings (except port lights)
in poop front bulkhead now.




© 2020

Lloyd's Register
Foundation