


Lloyd's Register of Shipping.

Ship's Name "Hulda Thorden"Official No. ✓

Memorandum of alterations reported since ship was surveyed for assignment of Load Lines in April 1932.

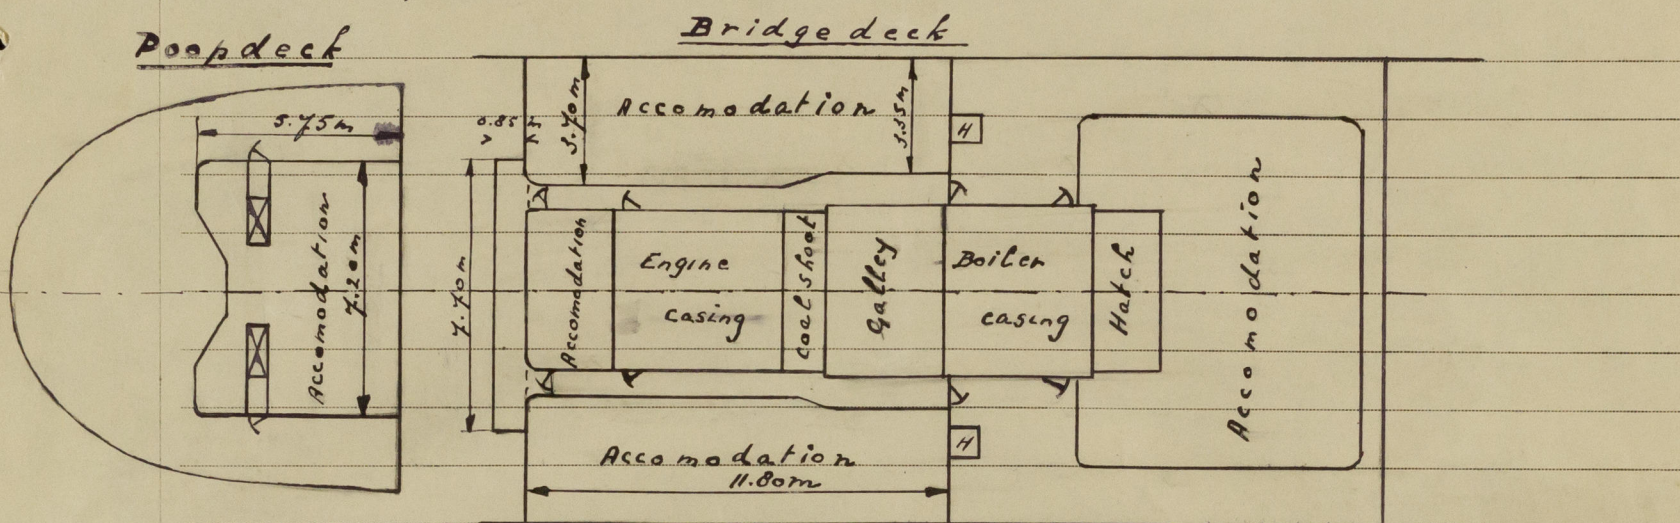

Companion way on fore castle deck removed, opening closed up. ✓
 Forecastle Bulkhead renewed, new opening fitted in the centre, opening 1.60 x 1.20 m, hinged wood doors, operated from both sides, sill 18" ✓

On the bridge deck a wing deck house has been placed (per) as per above sketch, height 2.13 m, existing small wing deck houses against engine casing removed. ✓

The coal bunker hatches have been altered and fitted in front of both new deck houses. Dimensions 1.20 x 0.80 m, height 0.76 m, closing arrangements as required. ✓


A platform has been fitted at after end of bridge, dimensions as per sketch.

On the poop deck a deckhouse has been built, dimensions as per sketch height 2.13 m, enclosing a ladder way (per) Deck opening 1.40 x 0.65 m, door opening 1.60 x 0.65 m, wood hinged doors, operated from both sides, sill 18" ✓

Openings in poop front are closed up, no openings (except port lights) in poop front bulkhead now. ✓

[Signature]

Noted
 5-5-47
 64
 60

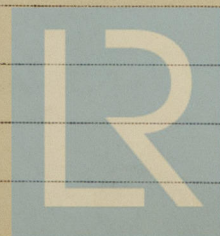

© 2020

Lloyd's Register
Foundation

003208-003216-0195