

151-CP X 81-82 X 13-0
Paper & Pencil

20.6.13

PROFILE & DECK PLAN



STEEL SCREW TRAWLERS

Nº 5582

DIMº 121'8" B.P. X 22'0" EXT. X 13'0" MLD

SCALE 1/4" INCH

PLAN No. 3754
FOR ENCLOSURE TO
Messrs. Lloyd's Register
Hall FROM
SHIPBUILDERS, SE
22/12/13.

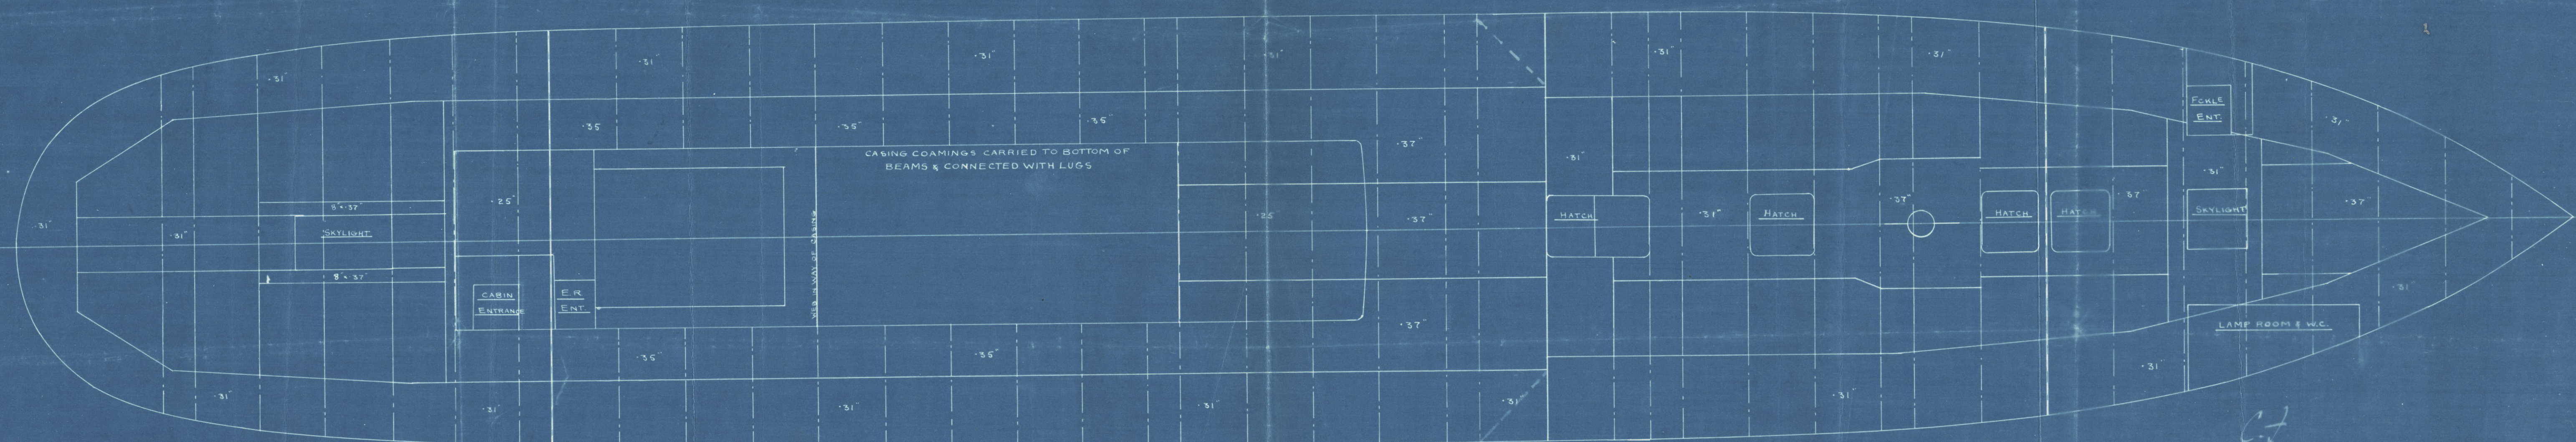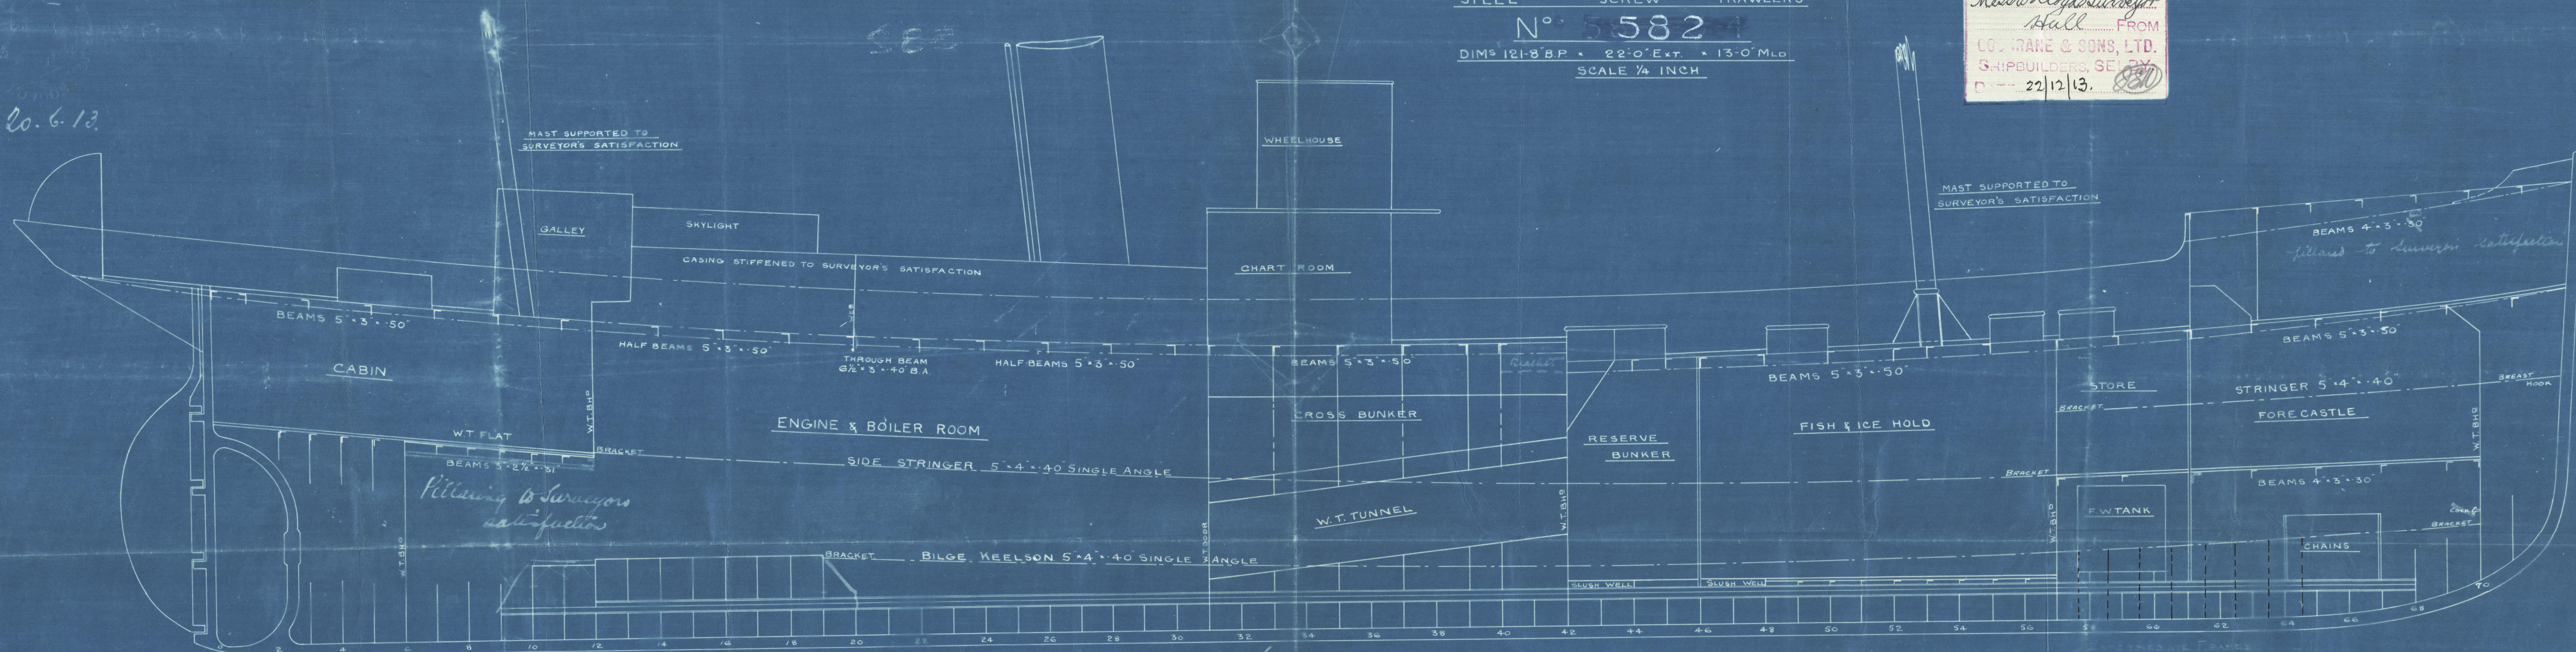

Cochrane & Sons. Ltd.
Nos. 581. 582. 583. 584
Duplicate -
Profile and Decks.

s/s. Beryl
Hull Rph No. 27185



© 2020

Lloyd's Register
Foundation

003208-003216-0199