

20.6.13.

MIDSHIP SECTION

N^{OS} 583

STEEL SCREW TRAWLERS


DIMS 121'-8" B.P. x 22'-0" E.T. x 13'-0" M.

SCALE 1/2" = 1 FOOT

TO CLASS 100 A1 LLOYDS STEAM TRAWLER

DECK PLATED OVER IN WAY OF
MACHINERY SPACE E. & B. CASING
AS PREVIOUSLY APPROVED

PLAN No. 3756
FOR ENCLOSURE TO
Messrs Lloyd's Surveyors
Hull FROM
COCHRANE & SONS, LTD.
SHIPBUILDERS, SE
DATE 22/12/13

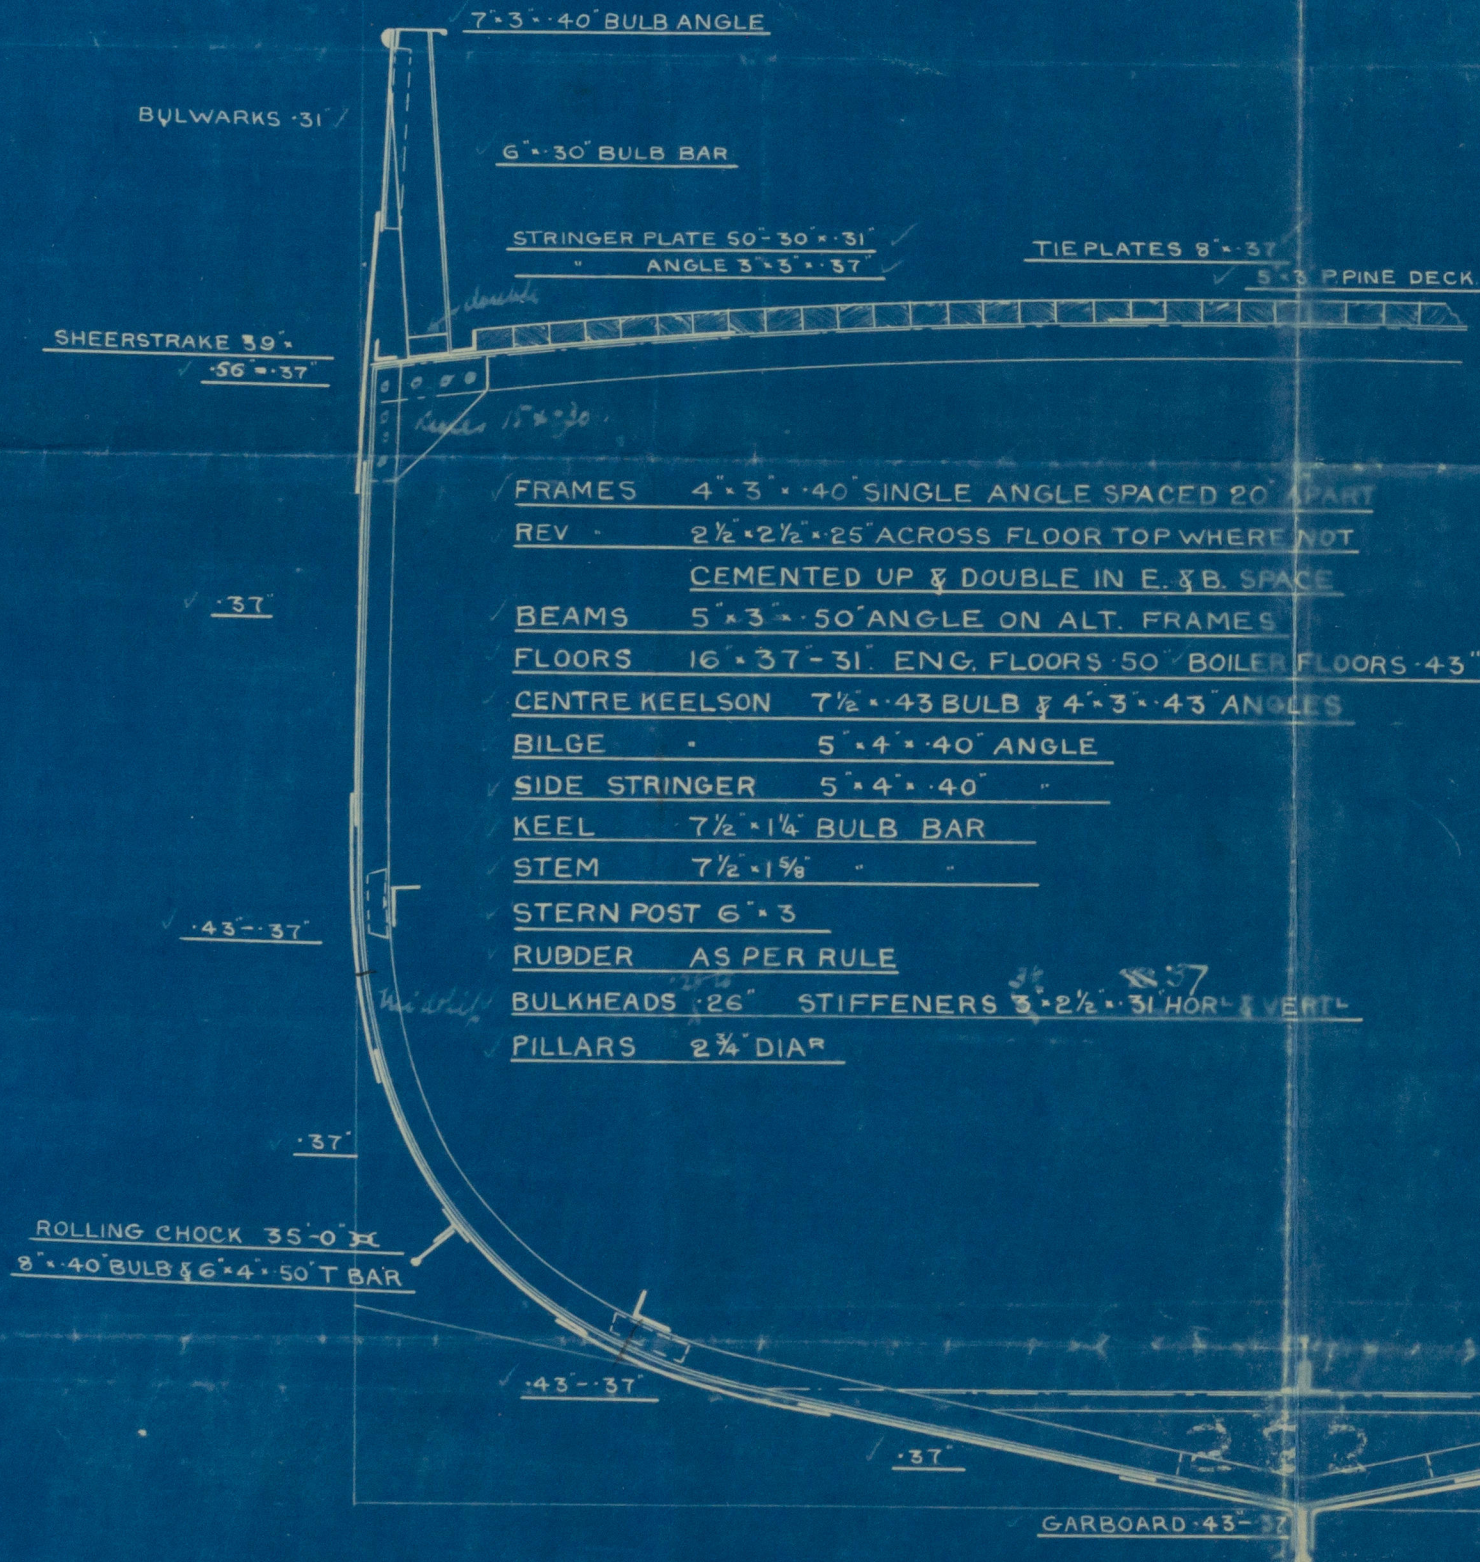

NUMERALS

B-D --- -34.85
L x (B-D) --- -4239.85

PROPORTIONS

L/D --- -9.35
B/D --- -5.56

EQUIPMENT

1 ST BOWER ANCHOR	5 1/4 CWTs EX STOCK
2 ND "	4 3/4 " " "
KEDGE	2 1/2 " " "
90 FATHOMS	1" CABLE
60	6" HAWSER
60	4 1/2" WARP

RIVETING

LANDINGS DOUBLE RIVETED BULWARKS SINGLE RIVETED
BUTTS TO BE LAPPED & DOUBLE RIVETED EXCEPT GARBOARD
& SHEERSTRAKE WHICH ARE TO BE STRAPPED & DOUBLE RIVETED


C.F.
20/6/13



Cochrane & Sons. Ltd
Nos 581. 582. 583. 584
Duplicate.
Midship Auction.

s/s Beryl
Hull R/L No. 27185



© 2020

Lloyd's Register
Foundation