



YARD N° 50. STERNFRAME. SCALE: 1:15.

MATERIAL: CAST STEEL.
BRITISH LLOYD'S TEST. CERTIFICATE TO BE DELIVERED.

Upper coupling
between sternframe & backpost
looking forward

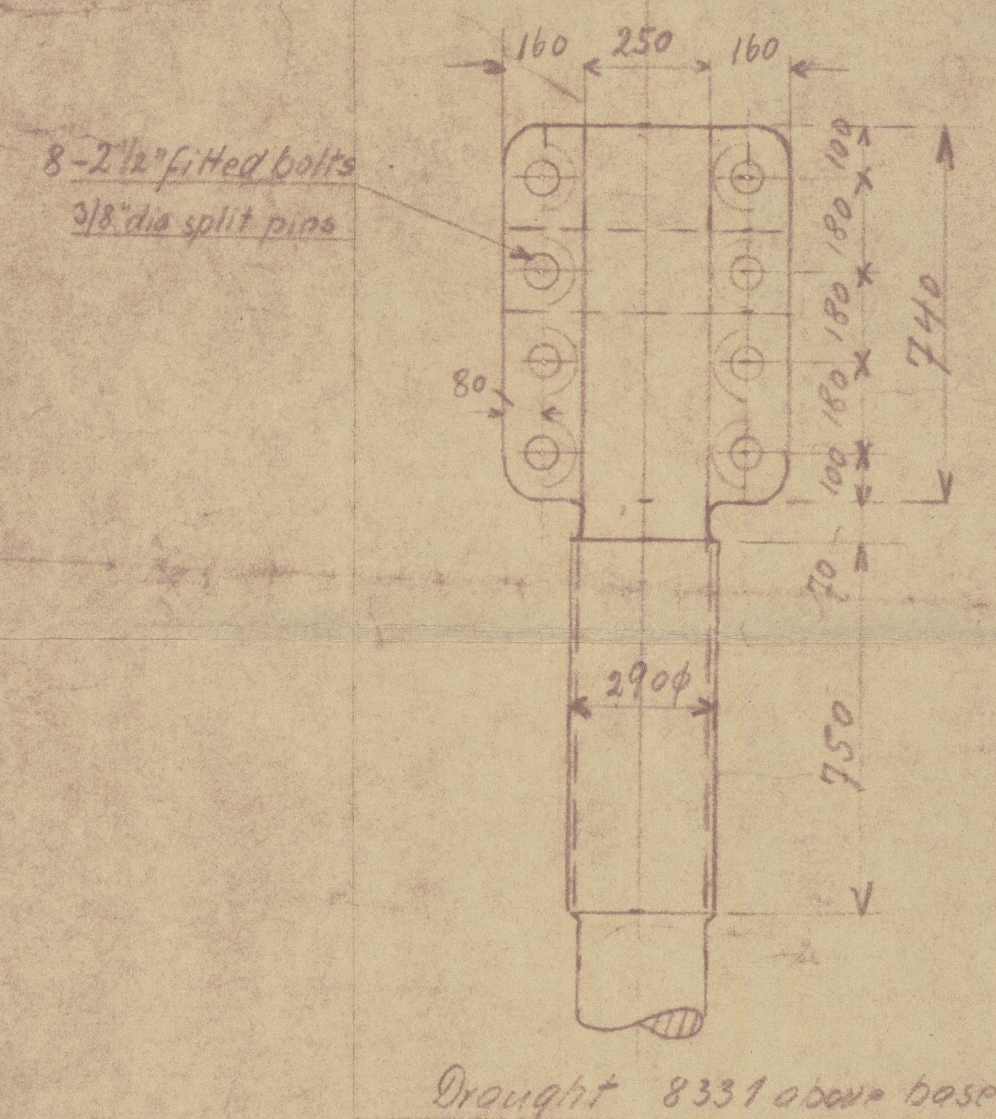

Beam is to be angled.
to suit to be connected with Rudder stem

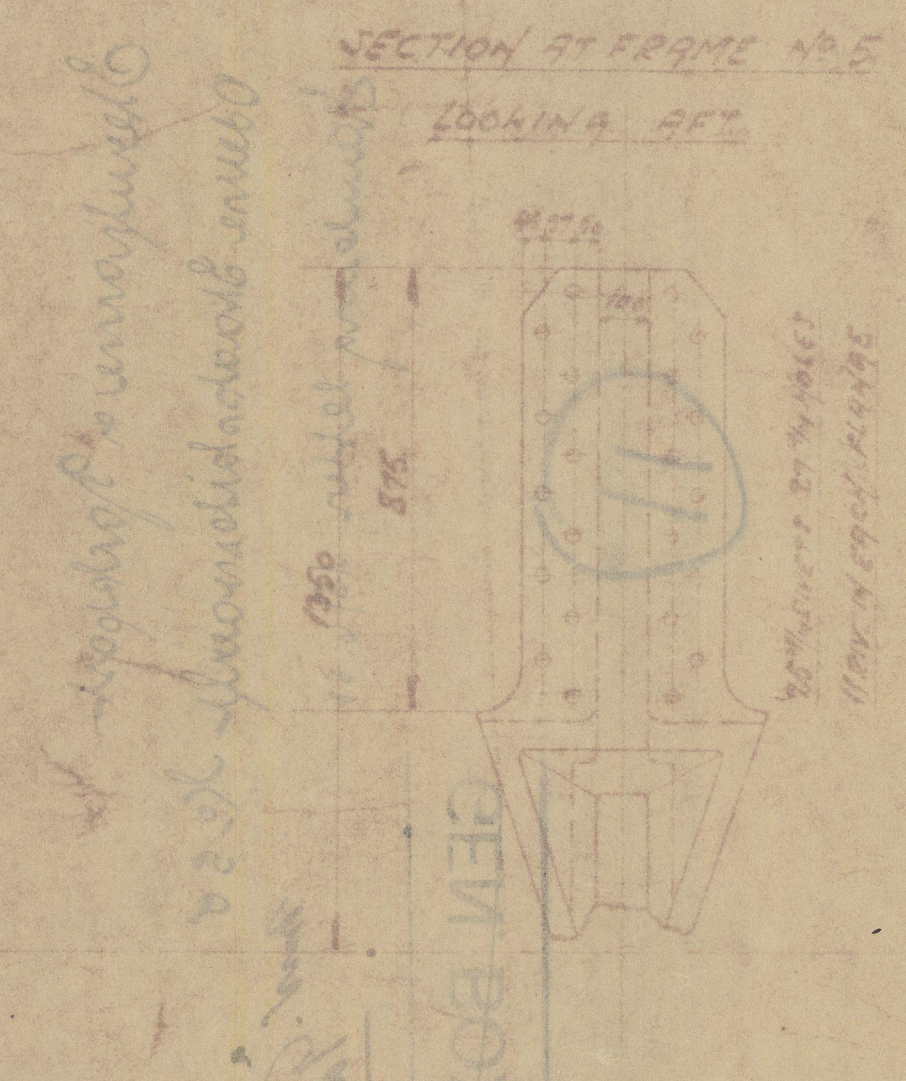

Sumerals:

Length	= 470'0" = 143,853 m
Breadth	= 61'0" = 18,592
Depth	= 42'11" = 13,080
Draught	= 27'4" = 8,331
Speed	= 16 Knots
Rudder area	= 180 sq ft = 16,72 m²
L x D	= 20771
A x D (100 x 4395)	= 254 276
Rudder-angle max.	= 35°

6500

Rudder by
special drawing!

Total length of backpost = 7815 mm

4930

Materials: With test of Lloyd's register of shipping.

Sternframe	= Cast-steel.
backpost	= Mild-Ingot steel
Rudderhead	= Forged-iron
Rudder	= Mild-steel
Rudder-bearings	= Cast-steel.

SW 1150	SW 1150
AN 4084	AN 4084
JAR 3233	JAR 3233

Sternframe and backpost

19. 6. 33

Steufhane & Packpost

Odense Staatskibsværft No. 58

Hamburg letter 15/6.33

Mr. Taronga

72

GEN. BOX NO ~~1215~~

11



© 2020

Lloyd's Register
Foundation

003217-003222-0120