


*Offen*

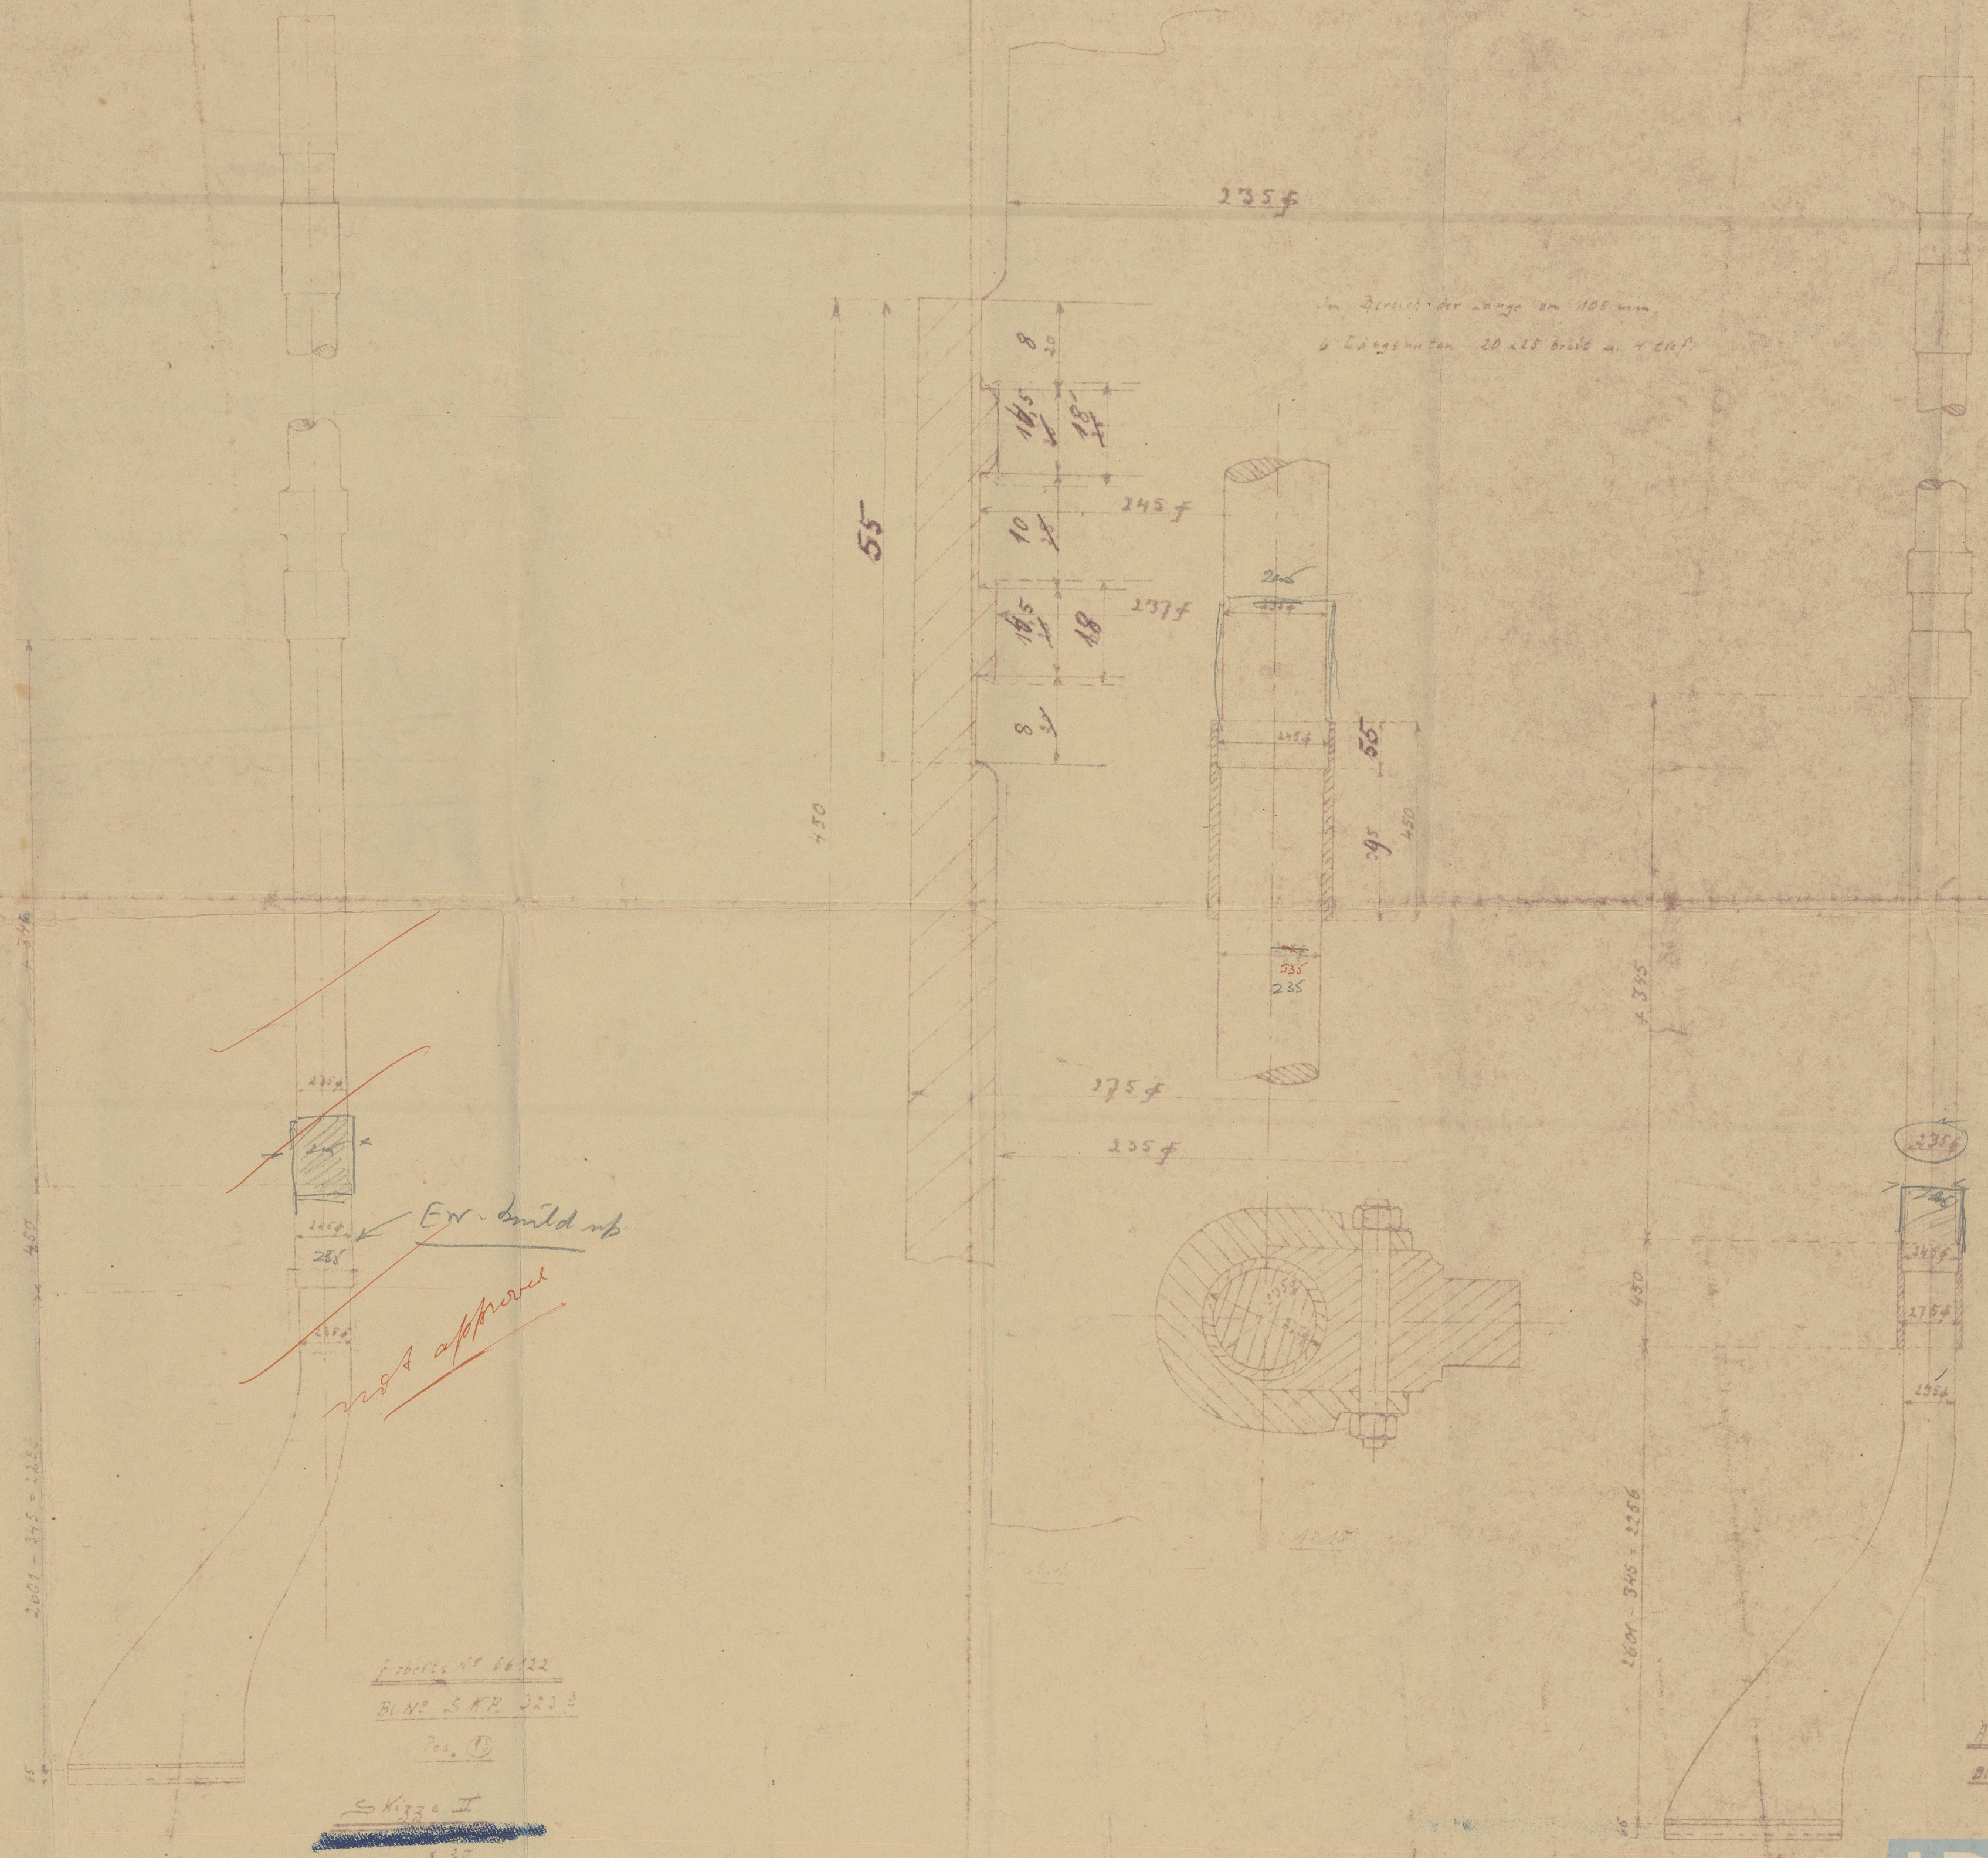

Arbeits Nr. 66122  
BLN SKR 3233  
Pos. ①

Skizze II  
1:20

*approved*

*W.J.*  
14.8.33.  
Arbeits Nr. 66122  
BLN SKR 3233  
Pos. ① n. ①B



(20)

GEN. BOX NO 72

ODENSE YARD  
01050

Alteration to  
Rudder Stock




© 2020

Lloyd's Register  
Foundation

003217-003222-0124