

R.O.D. COASTER "THE COUNTESS."

LONGITUDINAL SECTION AND DECK PLANS.

SCALE $\frac{1}{8}" = 1 \text{ FOOT.}$

TO CLASS 100 A.I. + LLOYDS.

DIMENSIONS - 195'-0" x 30'-3" x 14'-2" TO UPPER Dk. 18'-2" TO QUARTER Dk.

NUMERALS

D = 14-17 TO UPPER DECK.

D = 18-17 " QUARTER DECK.

1ST LONGITUDINAL = L.D. = 195 x 14-17 = 2763-15


2ND " = L(B.D.) = 195 x (30-25 x 14-17) = 2661-9

PROPORTIONS $\frac{L}{D} = \frac{195}{14-17} = 1316$ TO UPPER DECK

$\frac{195}{18-17} = 1073$ " QUARTER DECK

FRAMING DEPTH "d" = 11-66 UPPER DECK 15-66 QUARTER DECK

17-36 BOILER ROOM. 14-16 ENGINE ROOM.

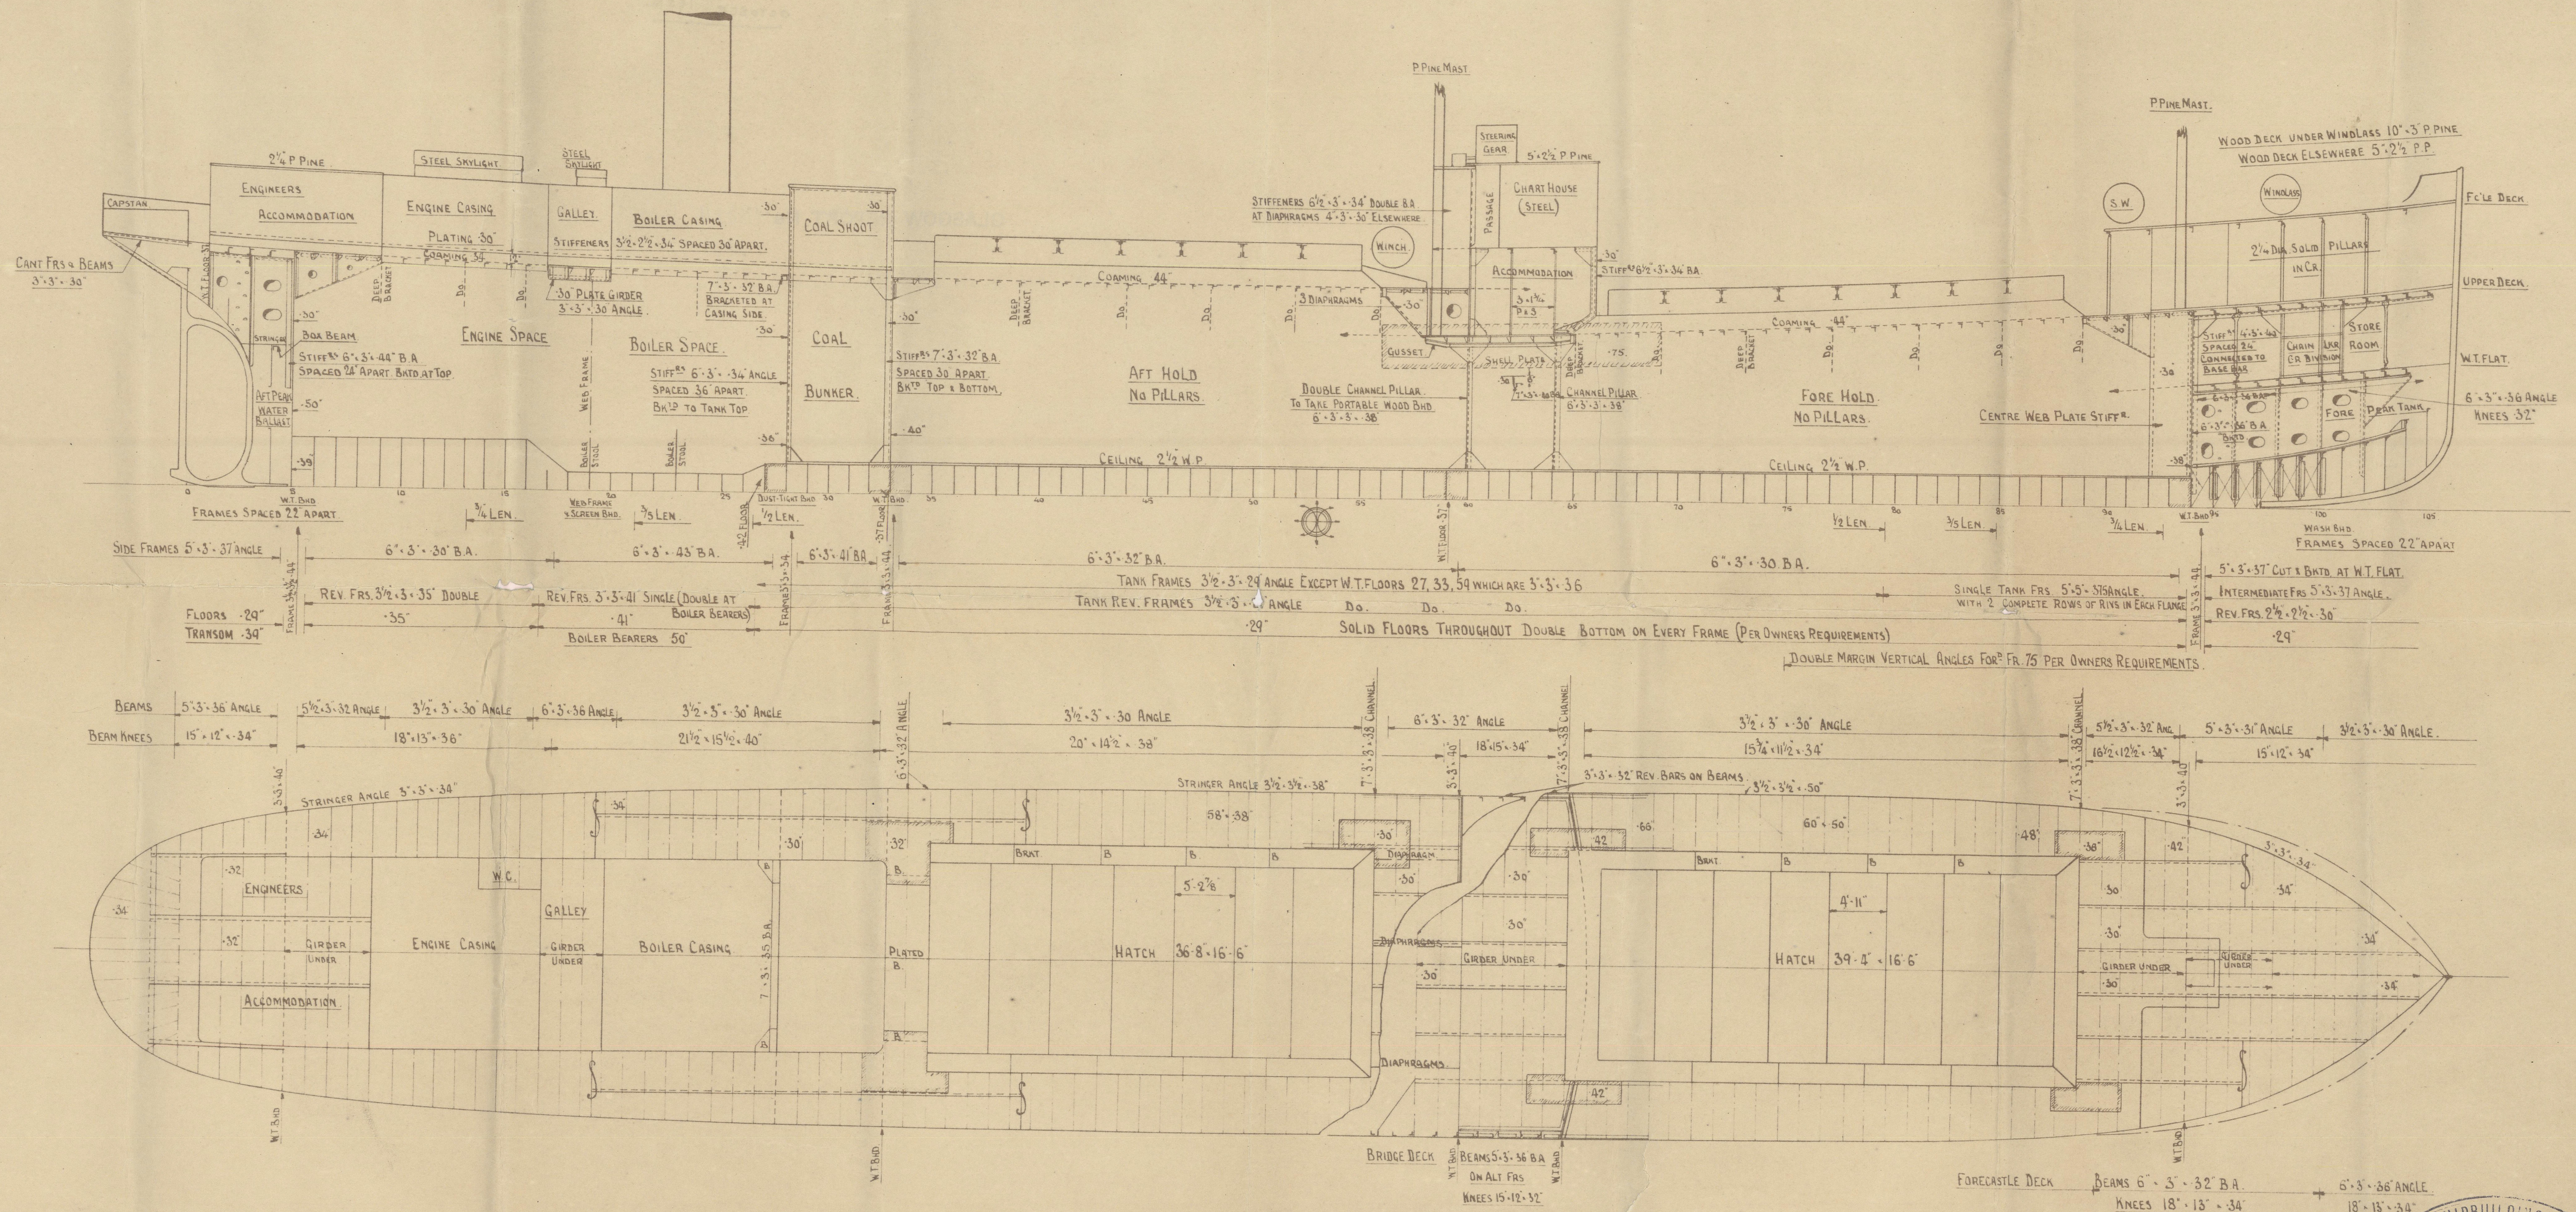

S/S "THE COUNTESS"

PROFILE AND DECK PLANS (AS BUILT).

OCTOBER 1928.

GLASGOW REPORT No. 48510



© 2020

Lloyd's Register
Foundation

003223-002 232-0079