
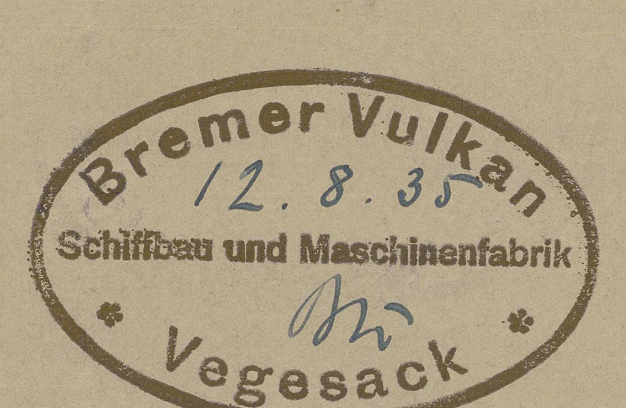


# Southern Star

General Arrangement Plan  
Particulars taken at ship by Bremer Vulkan Company  
Aug. 1935

14 AUG 1935

1" = 1/4"

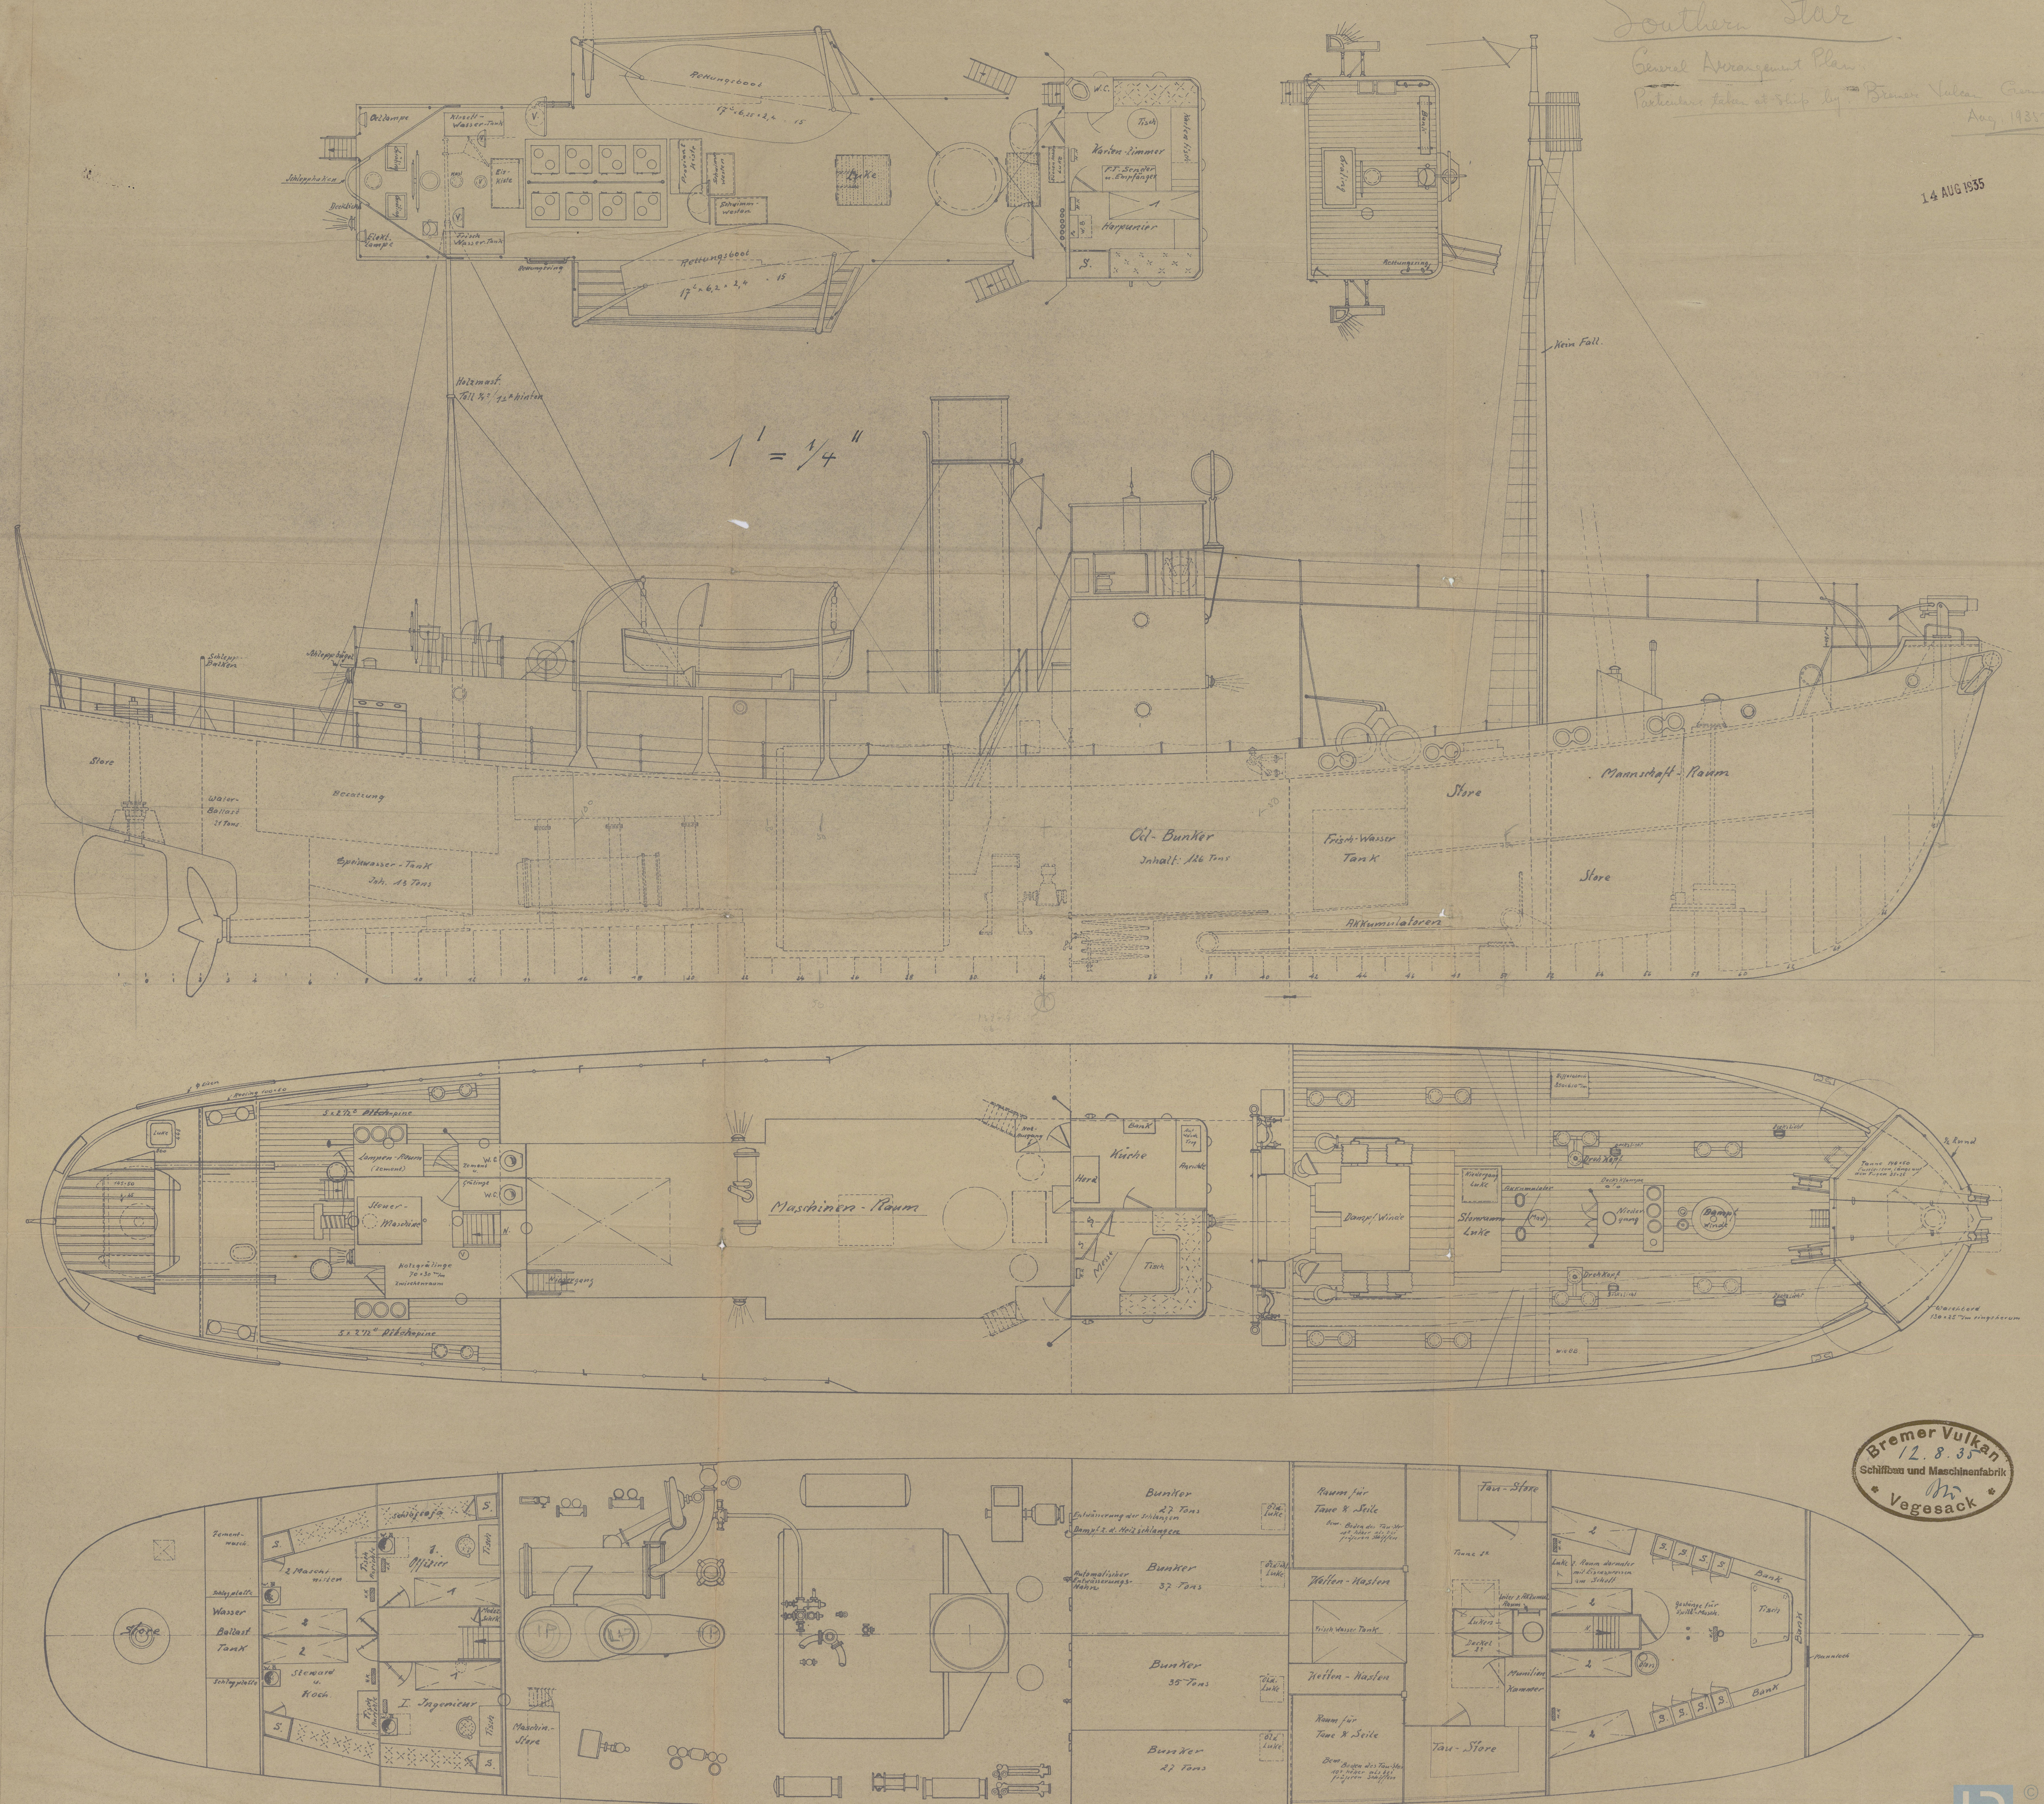



8/8 Southern Star

Gen Asst. Deck

Box

003233-003239-0047



© 2020

Lloyd's Register  
Foundation



General Arost.

Gremer Vulcan. Alt.

$\frac{5}{5}$  "SOUTHERN STAR"

18<sup>TH</sup> Aug. 1935.

Ref. N<sup>o</sup> 723 etc. "SOUTHERN MAID" etc.

$\frac{8}{8}$  UNI II



© 2020

Lloyd's Register  
Foundation

003233-003239-0047