

# 1ST PROPOSAL


GOOLE SHIPBUILDING & REPAIRING COY

EMPIRE FACET


SKETCH SHEWING SUGGESTED STRUCTURAL ARRANGEMENTS  
RELATIVE TO PROPOSED REMOVAL OF SIDE LONG BHDS.




16-5-46

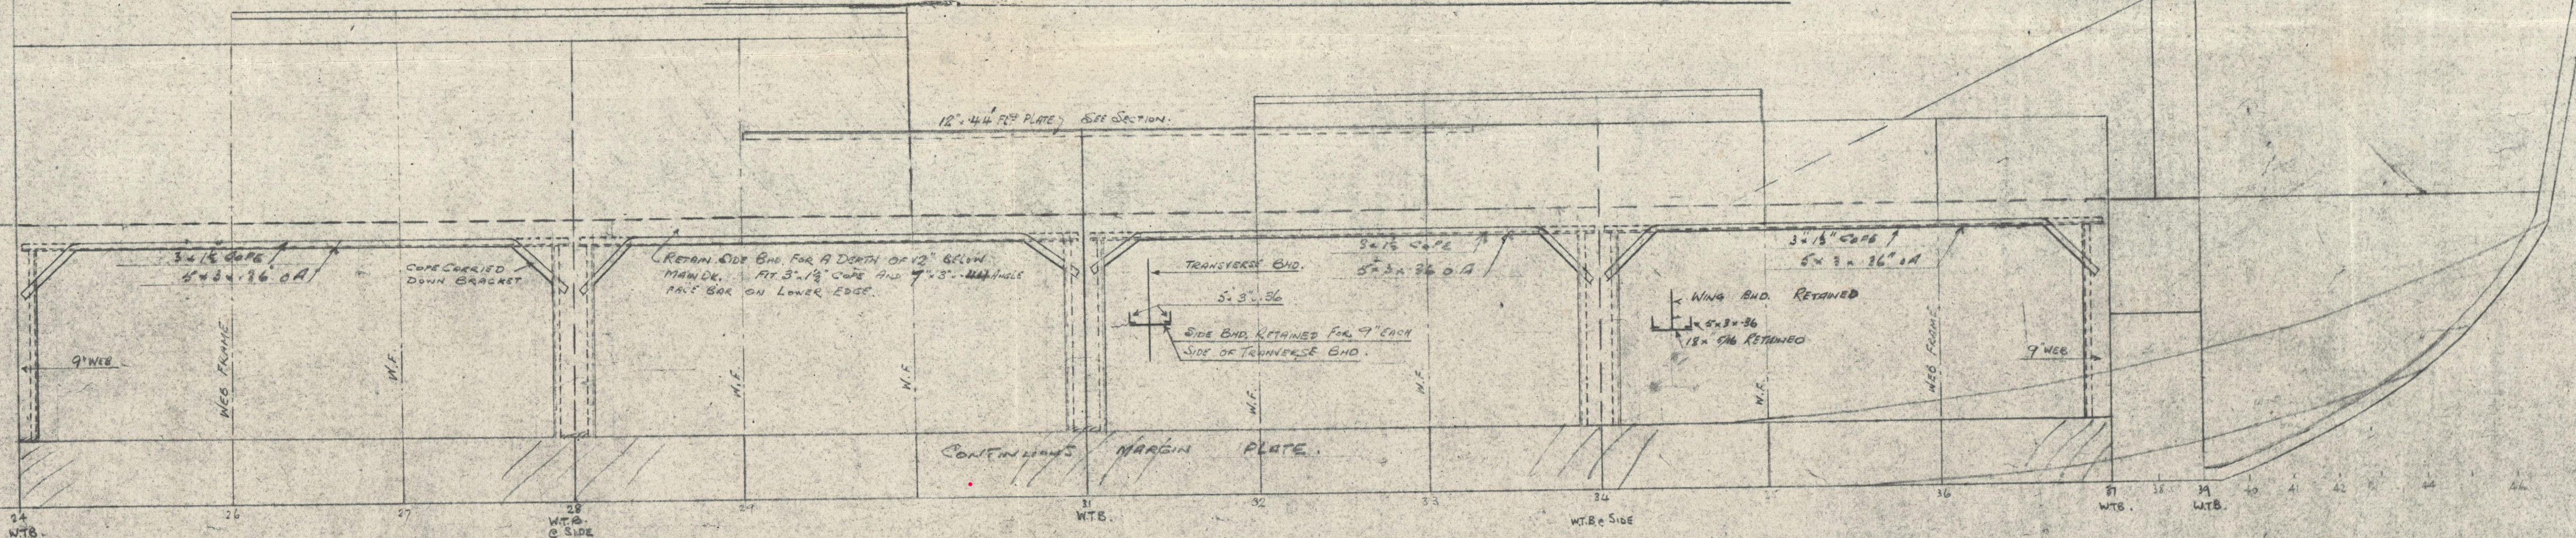

ELEVATION SHEWING EXTENT OF BHDS REMOVED AND  
PROVISIONS MADE FOR DECK SUPPORT AND STRENGTH

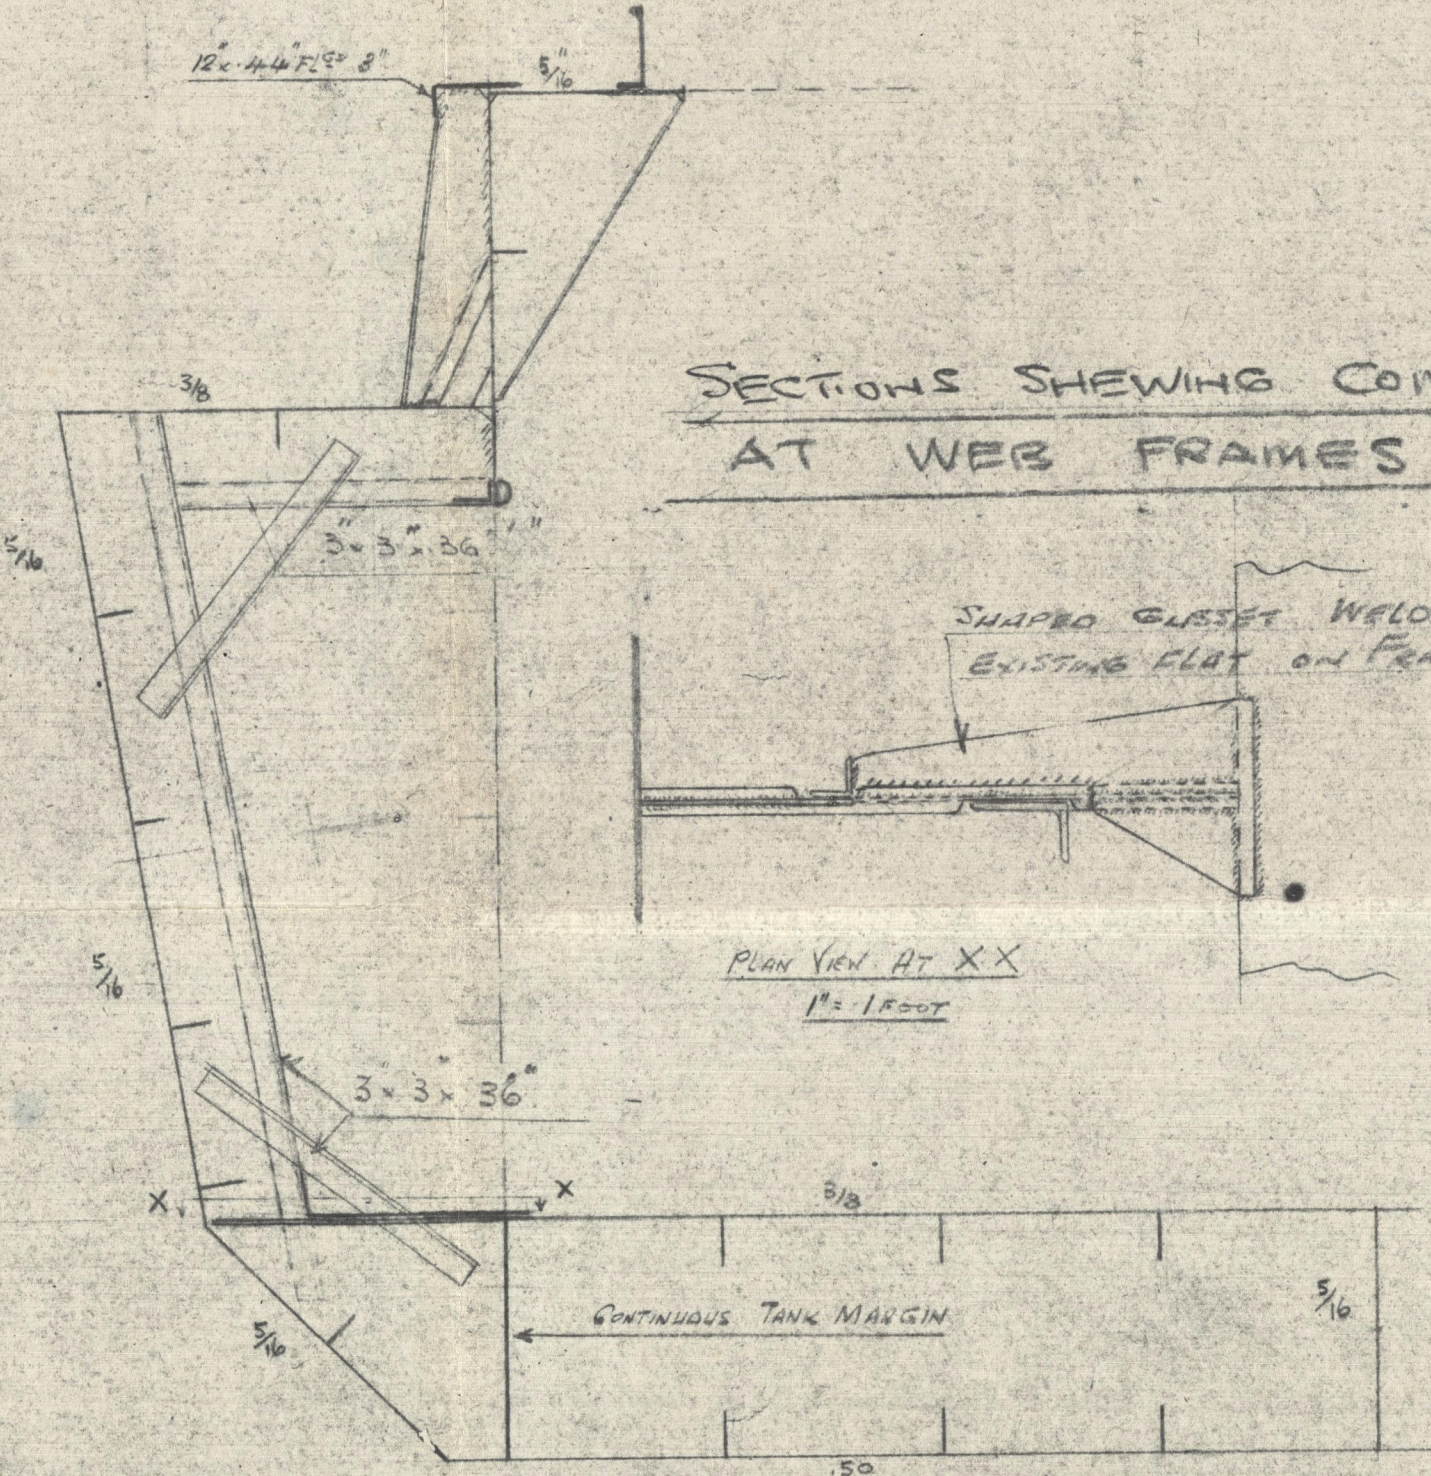

TYPICAL SECTION AT FRAME 33

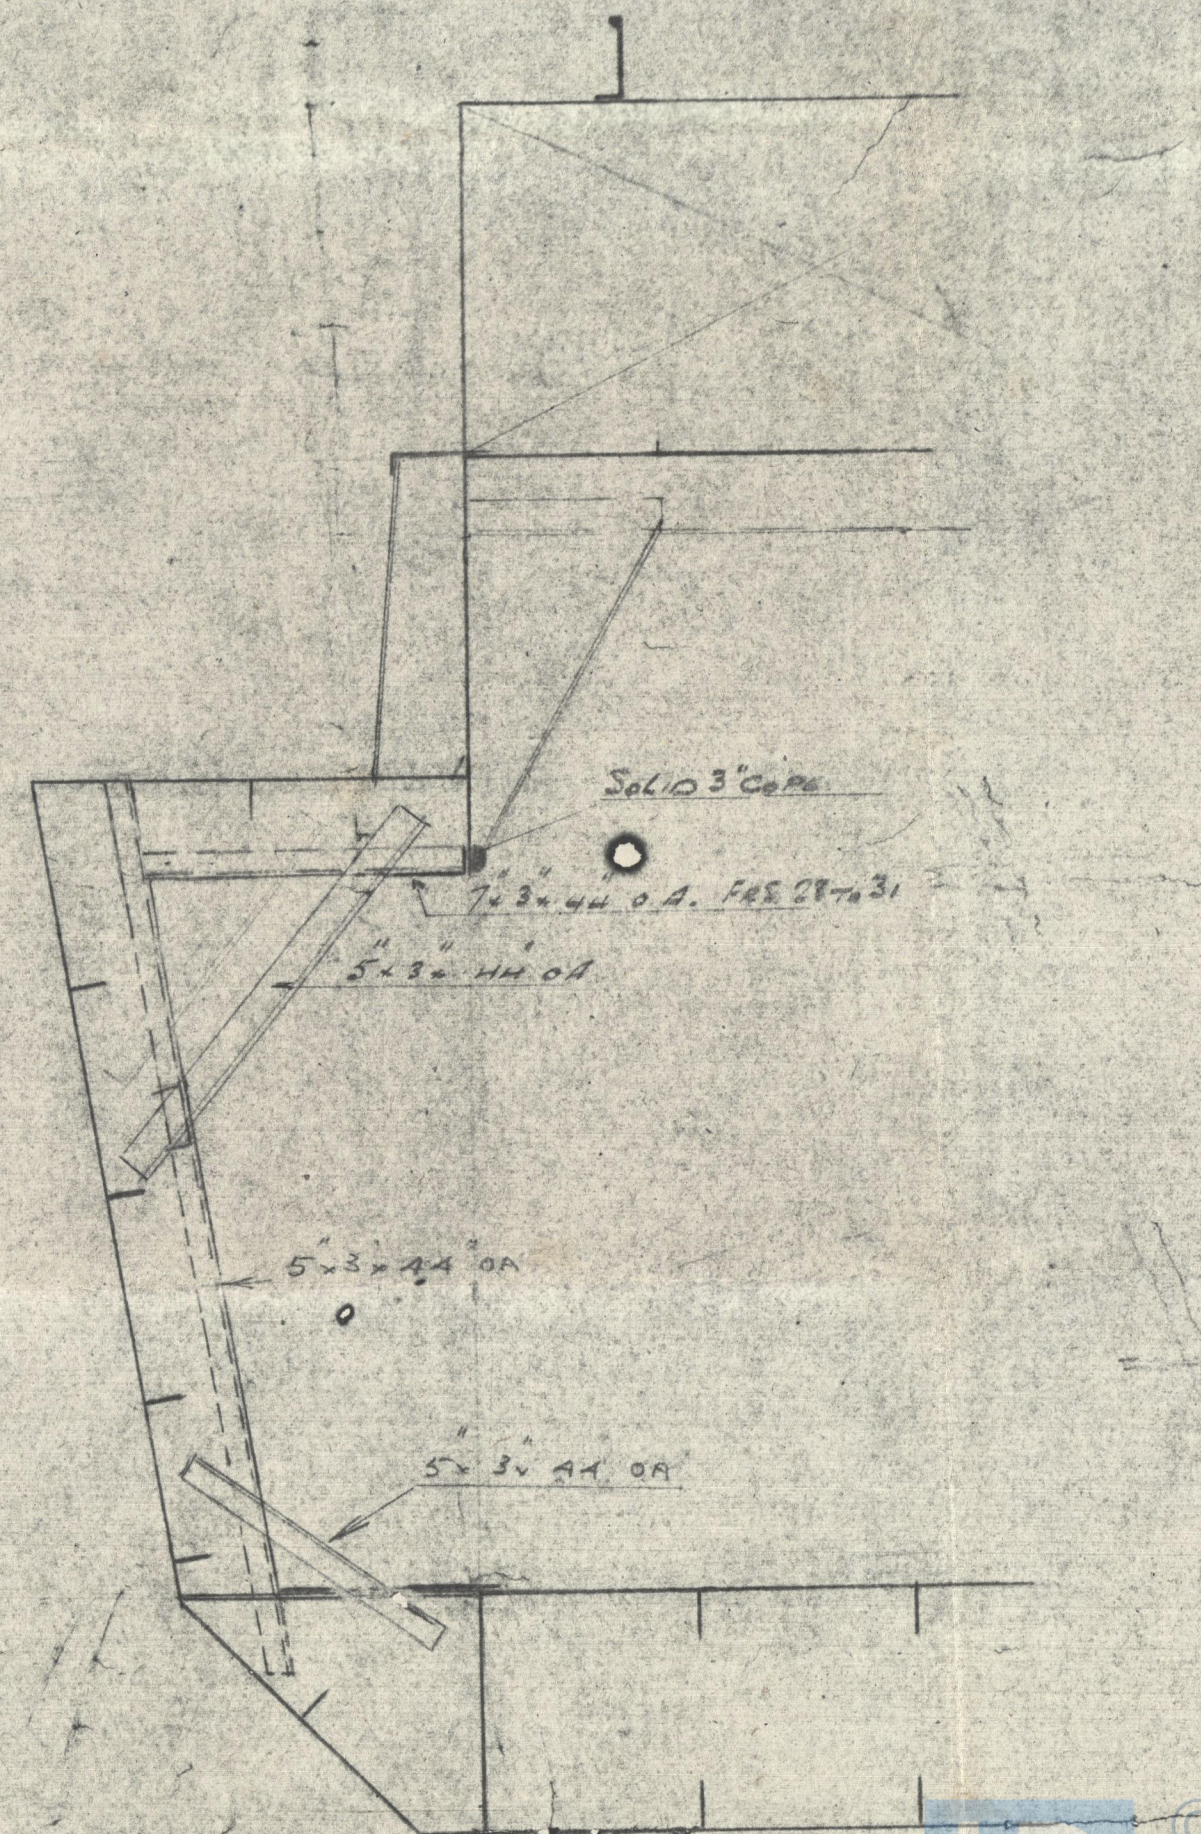

SECTION AT 30 FRAME (ONLY)



2.

164

13/6. Alterations for removal of Side Senght. 13hds  
HULL GATE

EX.

S/m EMPIRE FACET.

Goole 13/6. 11/5 11/6.

Traing und



© 2020

Lloyd's Register  
Foundation

003245-003251-0199