

30.12.11

TRACING N° 582

SINGLE SCREW STEEL TUG



LENGTH B.P. 60 FT 0 IN

BEAM MOULDED 15 FT 6 IN

DEPTH AT SIDE 8 FT 0 IN


CONTRACT N° 420

SCALE 3/8 INCH = 1 FOOT

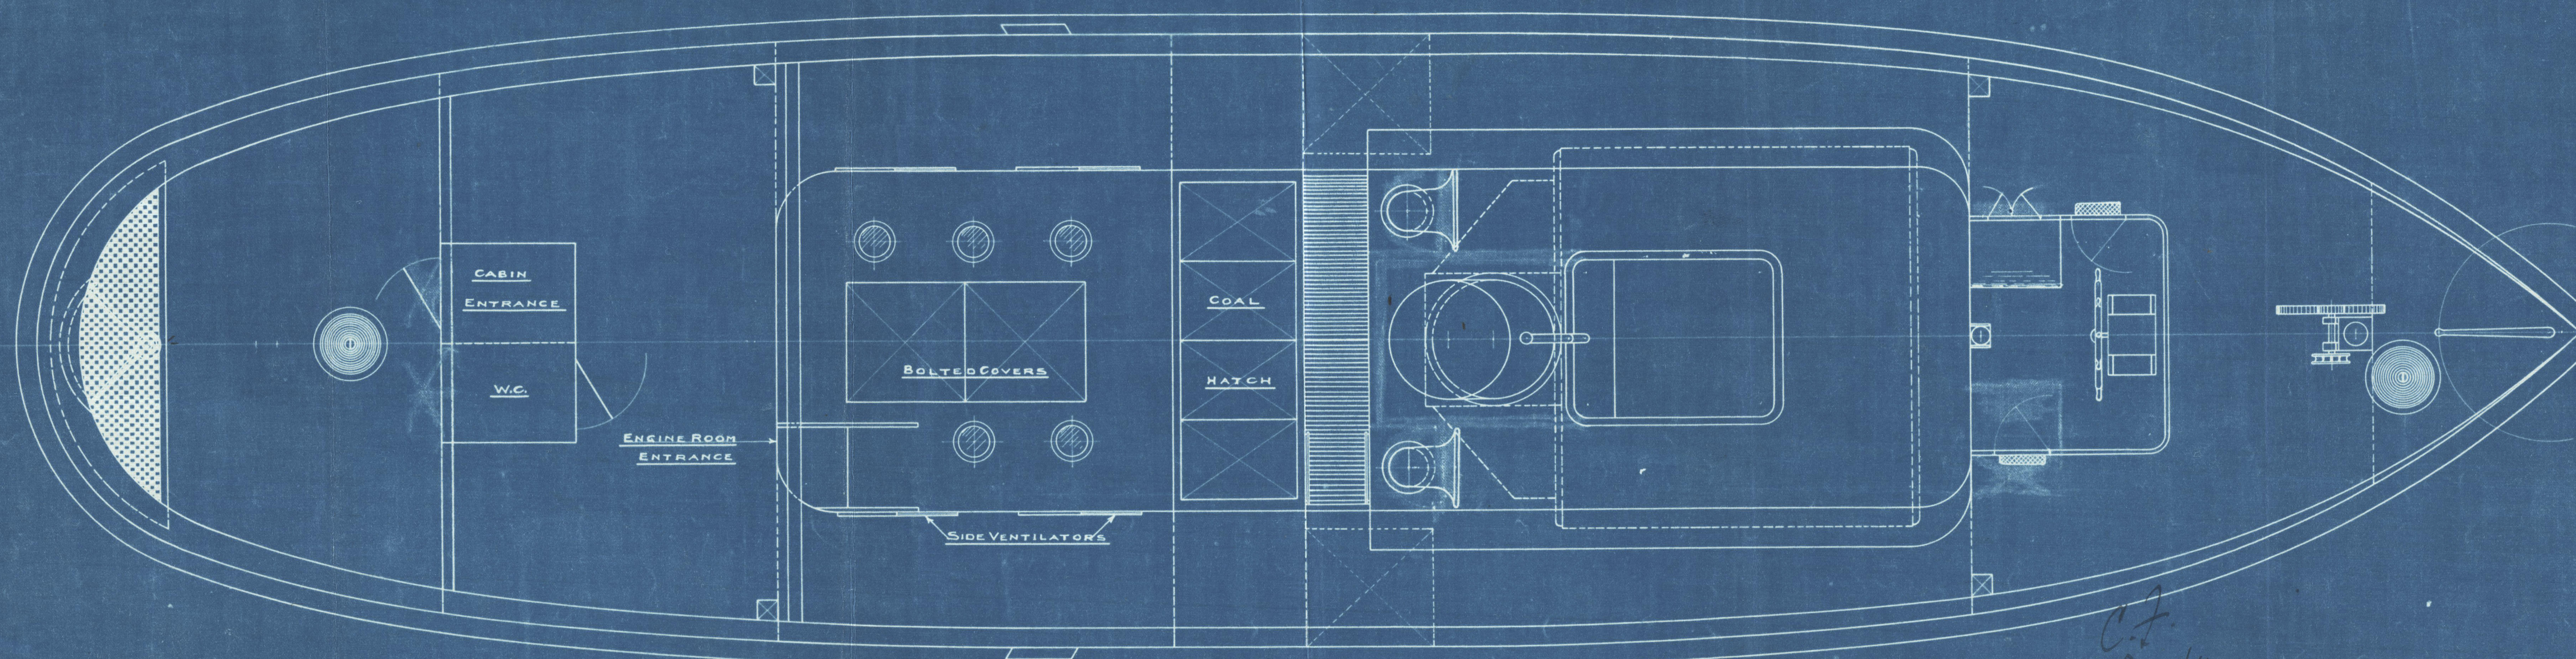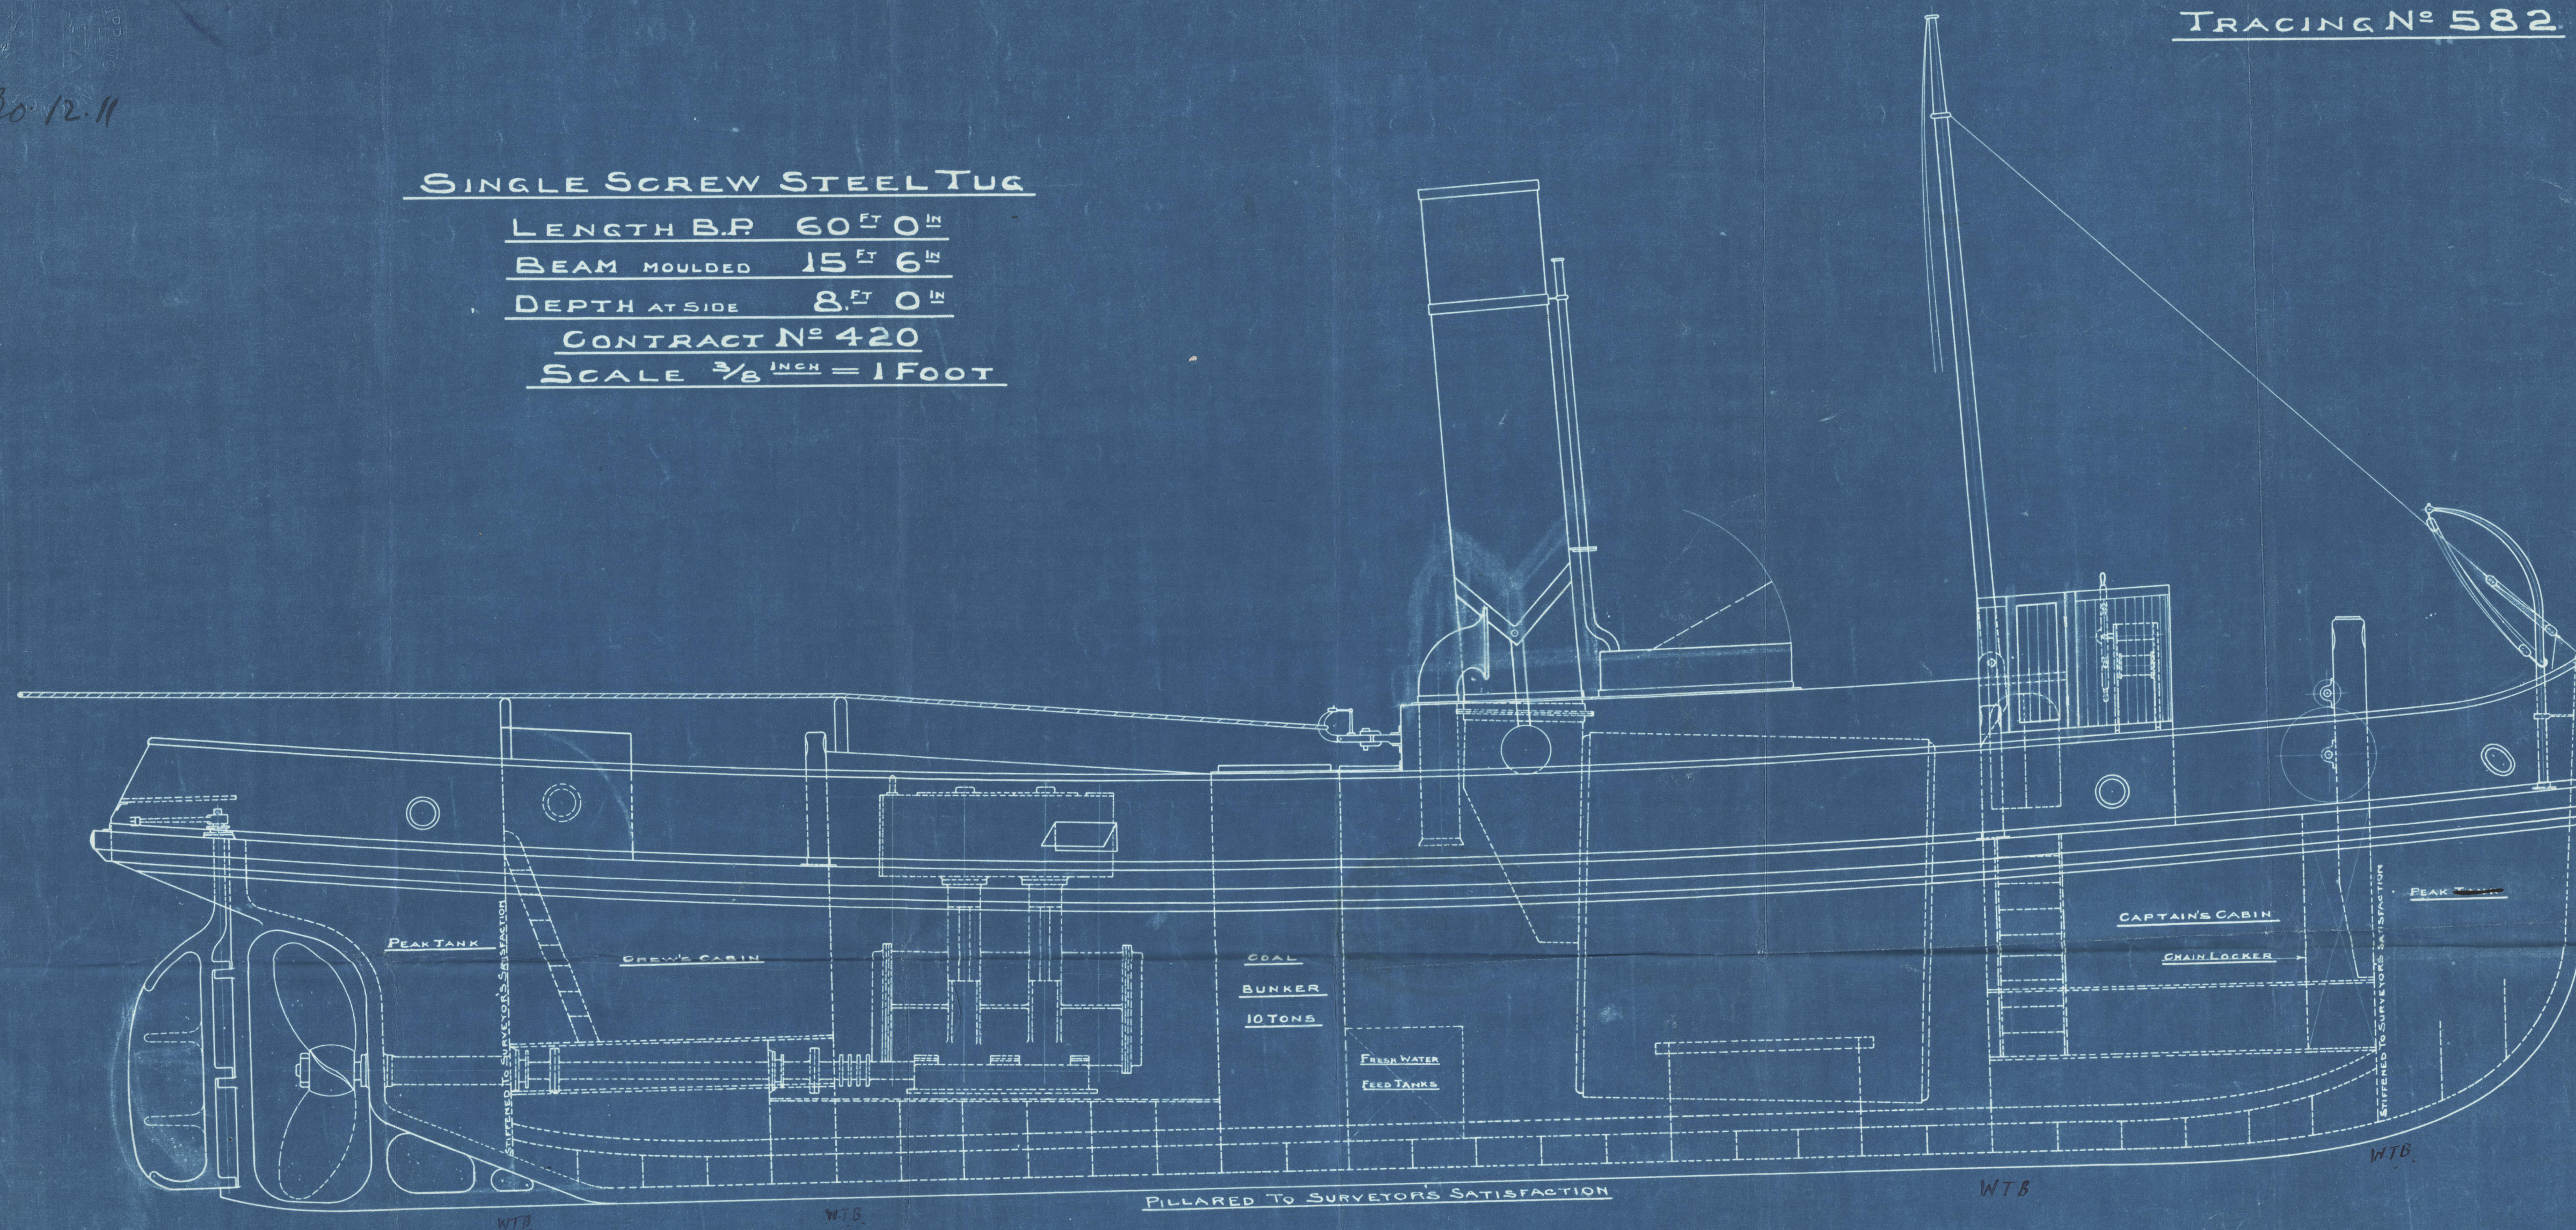

C.F.  
30/12/11

APPROVED BY LLOYD'S 17/3/10

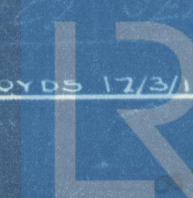

Lloyd's Register  
Foundation





003263-003274-0067




© 2010  
Lloyd's  
Foundation




S. L. Mls-garth.  
Leytham Ct & Co.  
454

Profile + deck plan

Liverpool report. 68/44

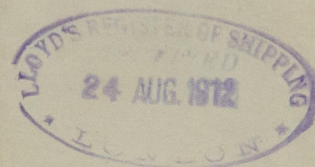

4257

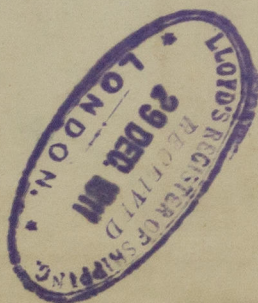

© 2020

Lloyd's Register  
Foundation

003263-003274-0067