


## OF

TO CLASS AT LLOYDS & 100 A1 FOR TOWING PURPOSES

SCALE 1  $\frac{\text{INCH}}{\text{FOOT}}$  = 1 FOOT

# LLOYDS NUMERALS

1/2 BEAM	7.9
1/2 GIRTH	14.4
DEPTH	8.35
FRAMING N <sup>o</sup>	30.65
PLATING N <sup>o</sup>	1839
BREADTHS TO LENGTH	3.8
DEPTHS TO LENGTH	7.5

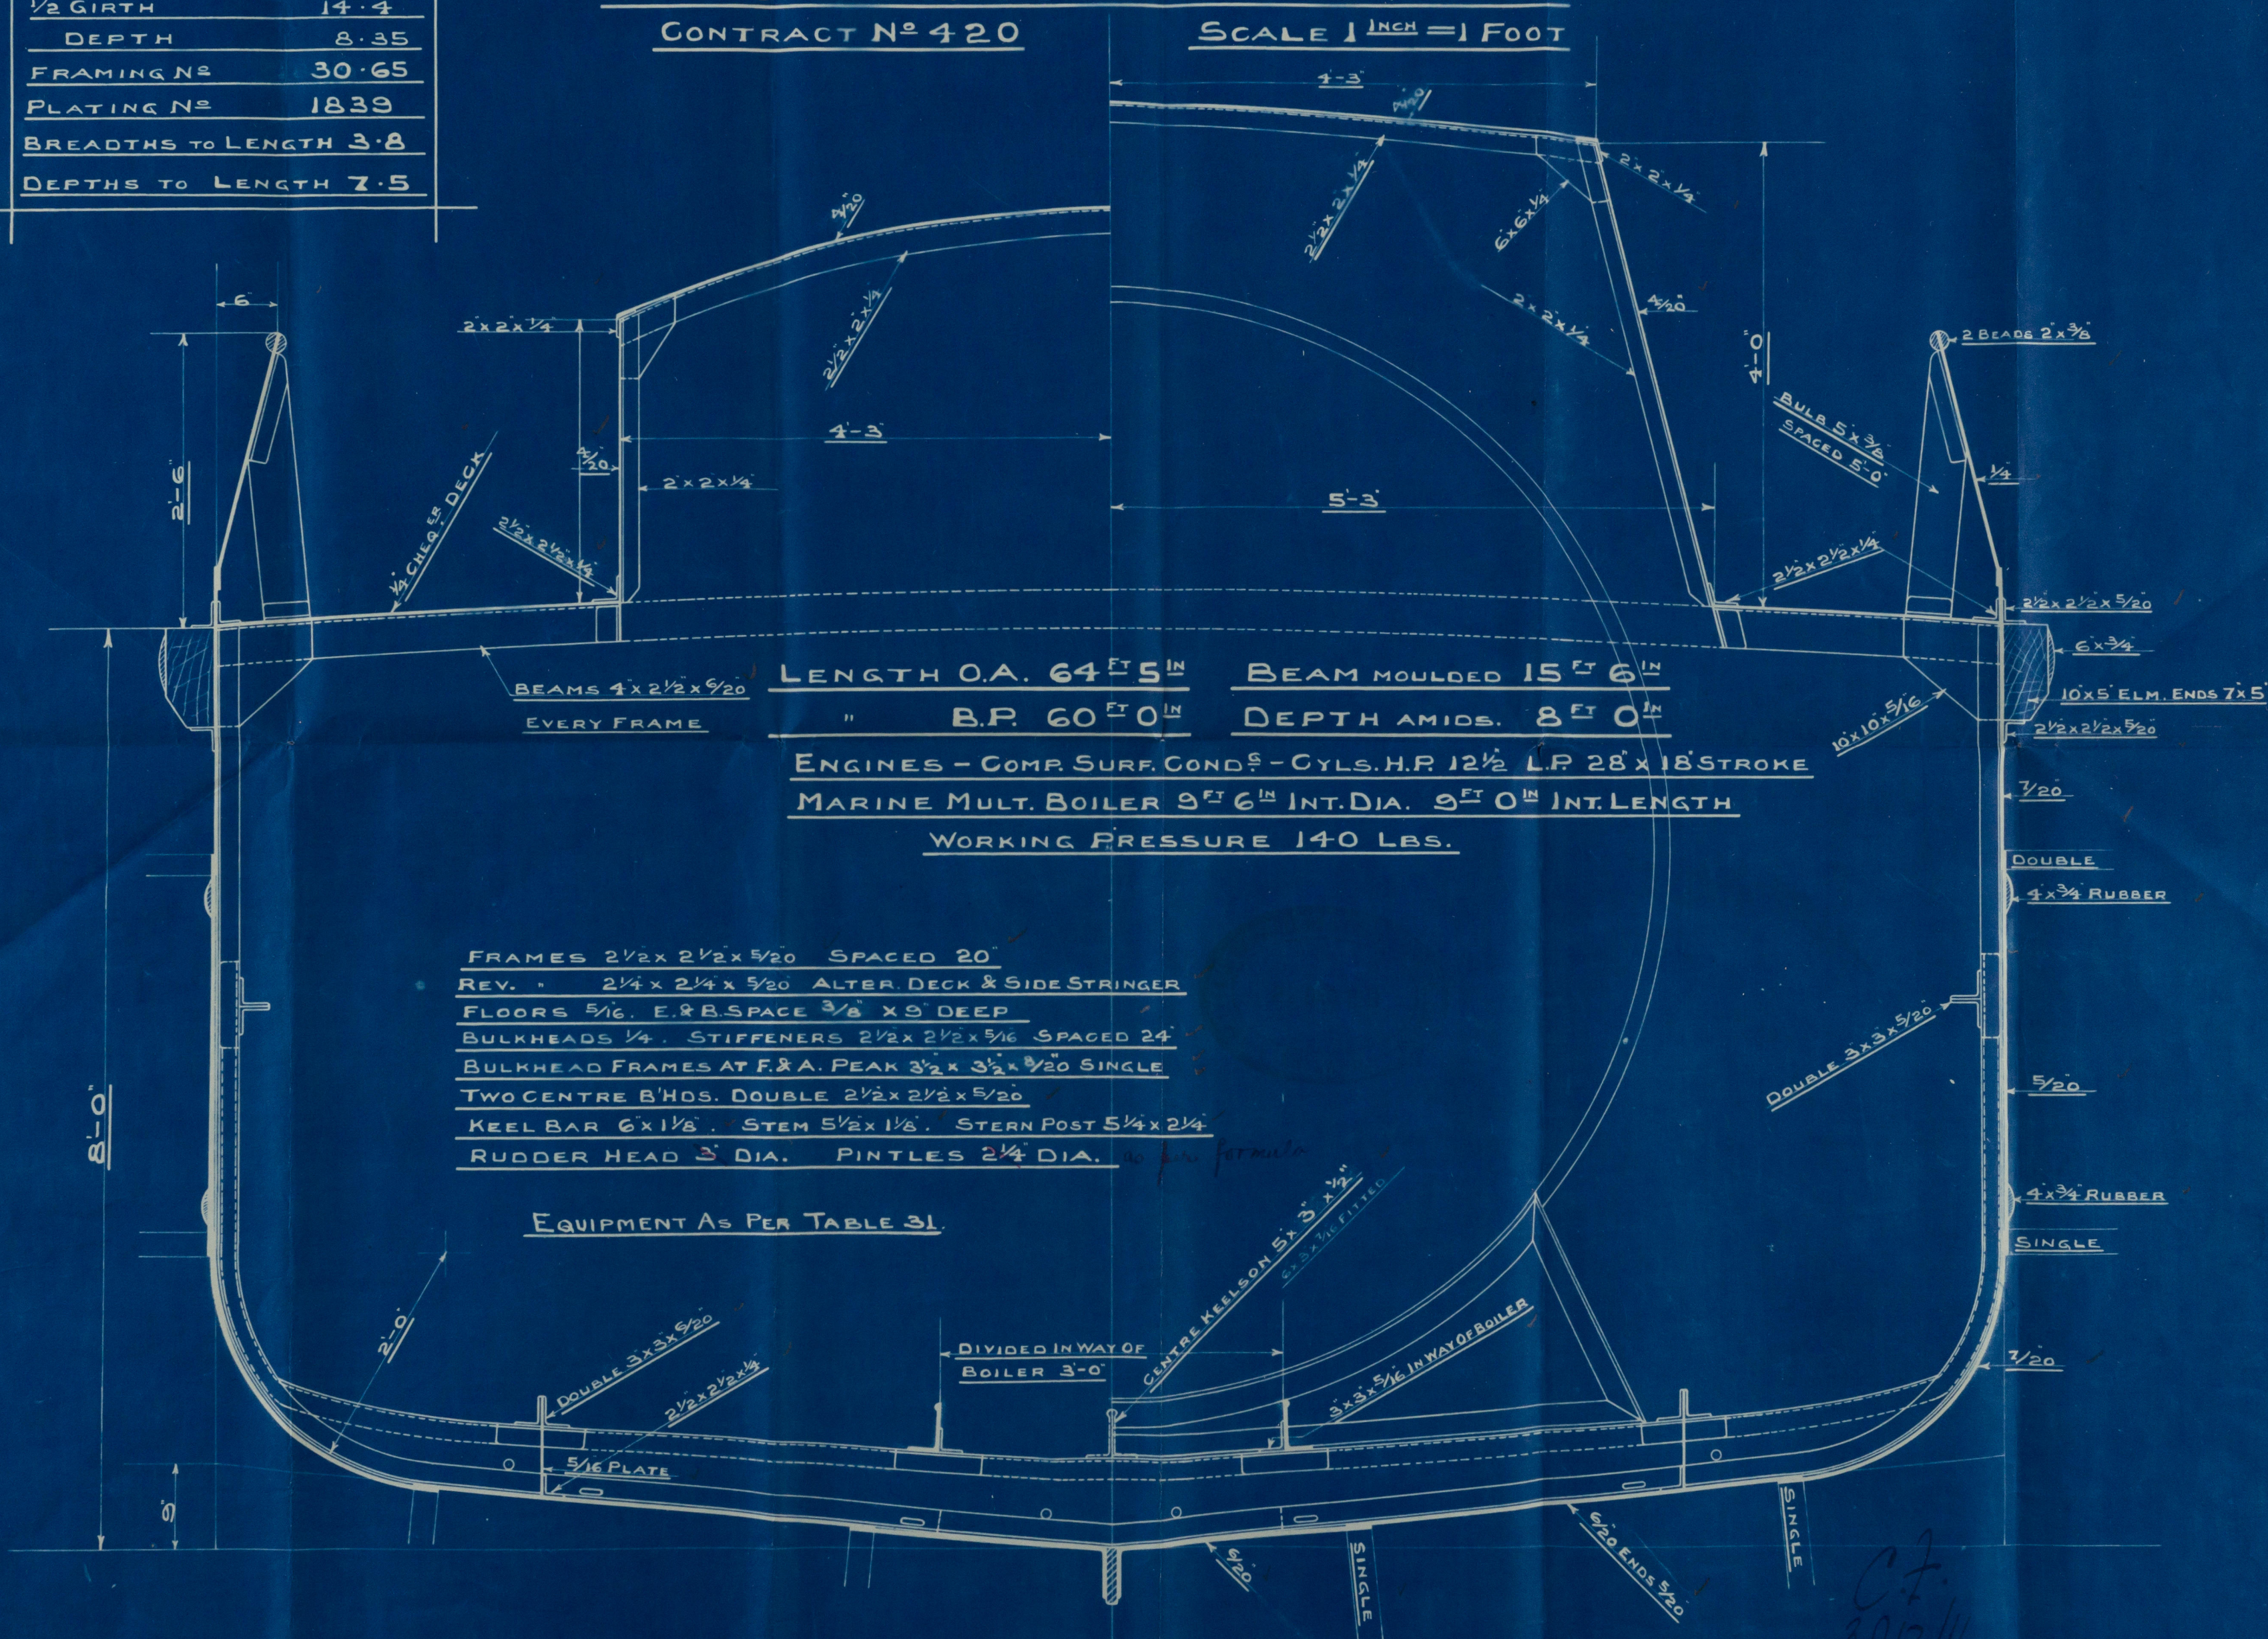

APPROVED BY LLOYDS 12/3/10



454

L. L. Murgantb  
Lytham & Co.  
454

Midship section


See report No.

LOYD'S REGISTER OF SHIPPING  
24 AUG. 1912  
LONDON

THE LLOYD'S BUILDING & ENGINEERING CO. LTD.  
22 DEC. 1911  
LONDON

003263-003274-0068

003263-003274-0068

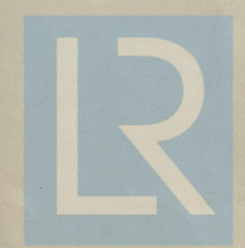

© 2020

Lloyd's Register  
Foundation