


# 5/5 "KIRUNA"

TRAFIKAKTIEBOLAGET GRÄNGBERG-OXELÖSUND  
STOCKHOLM.

## PUMPING ARRANGEMENT, AIR- AND SOUNDING PIPES.

SCALE = 1/100

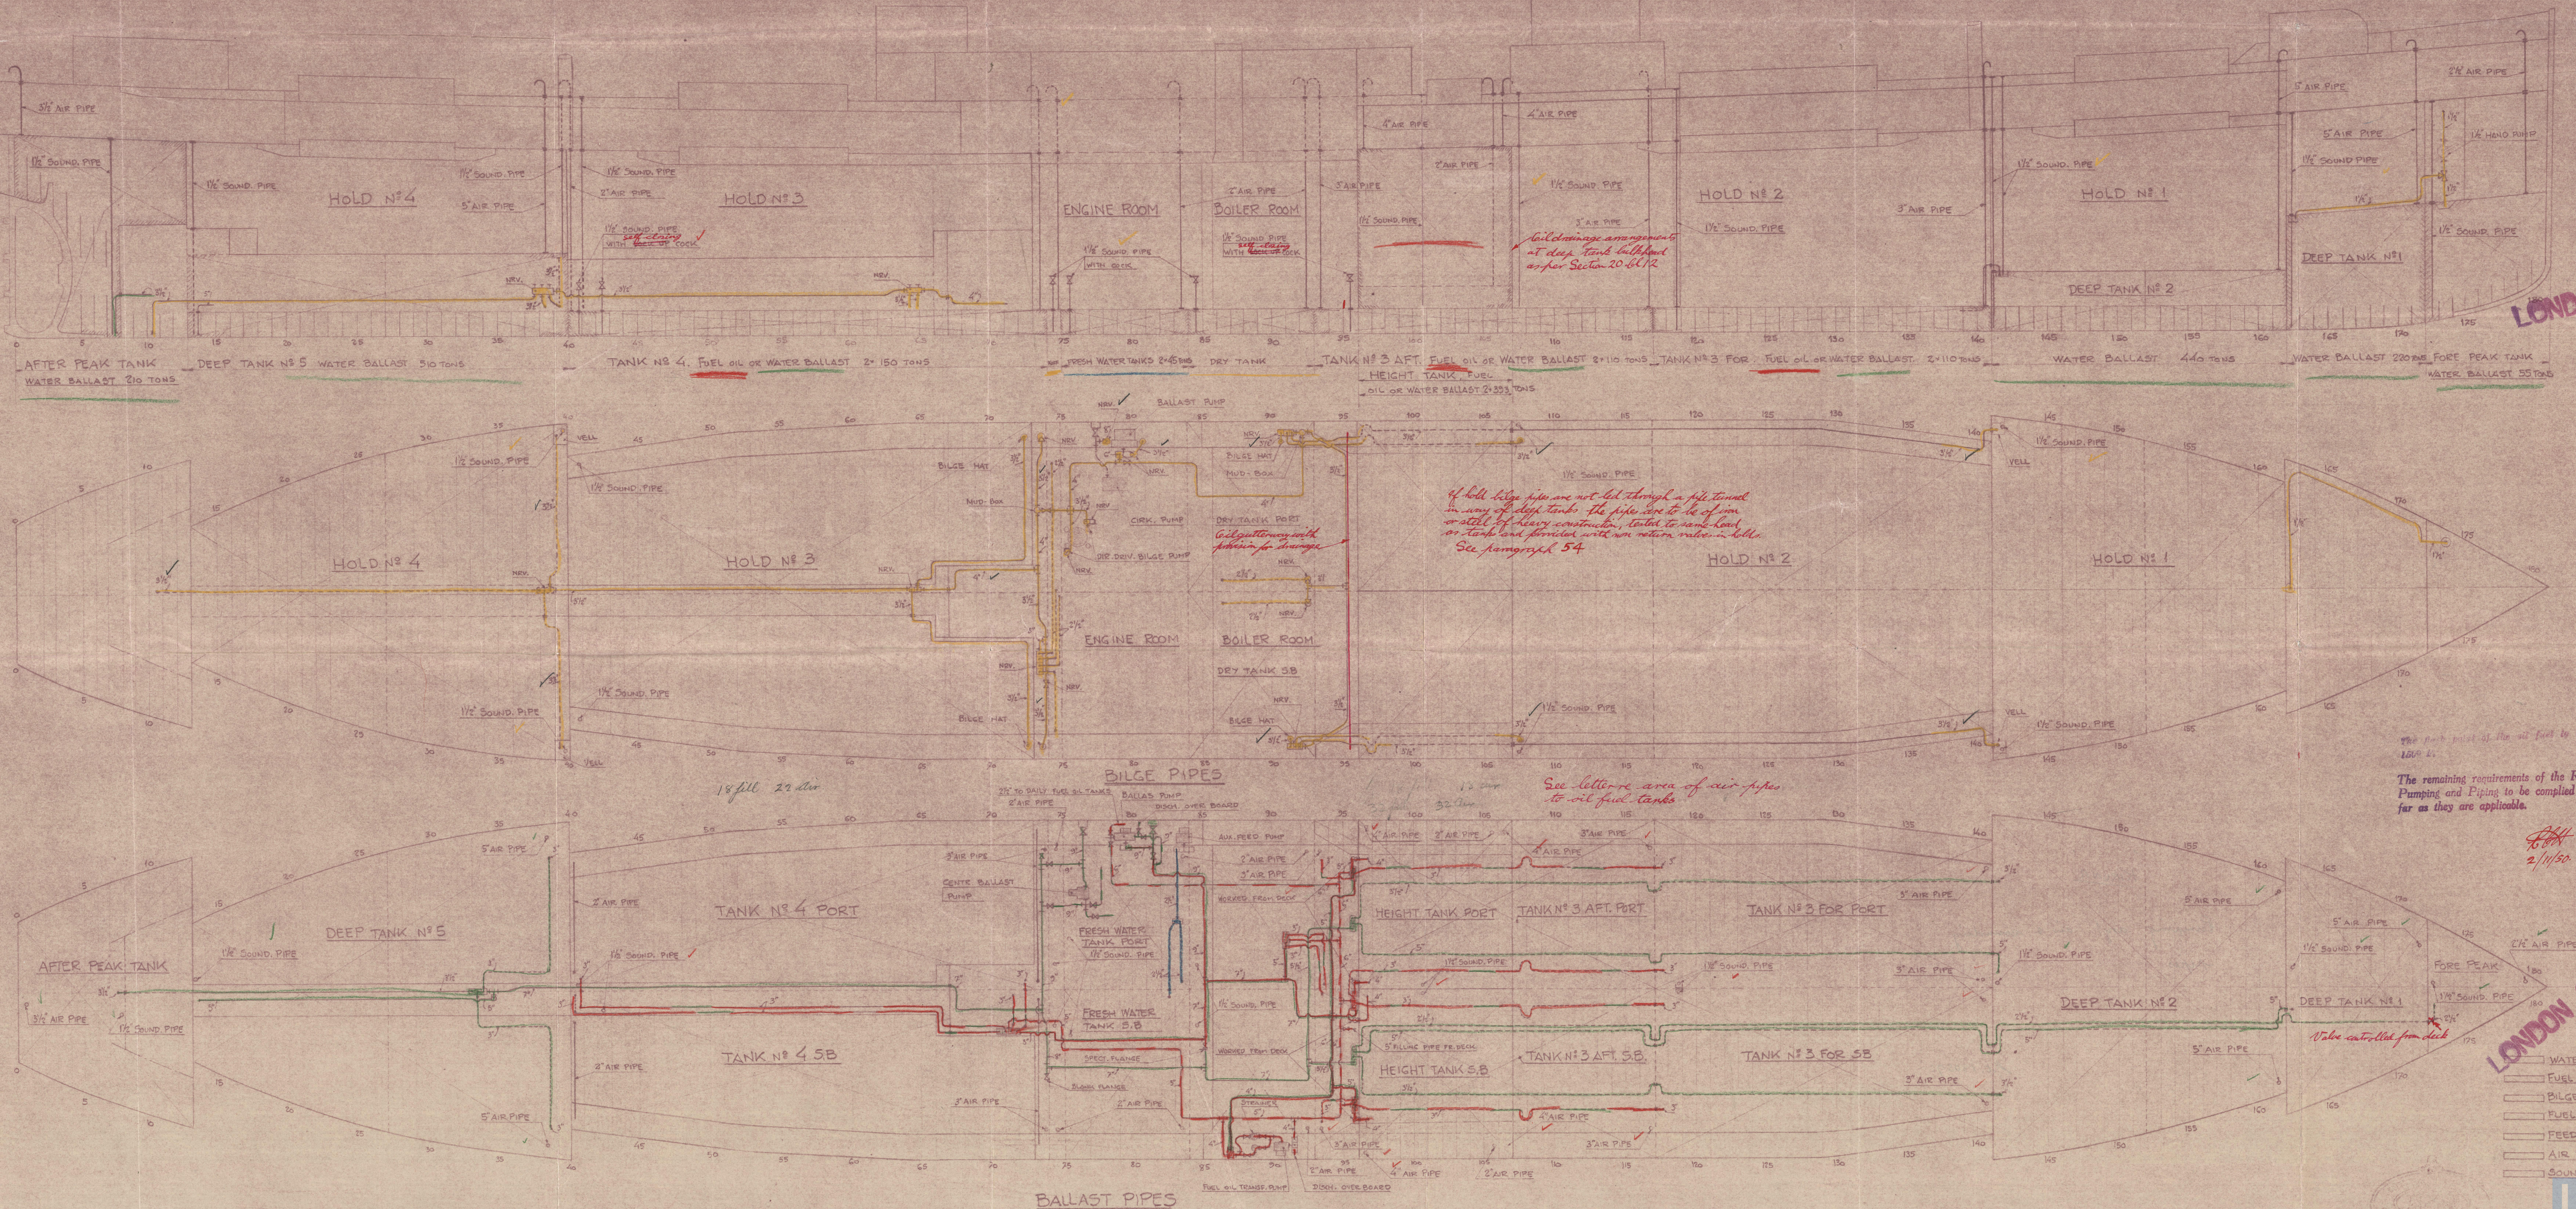

LONDON COPY

The remaining requirements of the Rules for Pumping and Piping to be complied with so far as they are applicable.

2/1/50

LONDON COPY  
LLOYD'S REGISTER OF  
SHIPPING  
BOTENBURG  
20.10.50

WATER BALLAST  
FUEL OIL OR WATER BALLAST  
BILGE PIPES  
FUEL OIL PIPES  
FEED PIPES  
AIR PIPES  
SOUND PIPES

© 2020  
Lloyd's Register  
Foundation  
OCT. 1950

" ,  
KIRUNA

Pumping airt. air & sounding  
pipes

Oct. 18059:



© 2020

Lloyd's Register  
Foundation

003263-003274-0088