




Lloyd's Register of Shipping.

Ship's Name "KING WILLIAM" Official No. 160516

Memorandum of alterations reported since ship was surveyed for assignment of Load Lines in _____

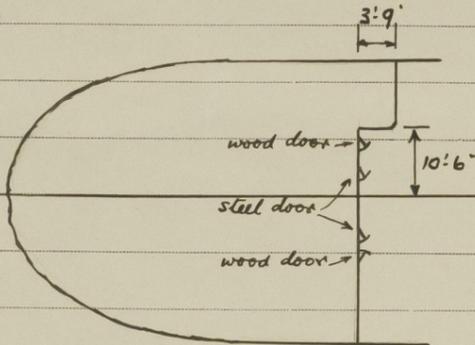

Poop front steel bulkhead extended on port side as shown in sketch and 2 steel doorways blanked off.

A copy of above has been placed on board.


J. Ballantine

24/11/51

SURVEYOR TO LLOYD'S REGISTER.
NEWCASTLE-ON-TYNE.

G.H.W.

110 DEC 1951

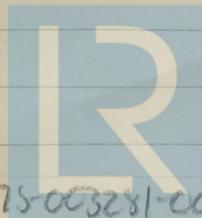

© 2020

Lloyd's Register
Foundation