

MIDSHIP SECTION

S.S. N^o 695-6

SCALE $\frac{1}{4}$ INCH = ONE FOOT

DIMENSIONS 440'-0" B.P. 58'-0" M.D. 58'-3" EXT. 34'-10" M.D. TO UPPER D^s
TO CLASS 100 71 AT LLOYDS SPECIAL SURVEY

THE SCANTLINGS & DETAILS OF CONSTRUCTION NOTED
HEREON ARE SUBMITTED ON THE UNDERSTANDING
THAT THEY ARE THE MINIMUM WHICH WILL BE
ACCEPTED FOR CLASS, AND IF NOT THEY ARE TO
BE AMENDED, ERRORS & OMISSIONS ACCEPTED


EQUIPMENT NUMBER

LONGITUDINAL NUMBER = 43630 10
POOP 45.5 x 8.0 = 364 10
BRIDGE 126.0 x 8.0 = 1008 00
FORECASTLE 45.5 x 8.0 = 364 10
HOUSES 27.5 x 8.0 = 220 00
EQUIPMENT NUMBER = 43630 10





EQUIPMENT

2 BOWER ANCHORS 6 1/2 CWTs EX STOCK
1 STREAM ANCHOR 2 1/2
1 HEDGE 10
300 FATHOMS 2 1/2 STUDD CHAIN CABLE 890-1-4
140 1 1/2 STUDD OR STEEL WIRE
2 HARPS OF 8 100 FATHOMS EACH OF STEEL WIRE
2 8 100

SECTION OF FRAMING EXCEPT IN WAY OF FORE HOLD

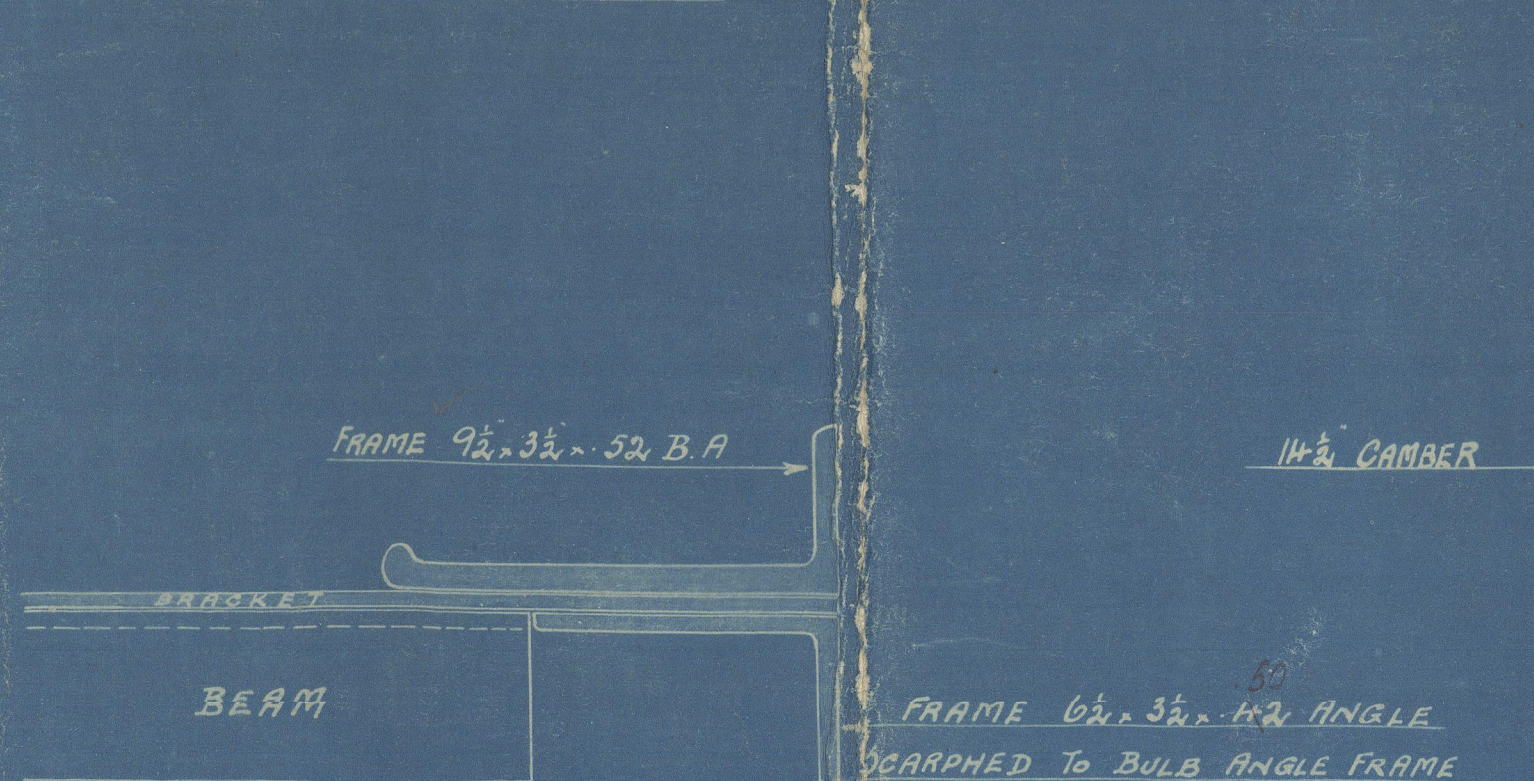

SECTION OF FRAMING IN FORE HOLD

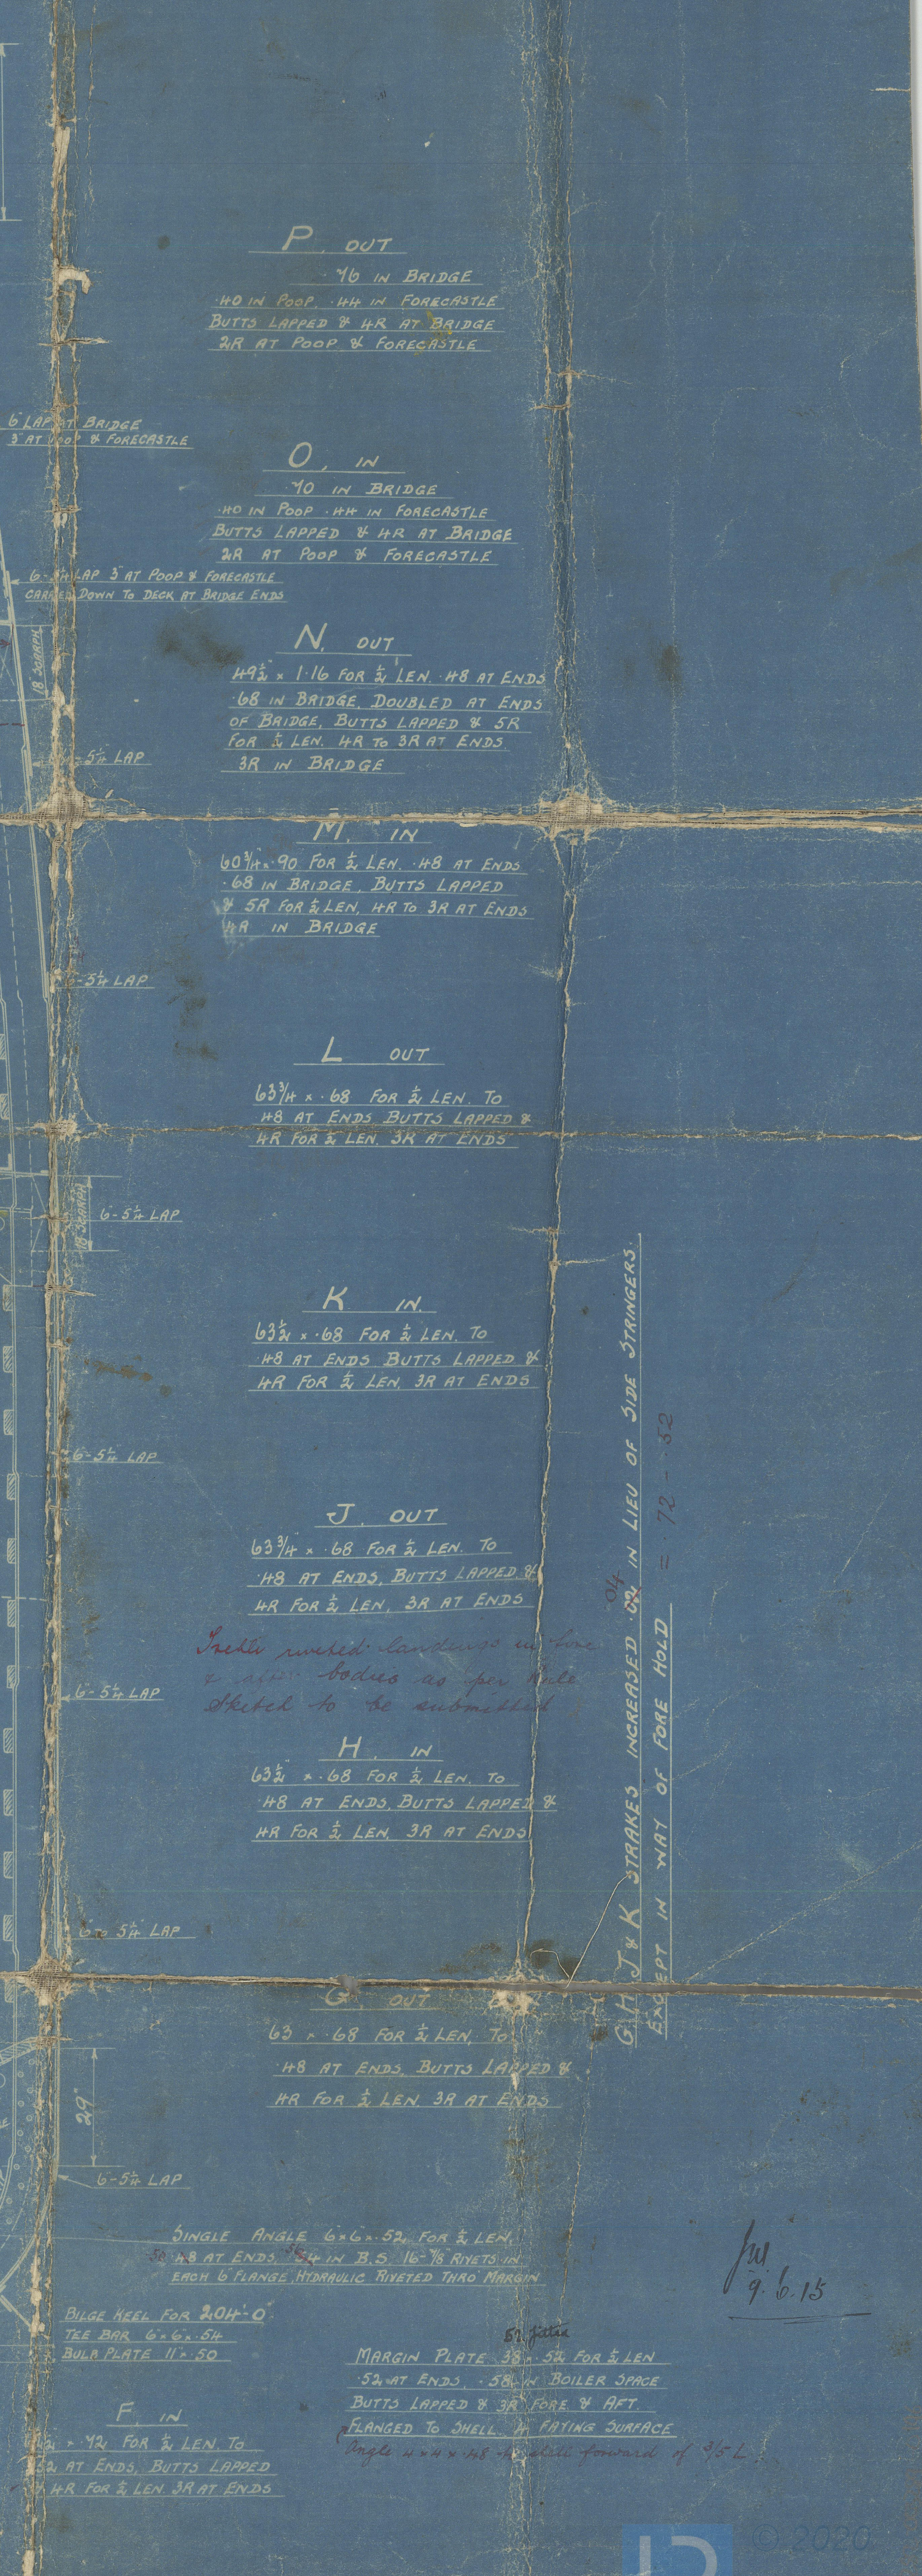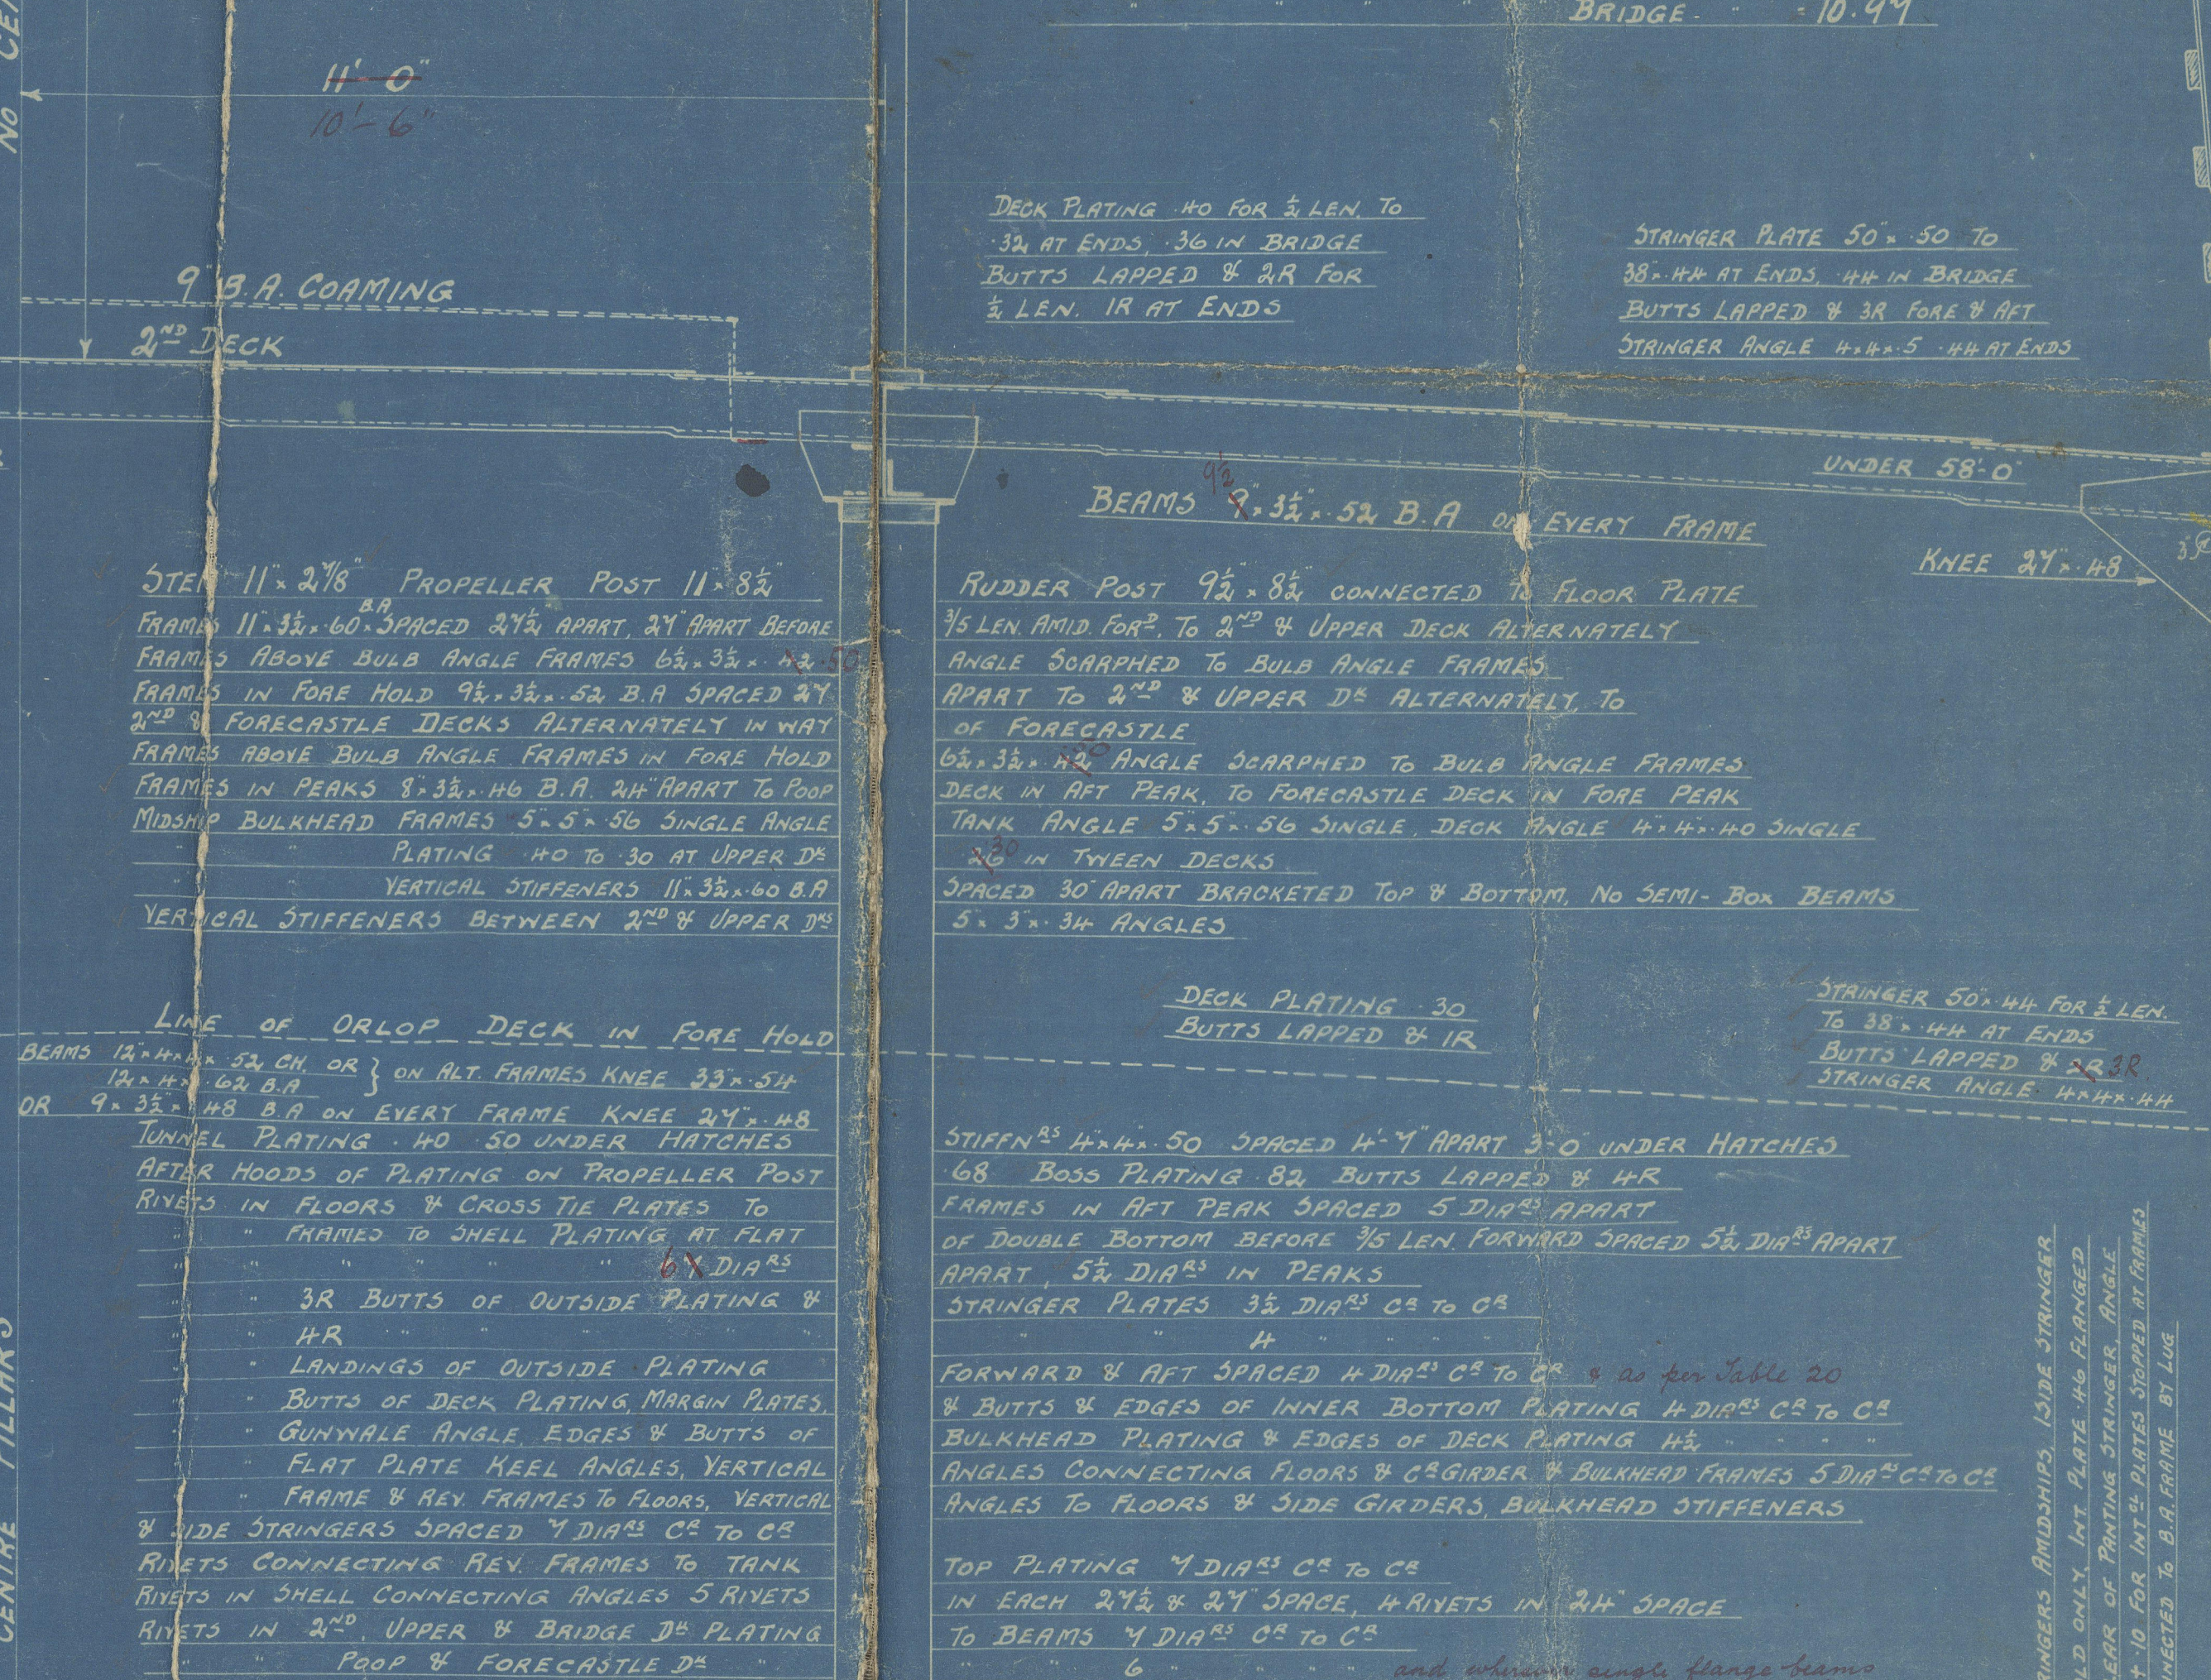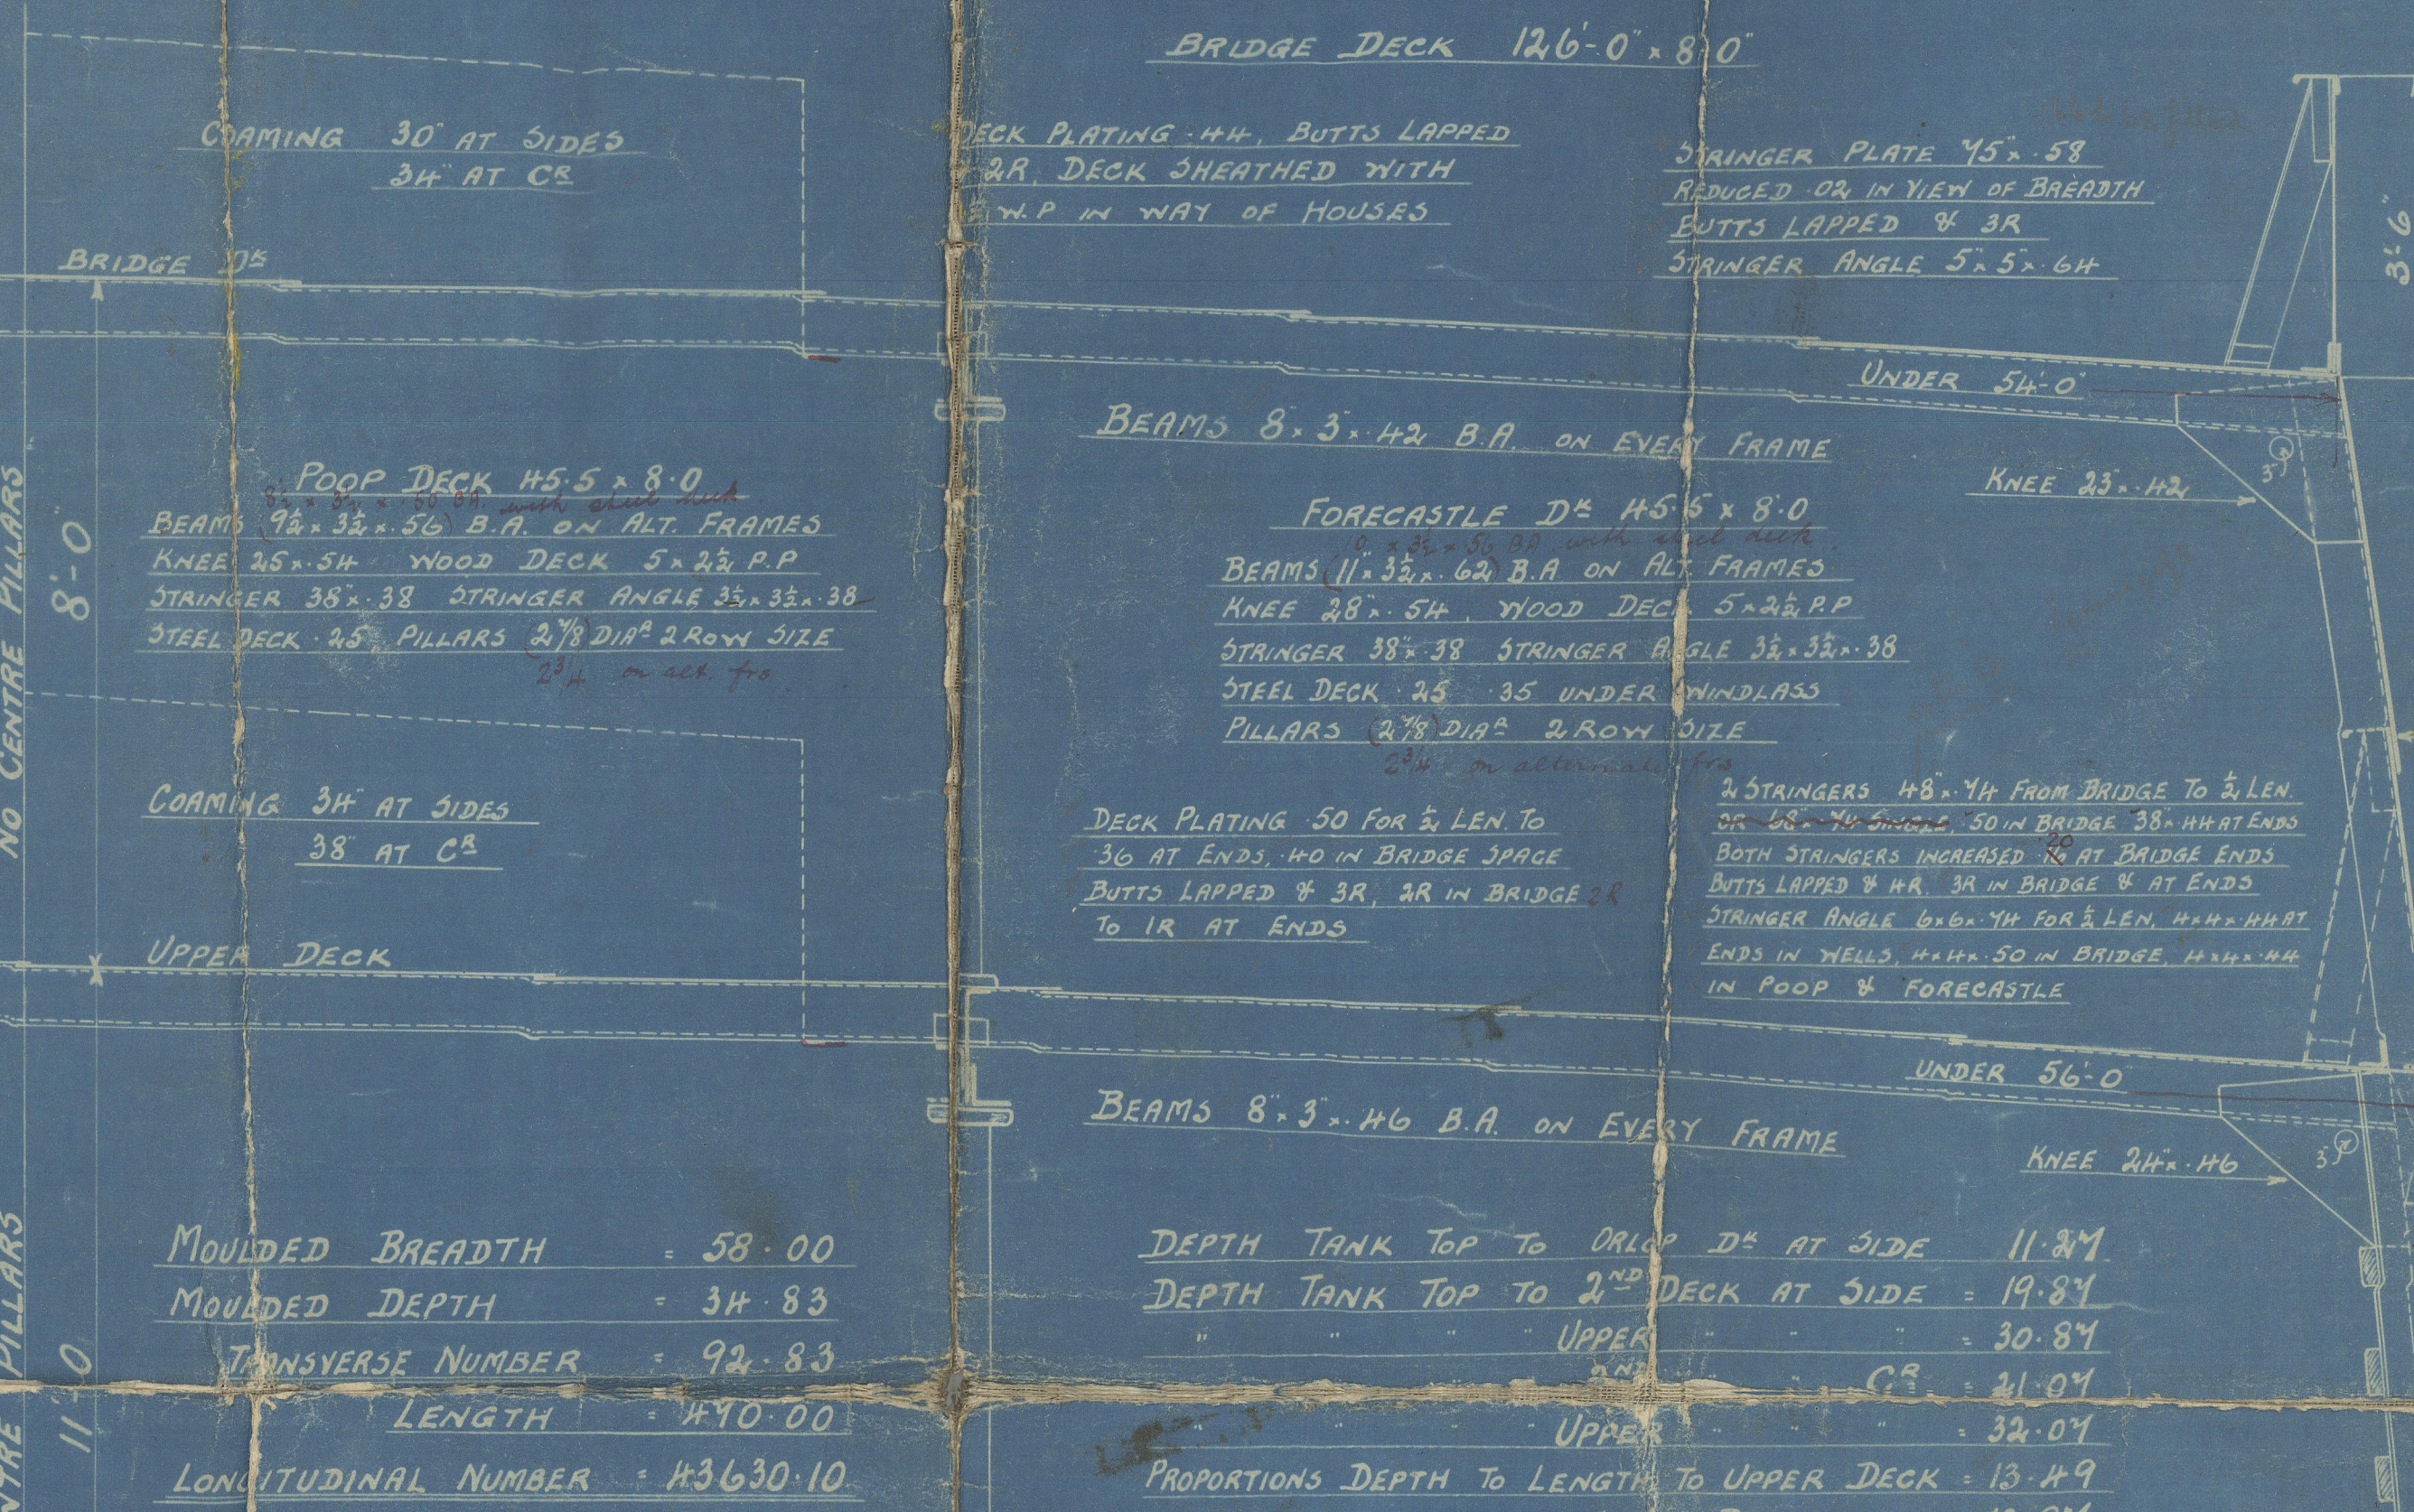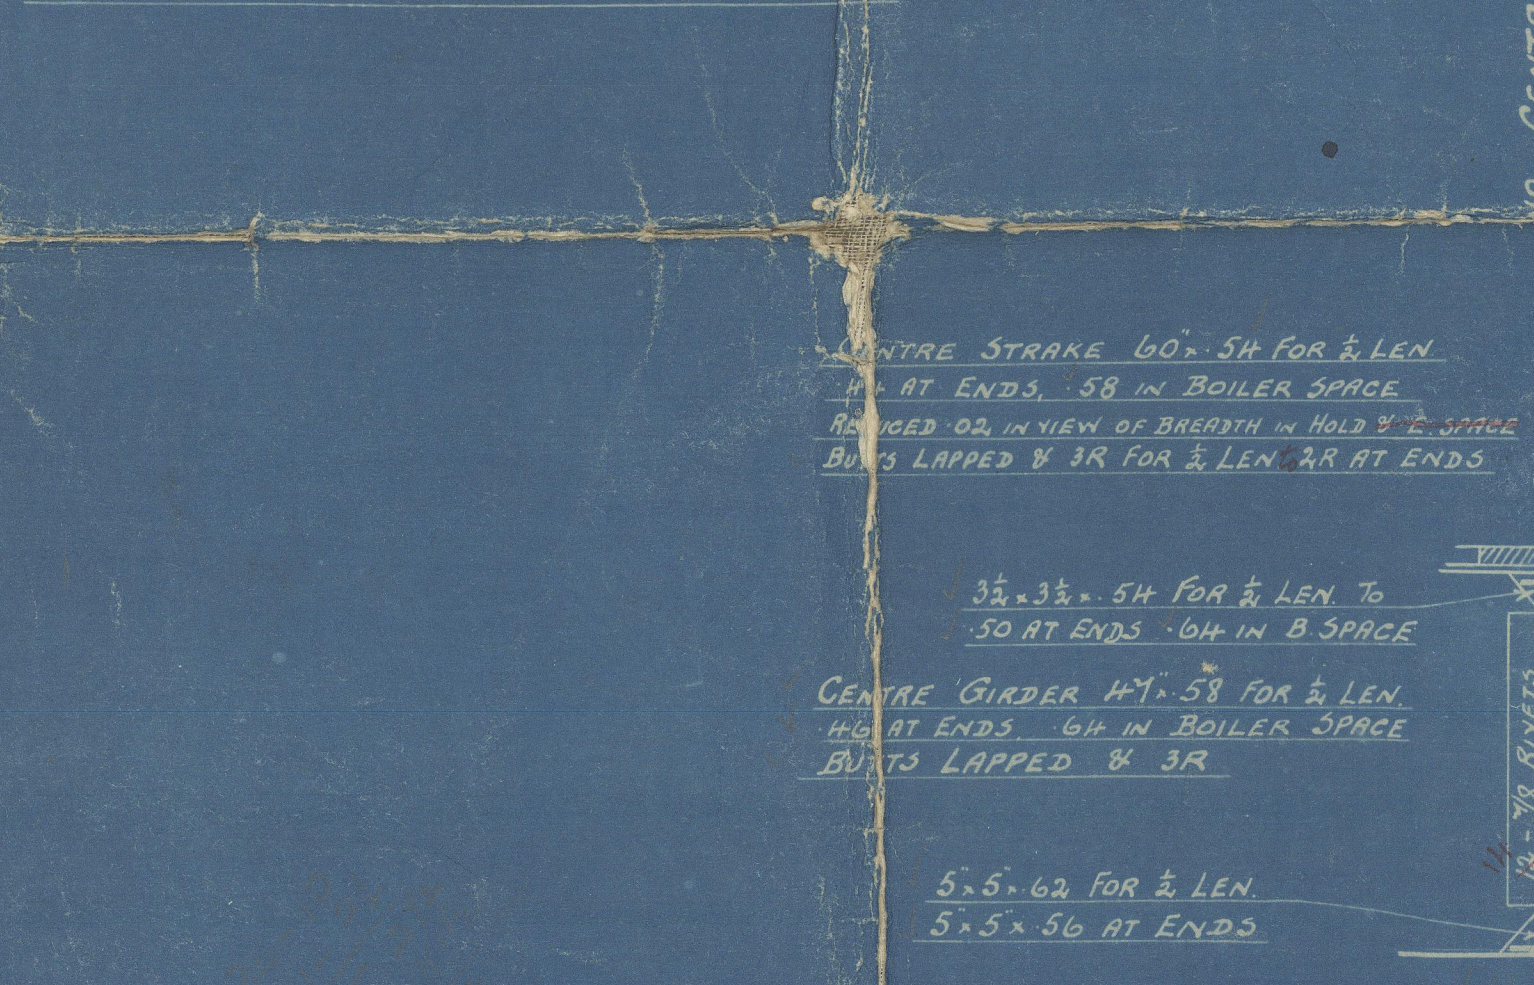

STIFFENERS INCREASED IN LINE OF SIDE STIFFENERS
EXCEPT IN WAY OF FORE HOLD = 72 - 82

9.6.15



00282-00289-0198

Quinto Col


695, 676 & 705, 706

Midship Sect


695 88 main

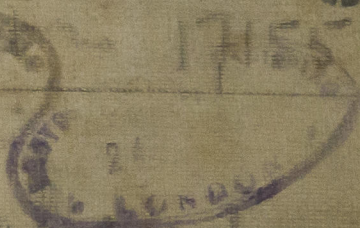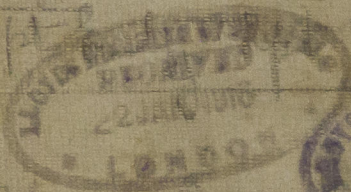

696 main

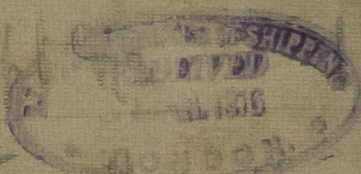

705 main

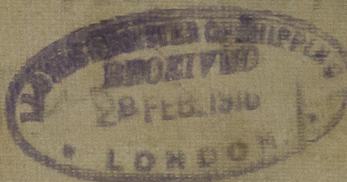

706 main



RECORDS DEPT.
LONDON.

