

№3 DEEP BALLAST TANK (AS FITTED)

M. C.D. 2043.


2 SHEETS SHEET 1

9-7-34


SCALE $\frac{1}{4}'' = 1$ FOOT

MALTA YARD
20 AUG 1934
MANAGER
CONSTRUCTIVE DEPT.


— SECTION AT A A —

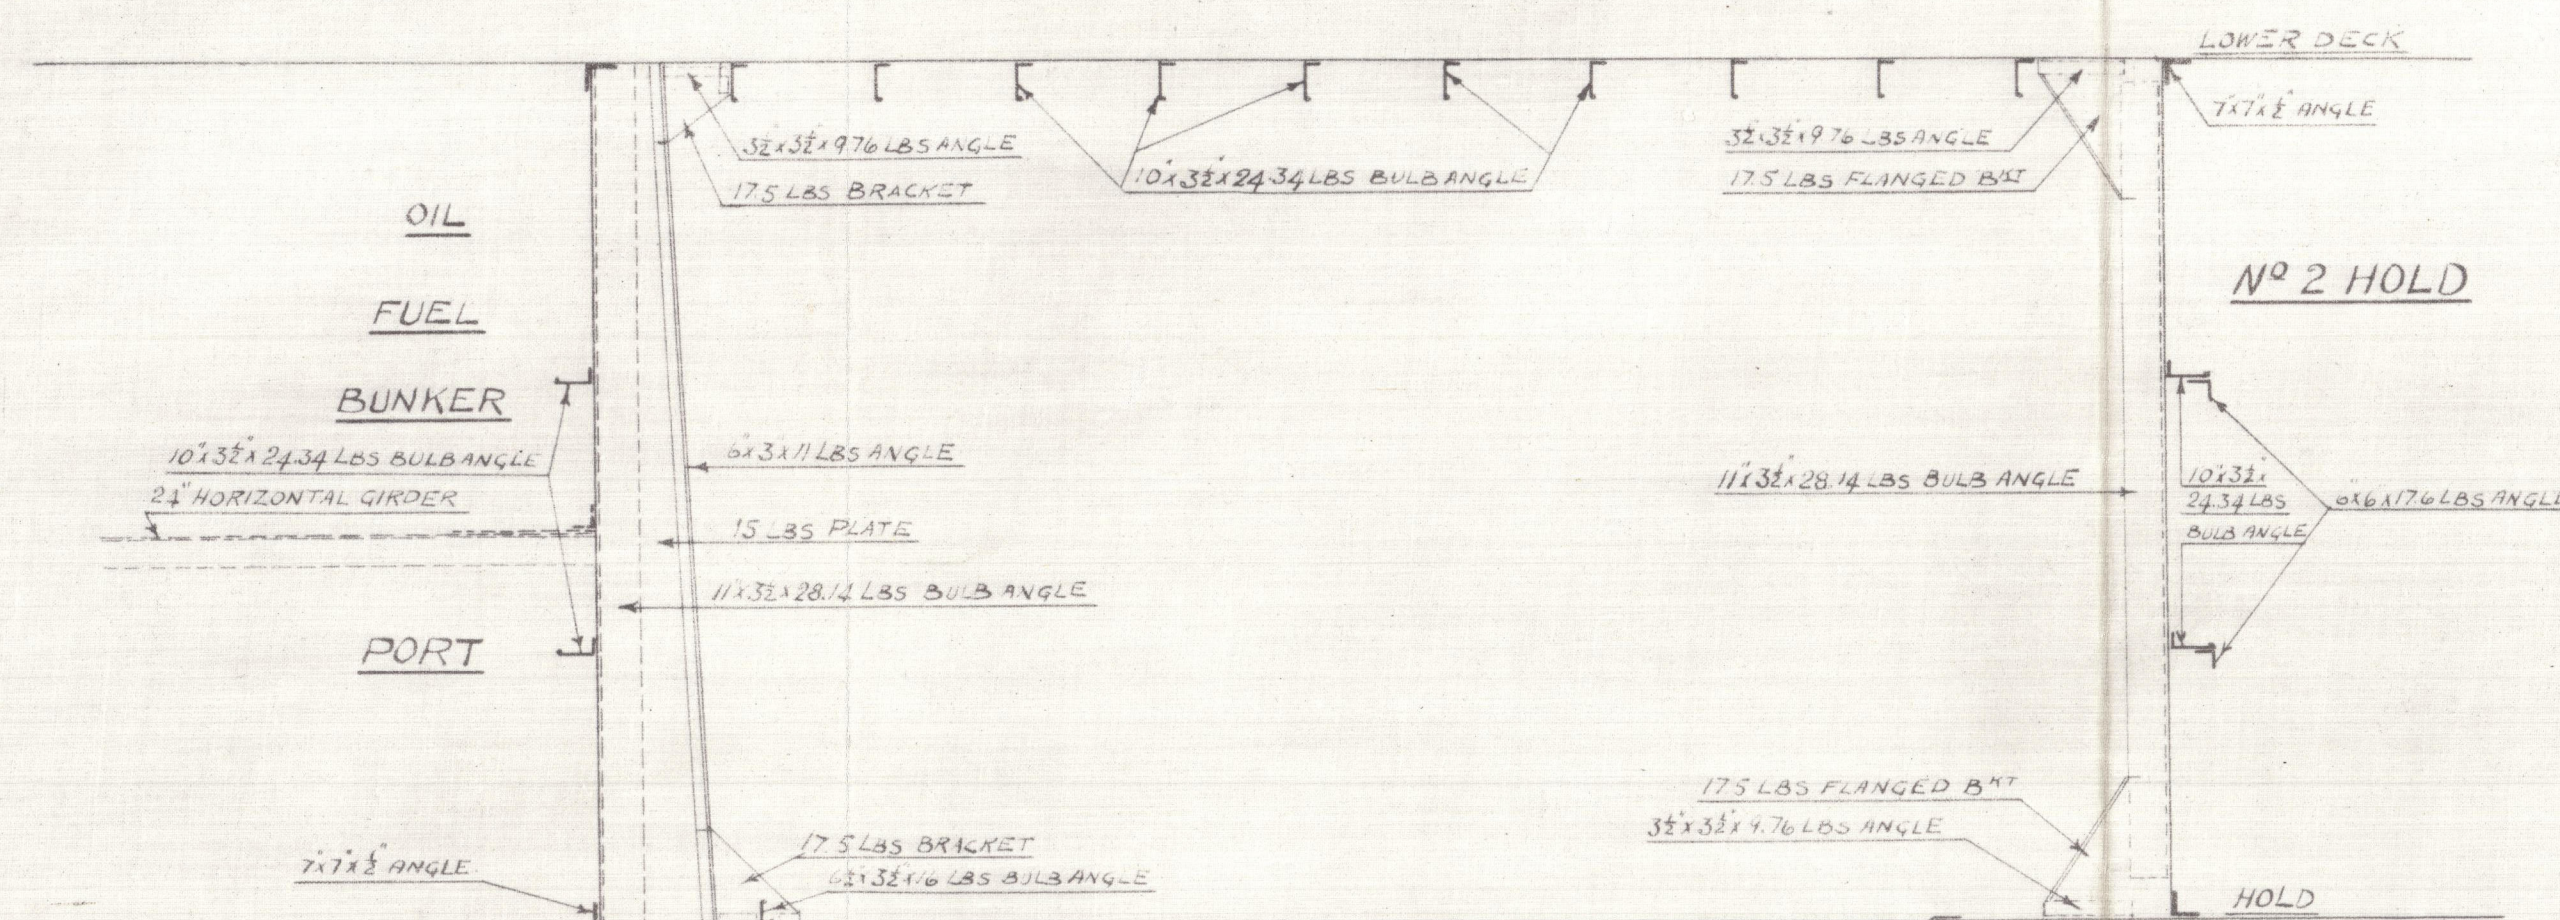

ELEVATION AT MIDDLE LINE B^{KD}
LOOKING TO PORT

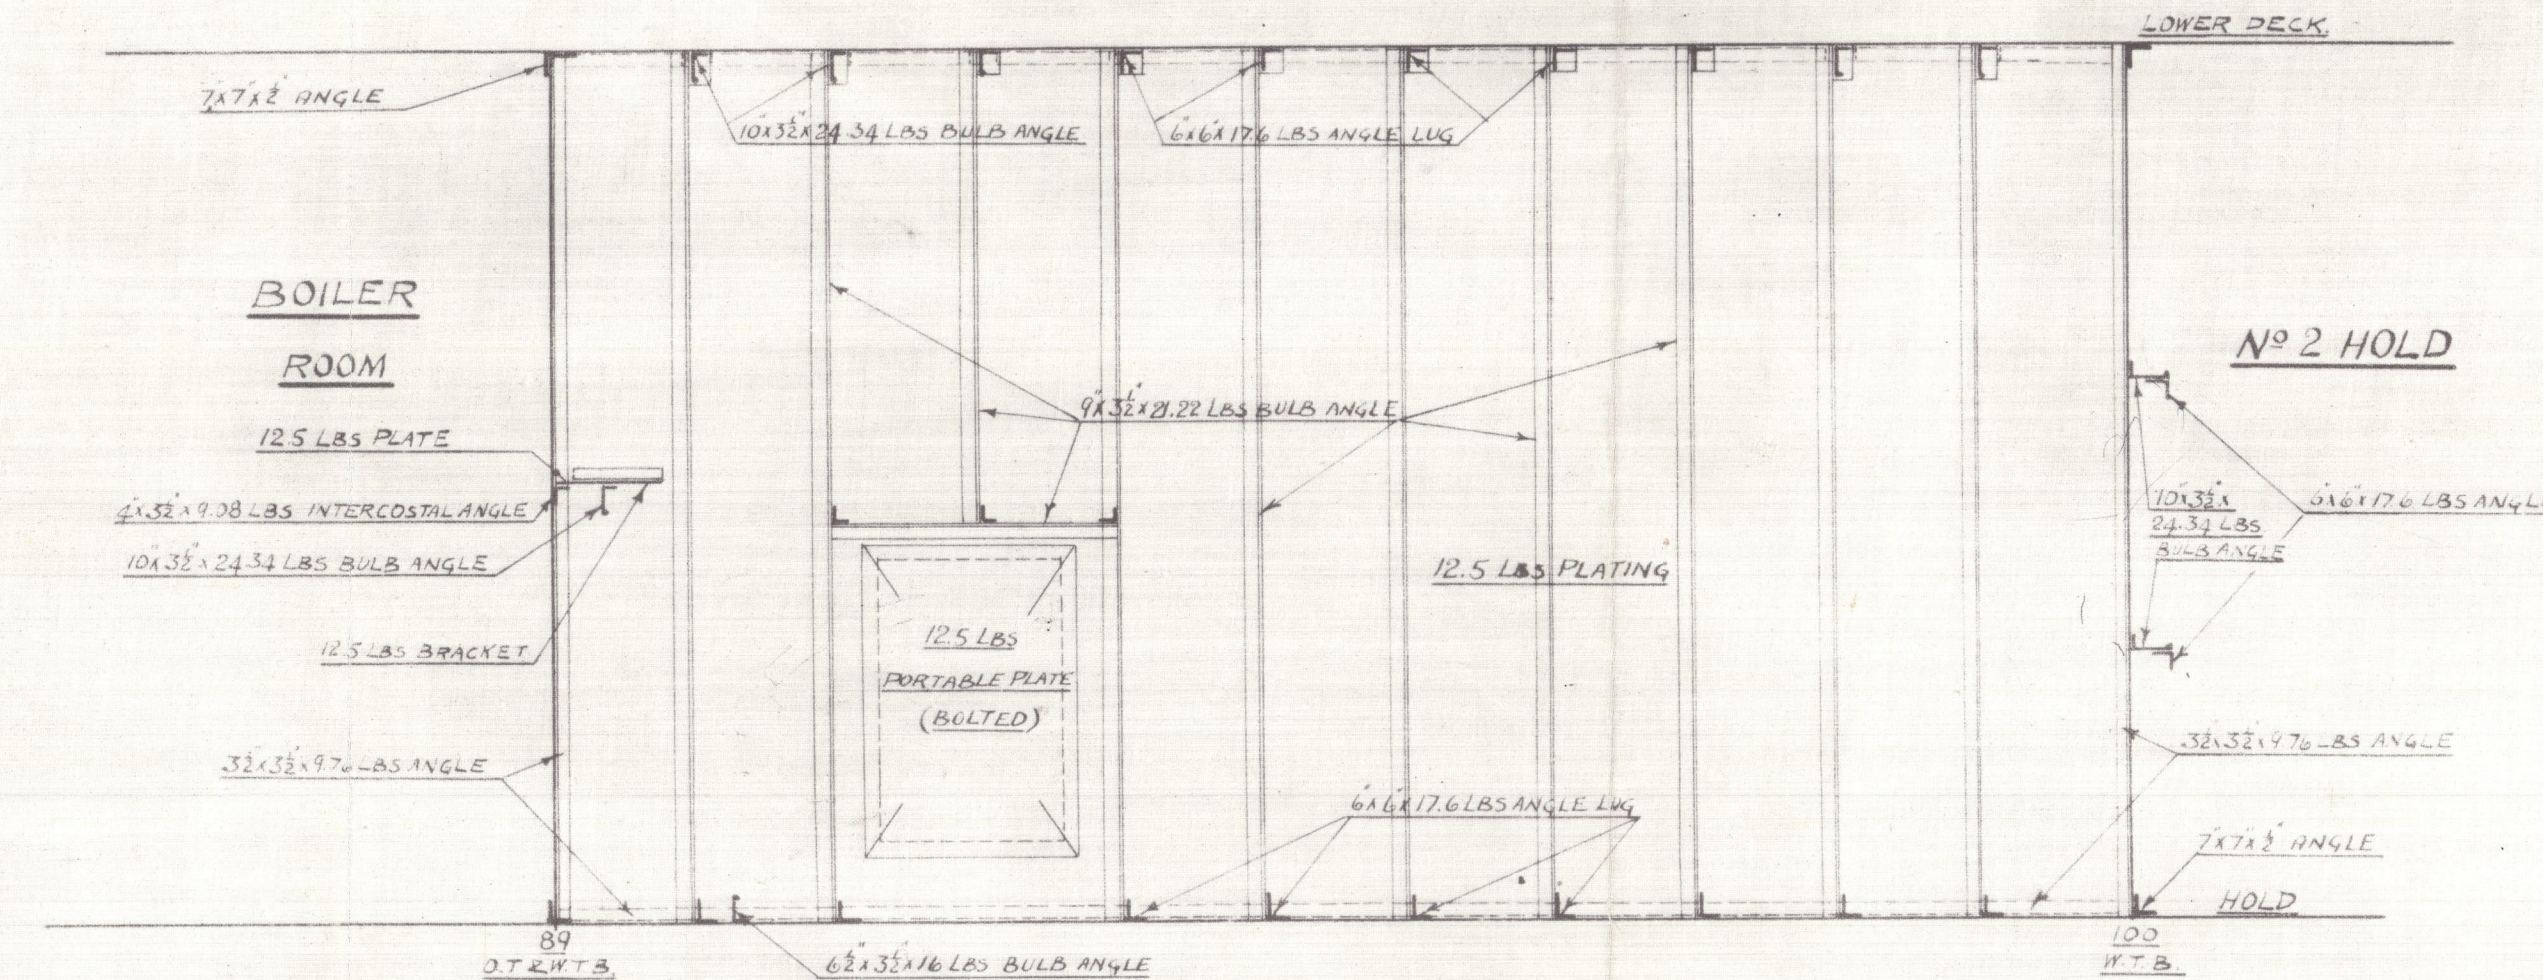


— PLAN —

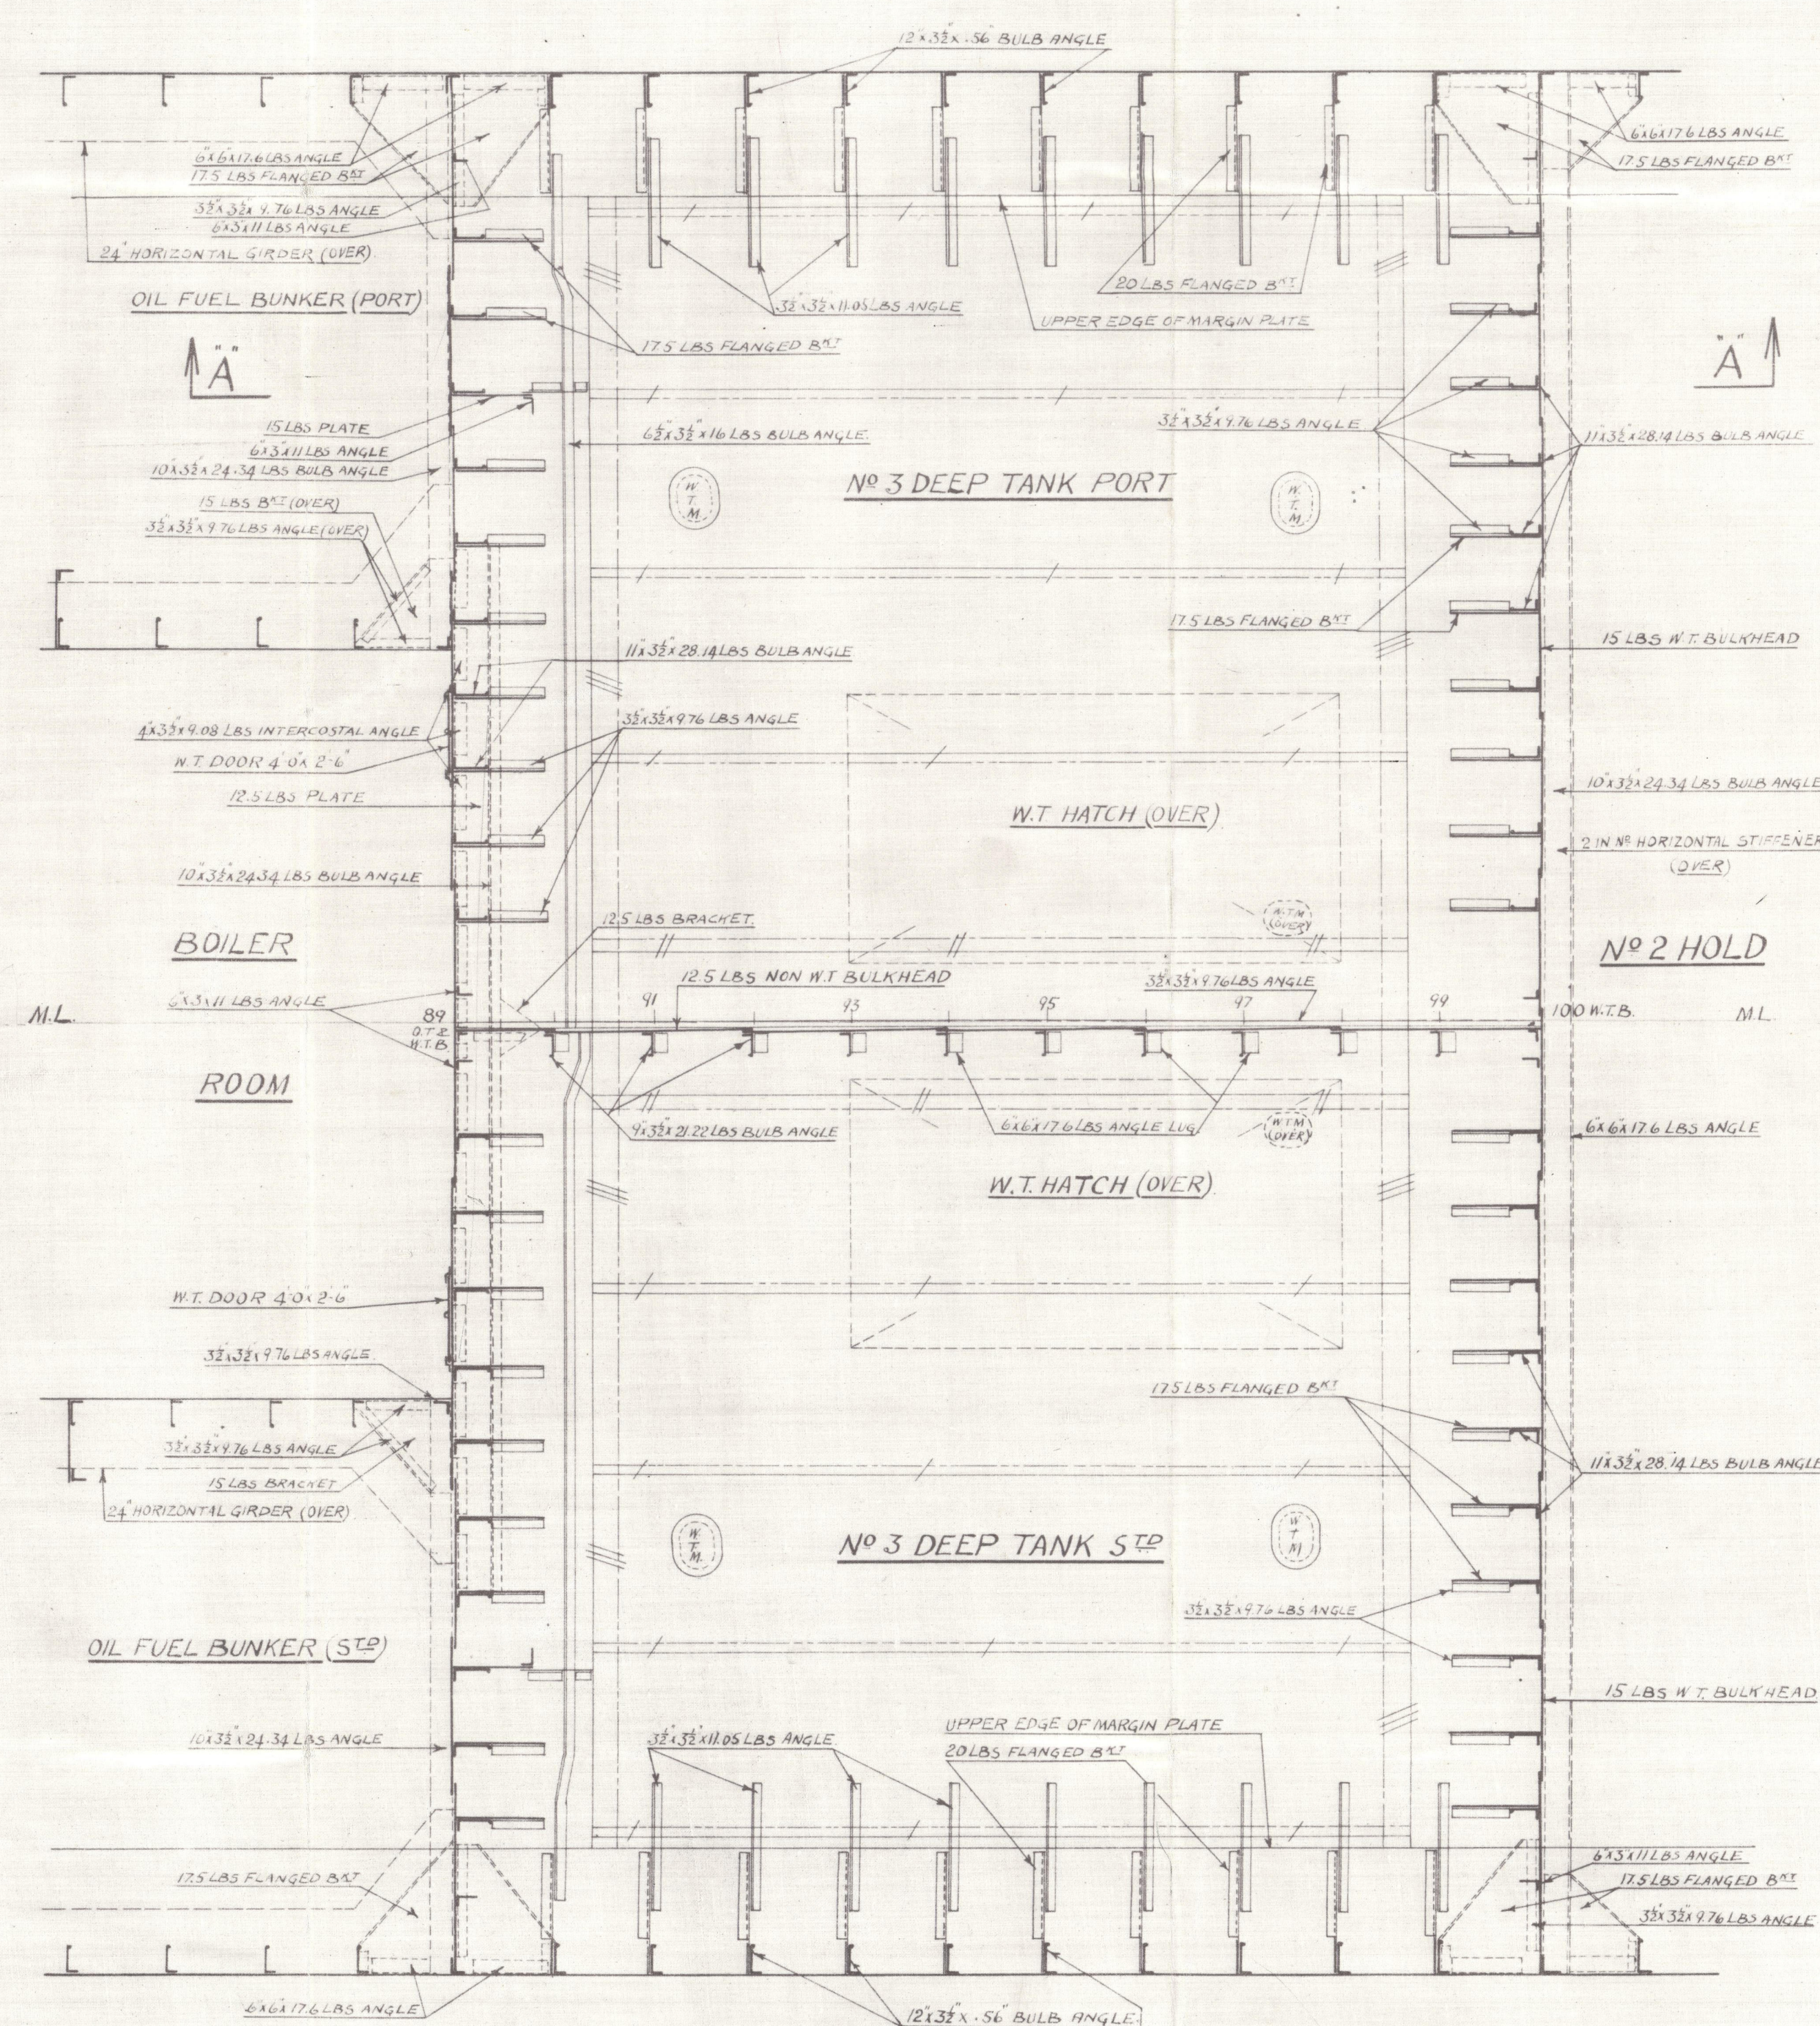

— ELEVATION AT 100 WT B^{KD} —
LOOKING FORWARD



— ELEVATION AT 89 BULKHEAD —

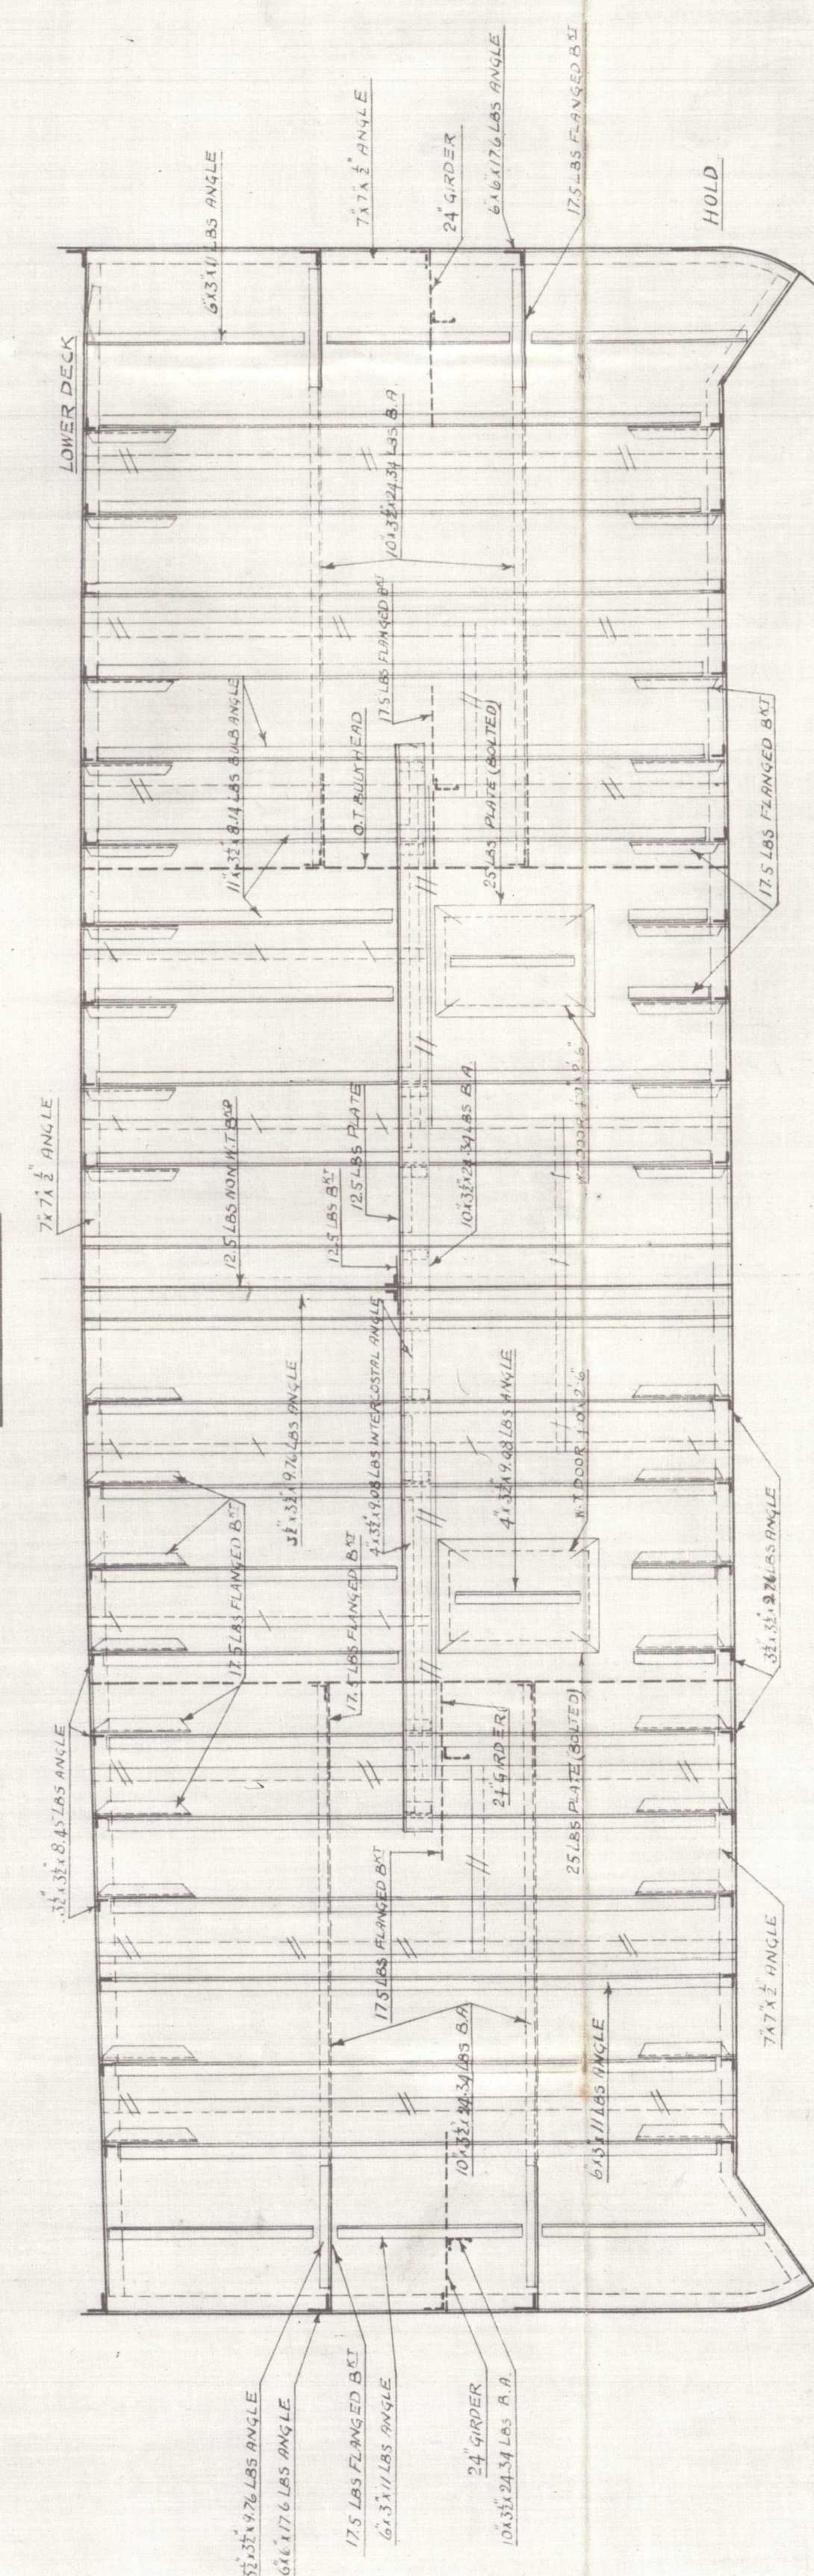

— SECTION AT 95 STATION —
LOOKING FORWARD

