

R.Q.D. COASTERS Nos 400-401

LONGITUDINAL SECTION - DECK PLANS

Scale - 1/8" = 1 Foot

To Class + 100 A1 at Lloyd's

Dimensions - 140'-0" x 33'-0" x 4'-2" to Upper Deck - 13'-2" to Quarter Deck

4th Dec 1926

Windows, windows, hatch to be applied
to the structure later section

Dimensions - D = 4" to Upper Deck

D = 13' 7" Quarter

1st Longitudinal = L x D = 140 x 4' 1" = 584'


2nd = L x D = 140 x (30 - 4' 1") = 531'

Proportions 70 = 140 / 2 = 70' to Upper Deck

137 = 140 / 1.02 = 137' Quarter Deck

Frame Depth = 11' to Upper Deck, 13' to Quarter Deck

Section 11-4 b

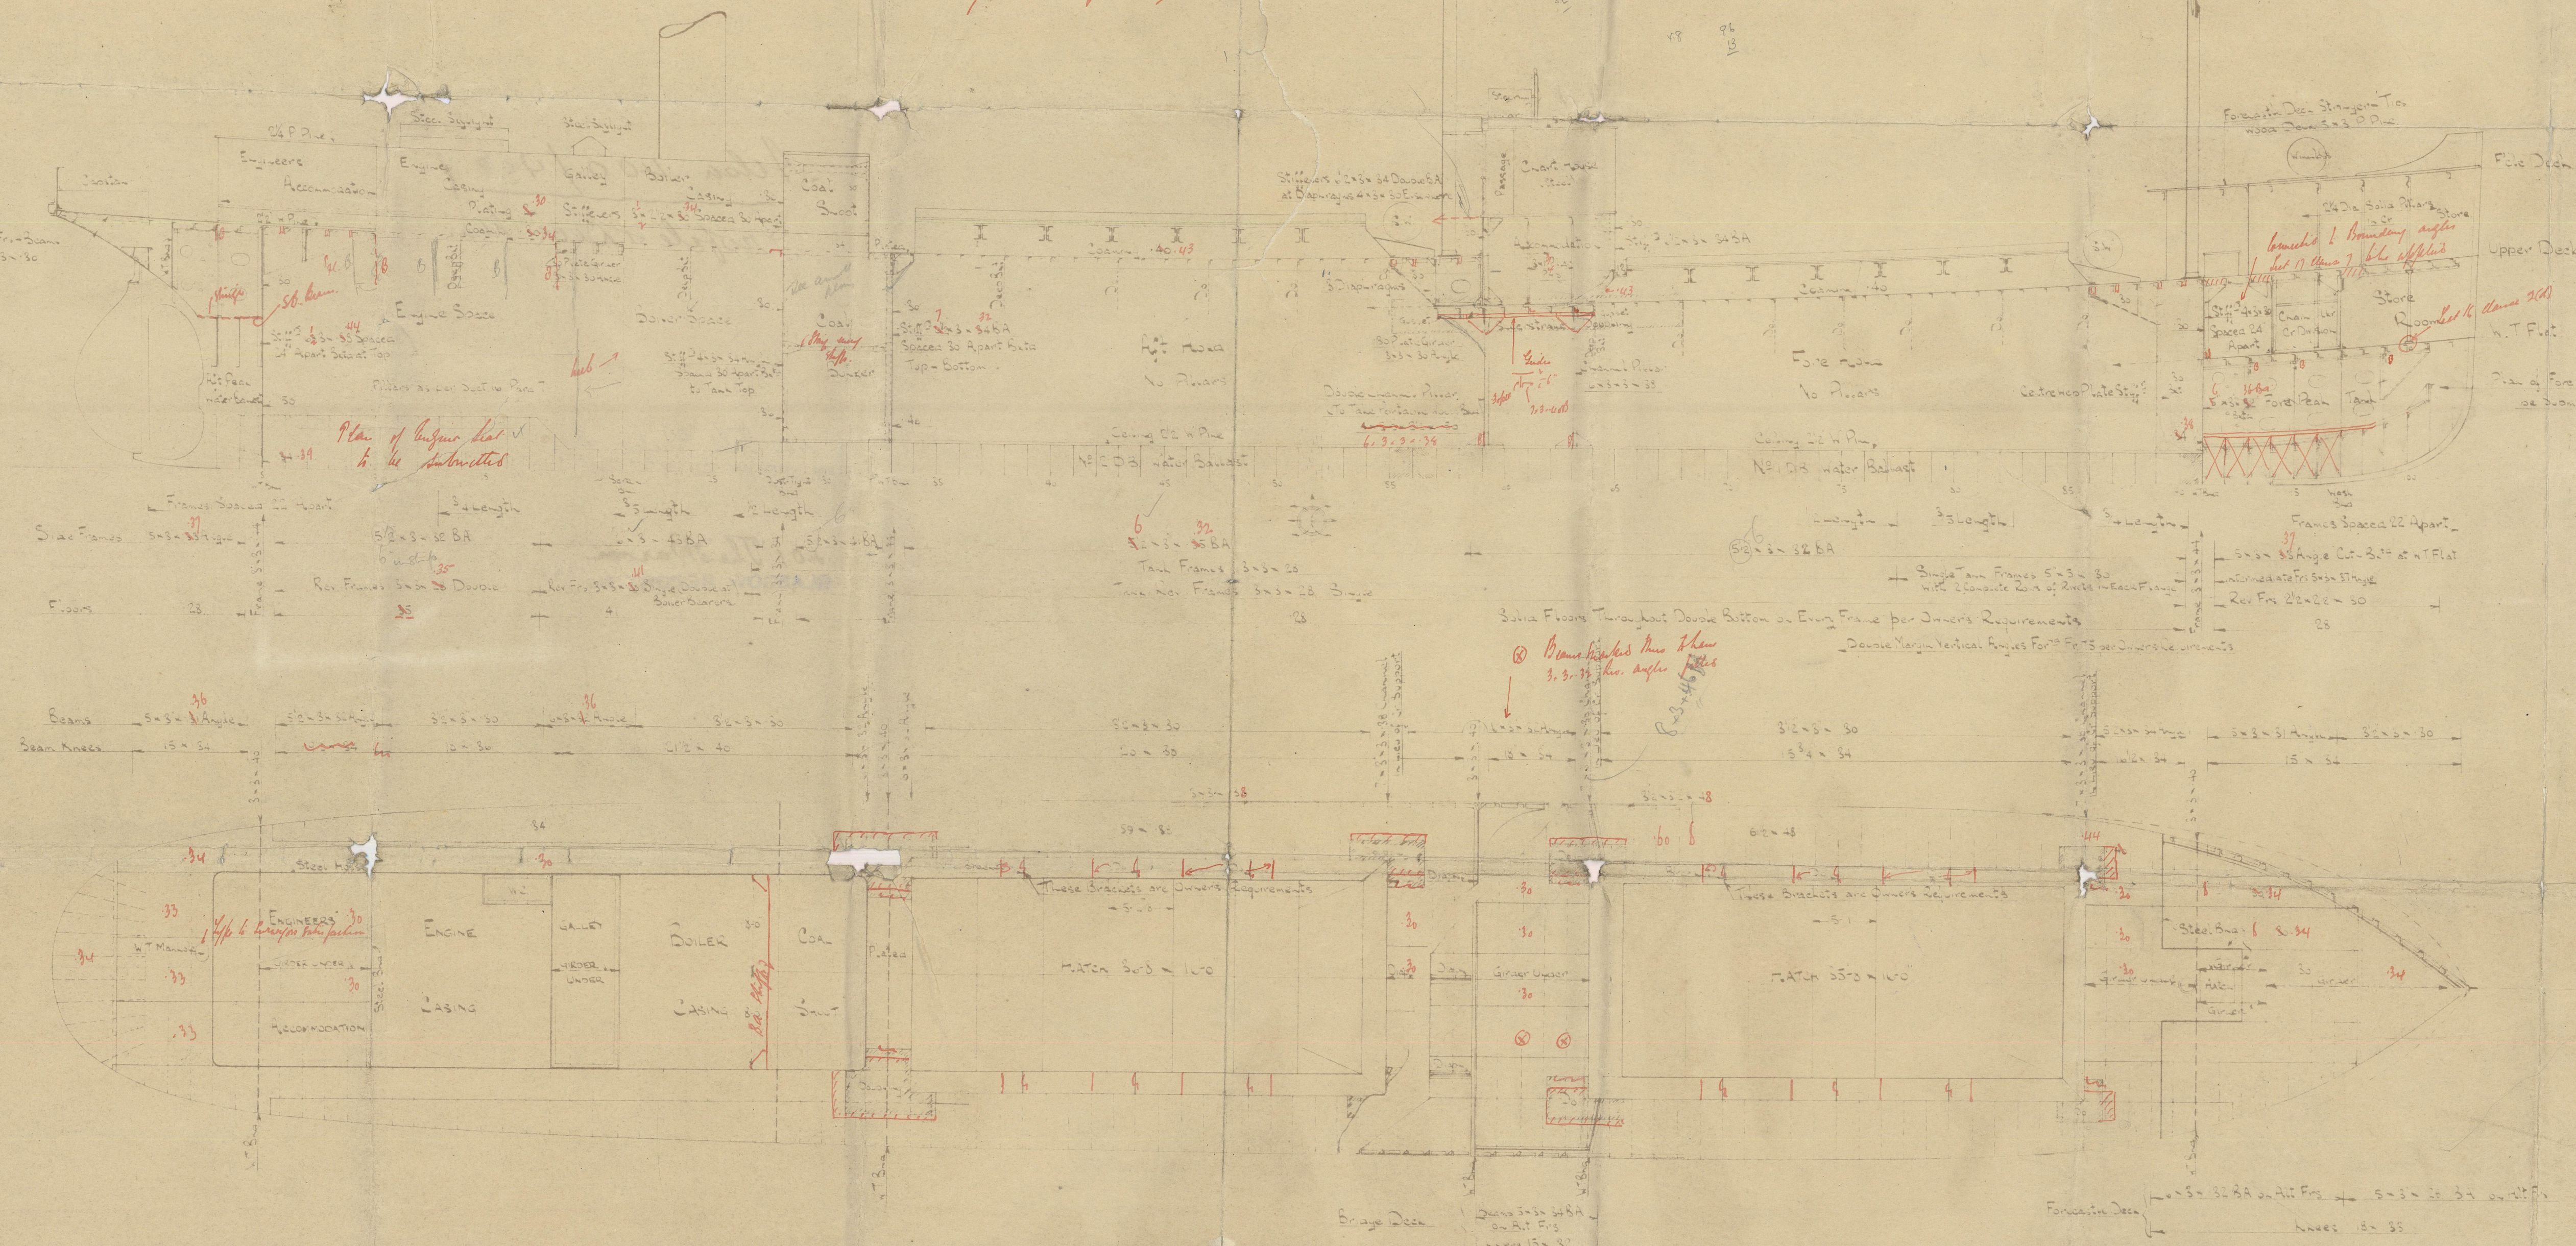

APPROVED
LLOYD'S REGISTER OF SHIPPING

DATE 15.11.26



100311-003320-0187

