



APPROVED In Accordance  
 WITH  
 BRITISH CORPORATION RULES AND REQUIREMENTS

s.s. "Svend Pii" Alteration of shell plating frame 10-23.

Original shell plating frame 10-23.

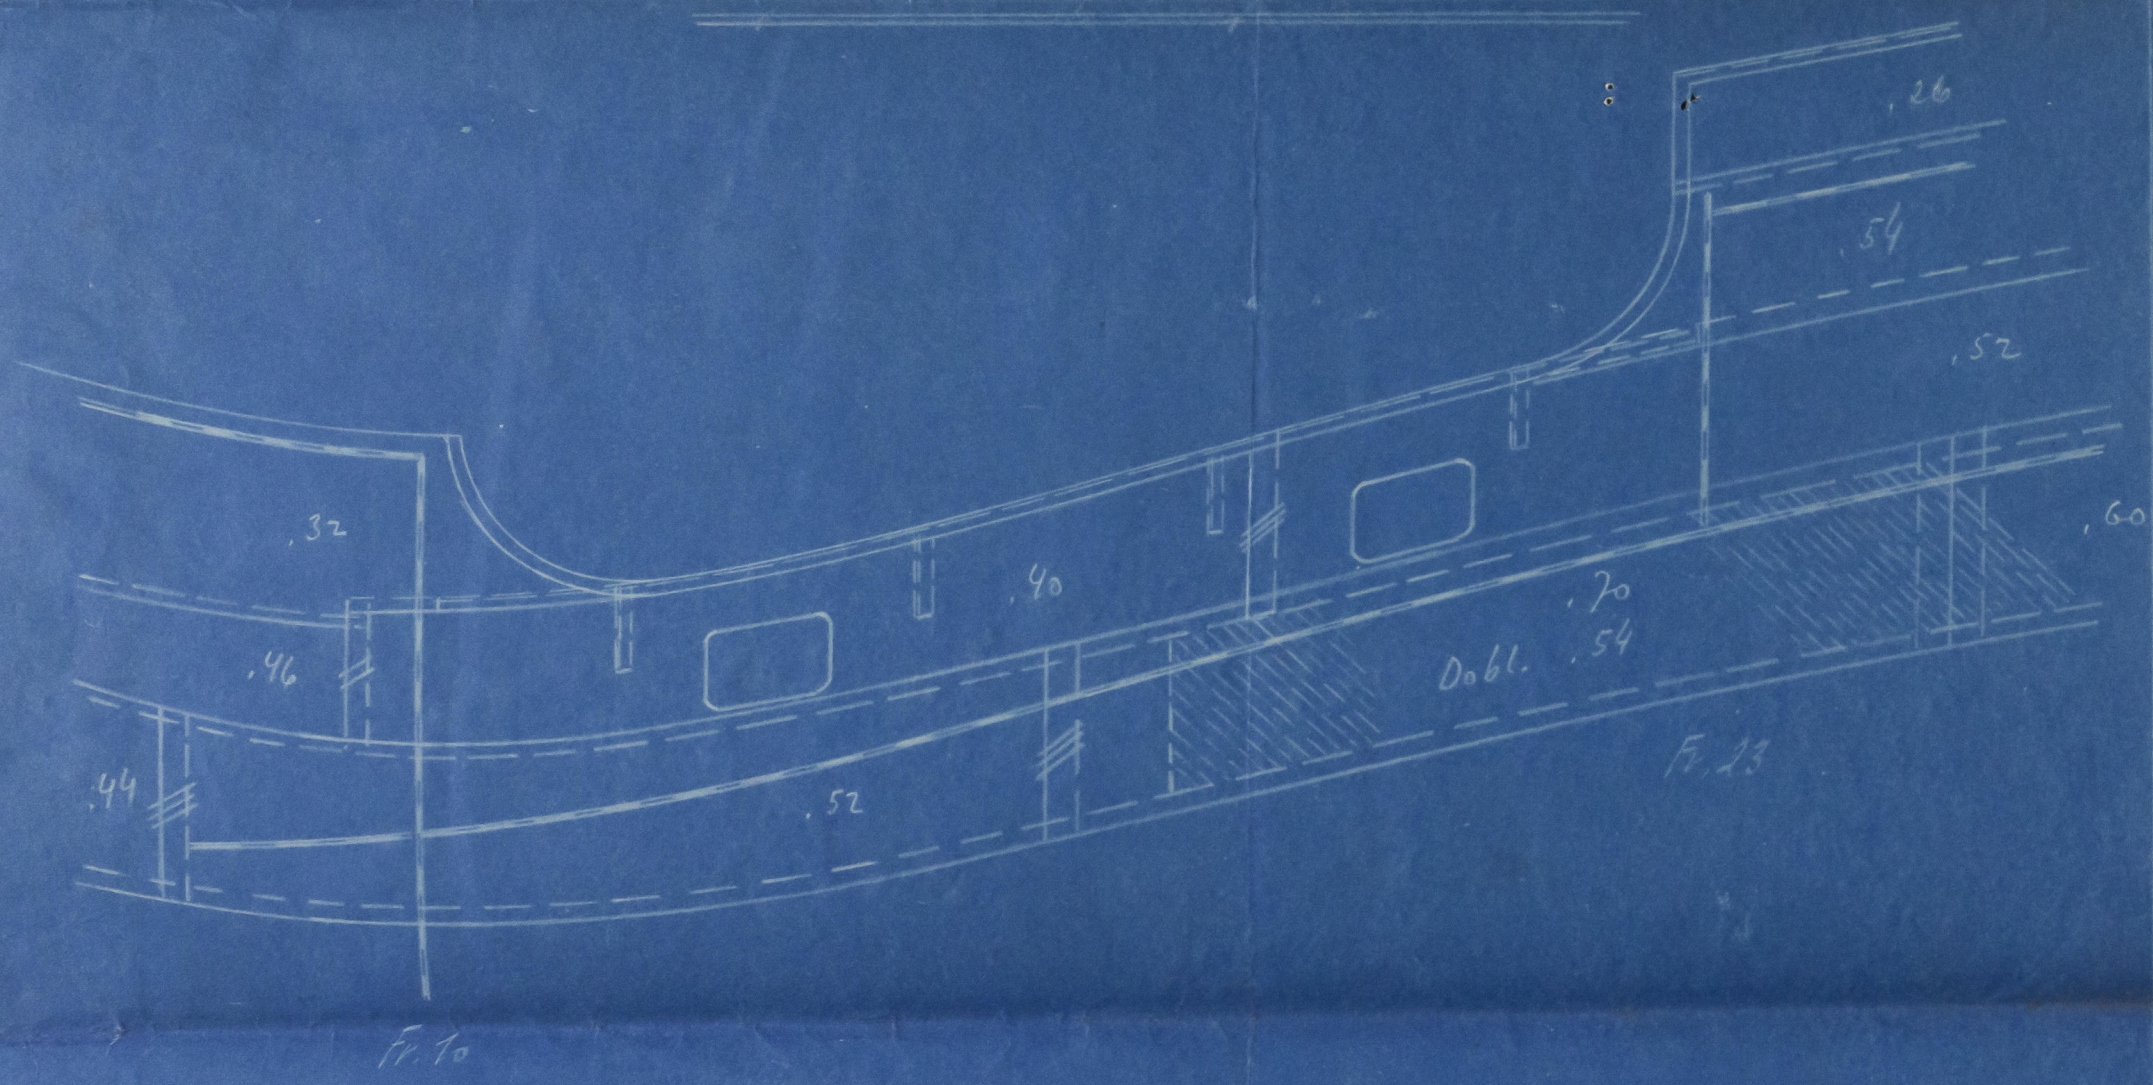

New shell plating fr. 10-23.

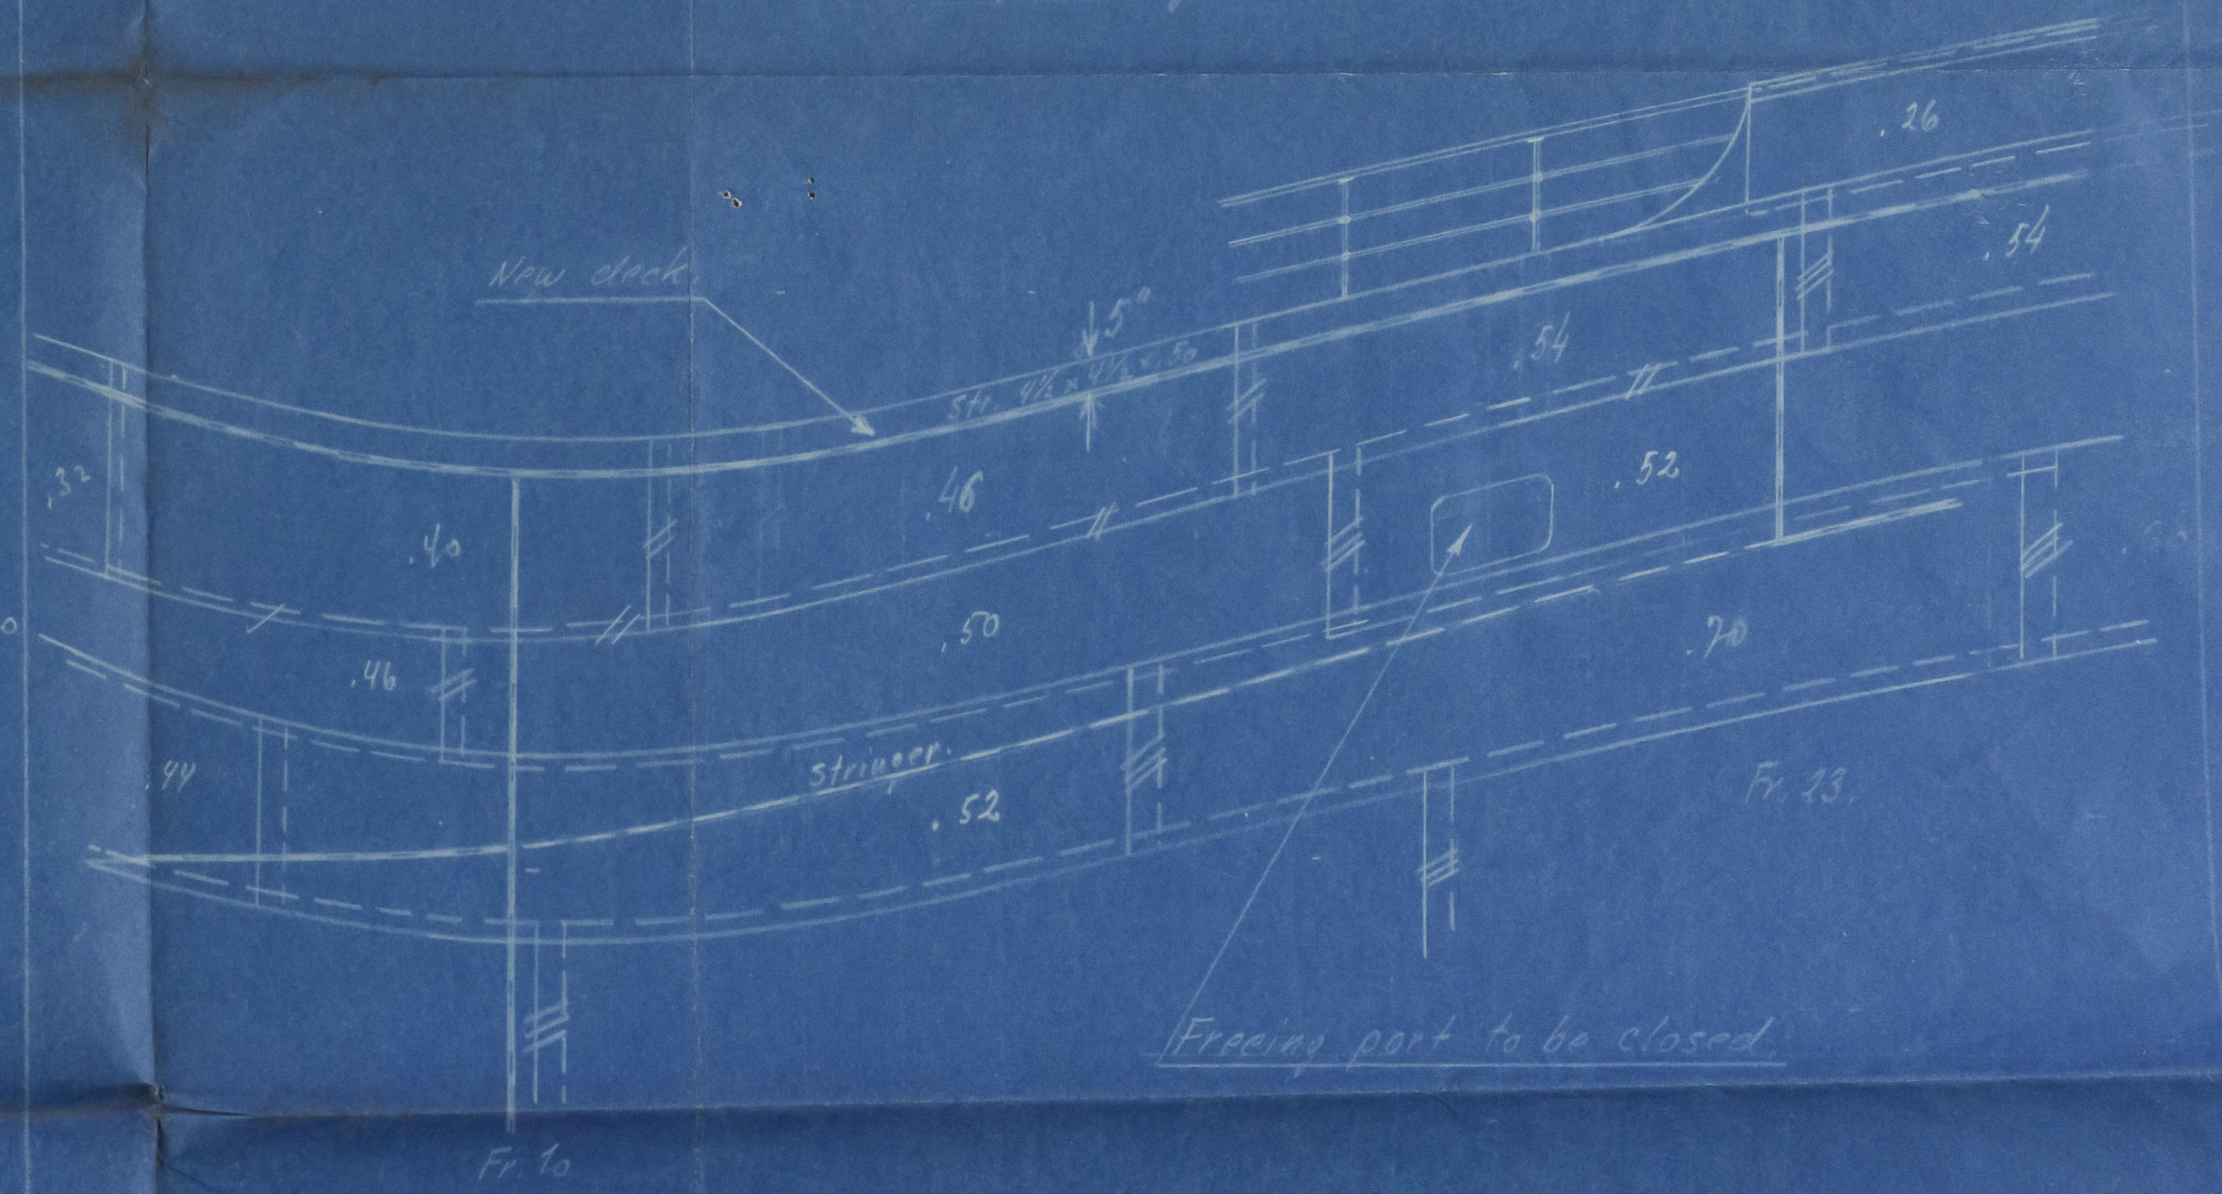

9.07  
 12.3  
 22.5 wt

275-42 x 100  
 200

FREDERIKSHAVNS VÆRFT & FLYDEDOK	Skala 1/2" = 1'	Tegn. 1001	Fr. 6.99
s.s. Svend Pii			
Alteration of shell plating fr. 10-23			
	22994		
	1085		



New Shell Plating in After Well

S/S Svend Pii

Phagen 5 JUL 1949

RPT. NO. Cpn. 12801.

LR  
Surveyor

Copenhagen

Scopus

AIR MAIL

Cpn. Report No.

12801

S/S Svend Pii



© 2020

Lloyd's Register  
Foundation