

8 MAY 1923


# BUILDING NO 24 PROFILE AND PLANS.

LENGTH ON LOADLINE: 276'-4"  
BREADTH MOULDED: 42'-0"  
DEPTH MOULDED, MAIN DECK: 20'-5"  
DEPTH MOULDED, BRIDGE DECK: 27'-5"

CLASS: B.S.\*

SCALE: 1/8" = 1 FOOT

*Approved*  
*23*

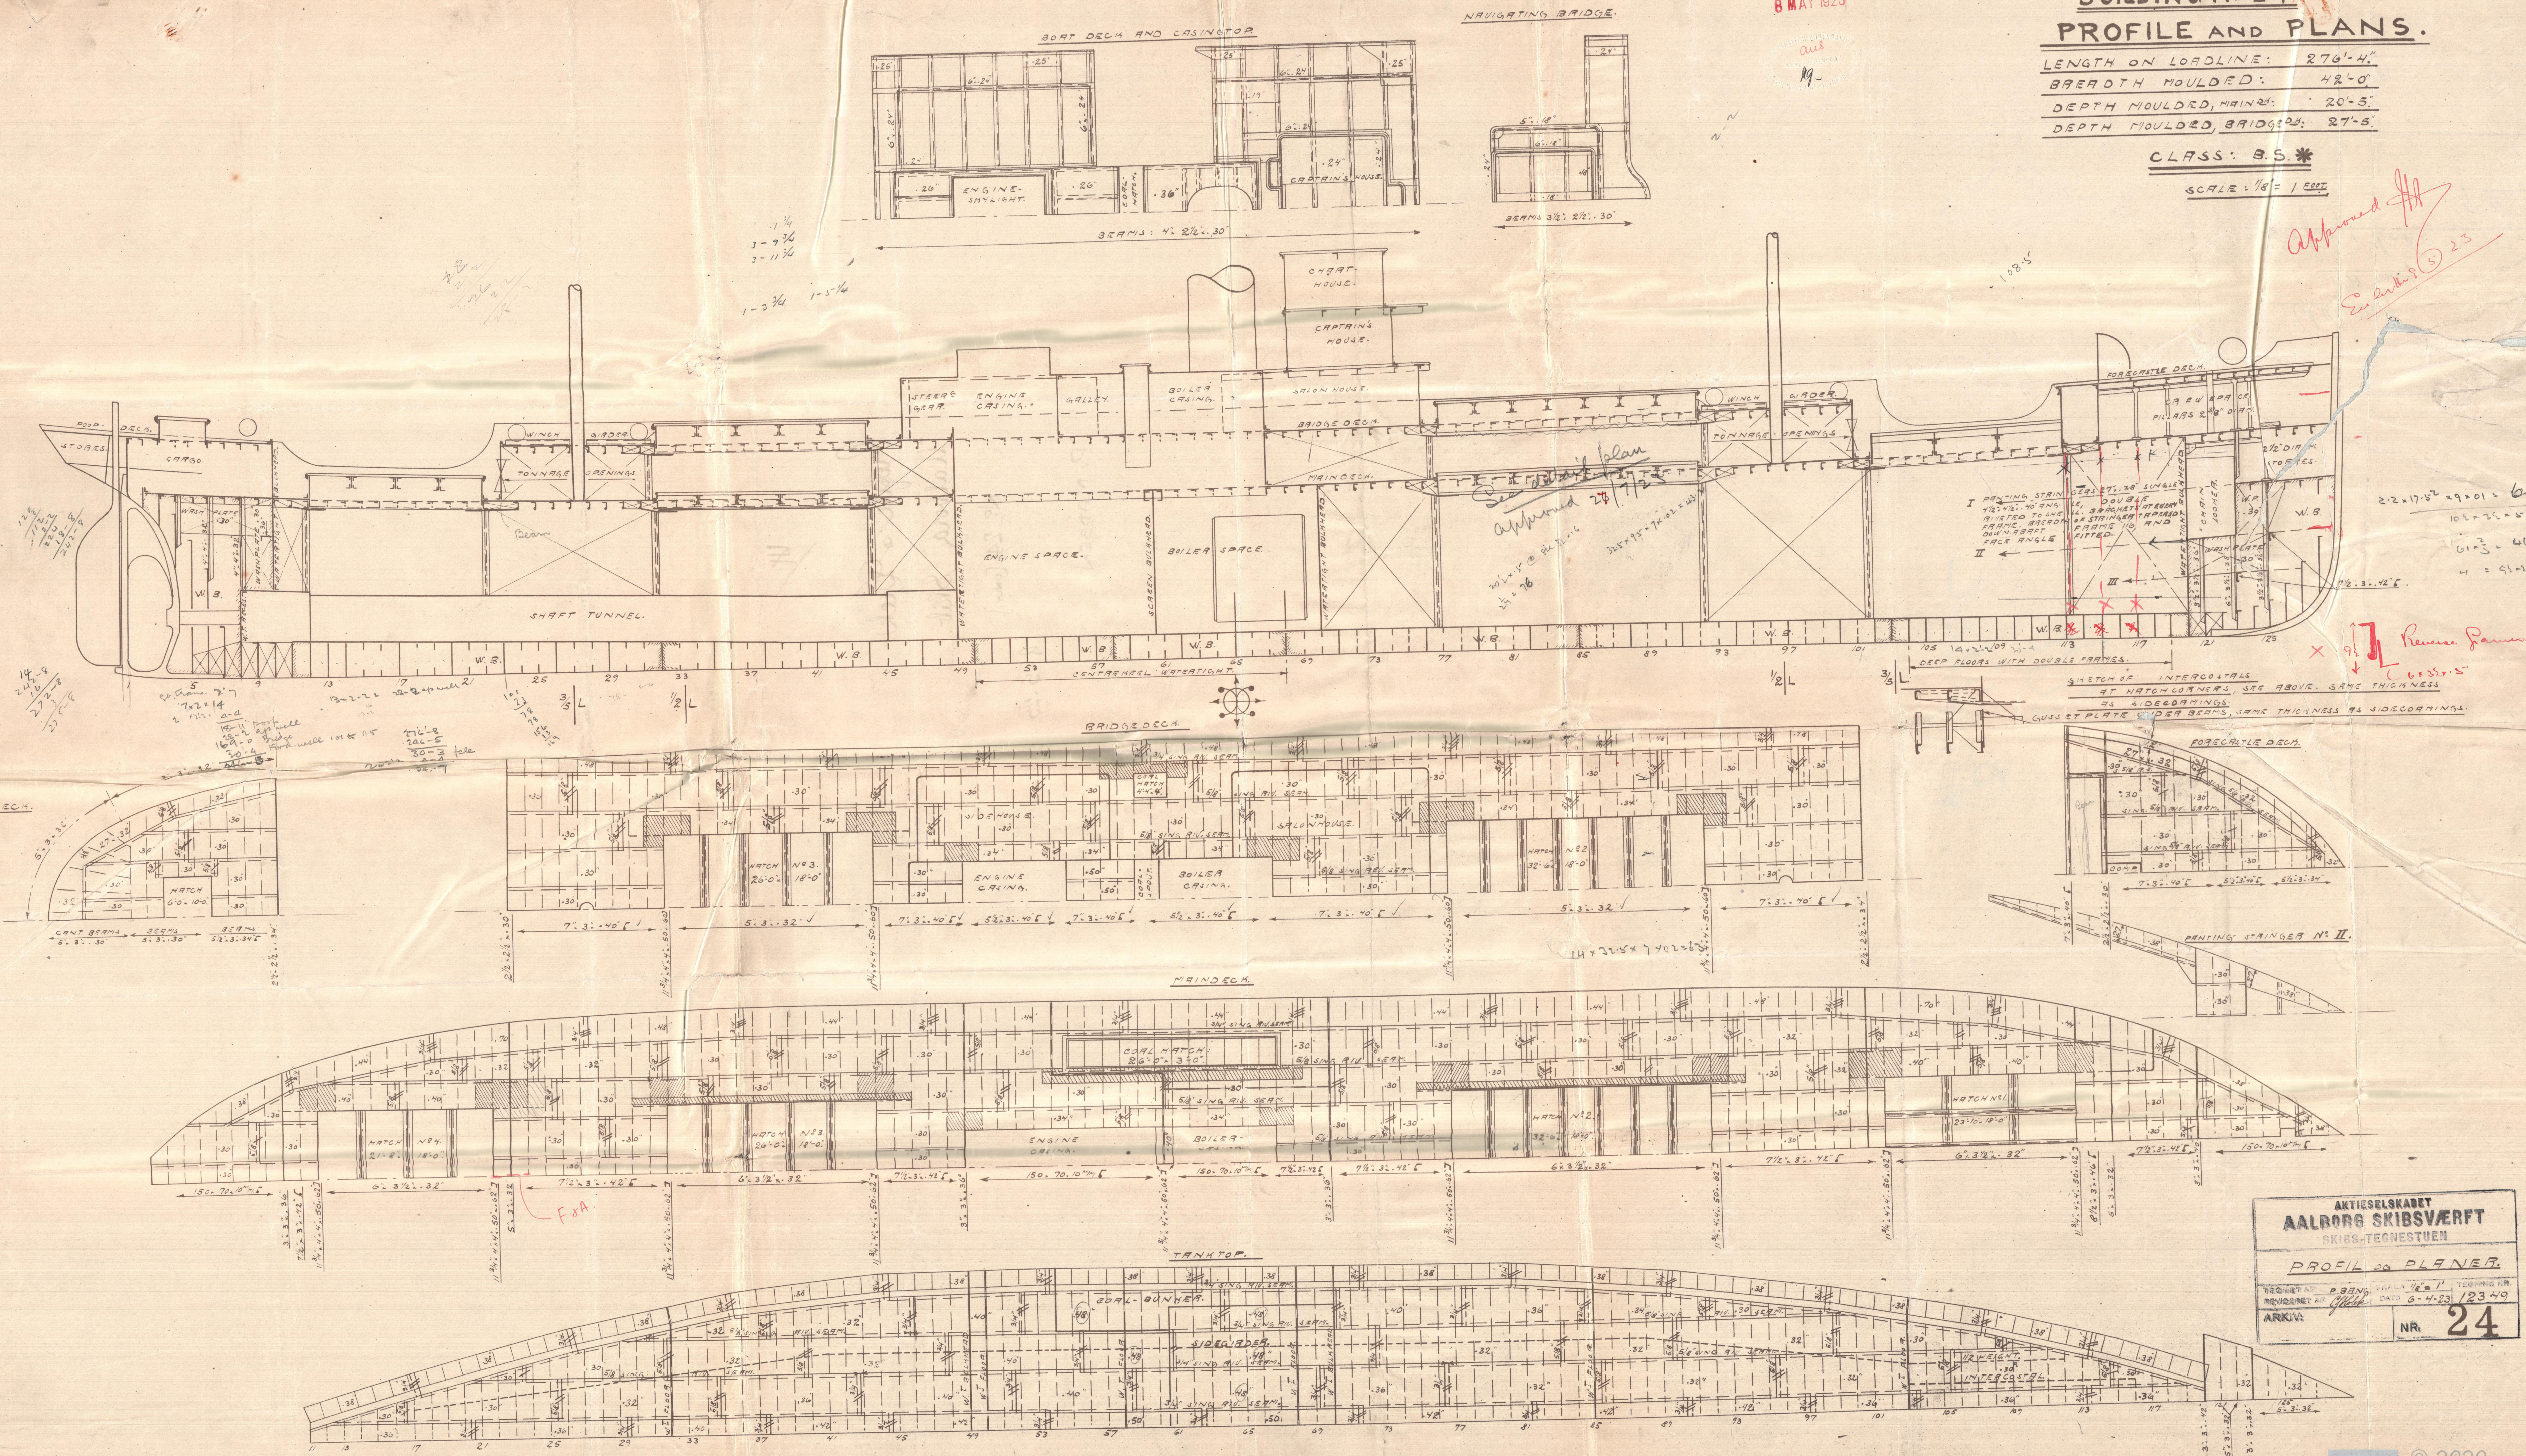

ARTISLSKABET  
AALBORG SKIBSVÆRFT  
SKIBS-TEKNESTUEN  
PROFIL OG PLANER  
TEKNESTUEN  
REVIDERET AF *[Signature]* Dato 6-4-23 12349  
ARKIV NR. 24



24.  
Papers

Aalborg 54  
Profile + decks

Bag

Aalborg  
24 only  
Profile + decks

9.5 73

14





14

Profile & Deck.

"Aalborg" Skib.

Nº 24 [ONLY.]

9-5-22.

"P. MADSEN"

13



© 2020

Lloyd's Register  
Foundation

003321-003327-0037