

SHIP'S NAME Svend Pii REPORT No. _____

THICKNESSES OF PLATING ascertained by drilling, and comparison of same with the original thicknesses.

The thicknesses are in hundredths of an inch.

Frame 65


Frame 117

Frame 9

| FRAME | AMIDSHIP. | | | | | FORWARD. | | | | | AFT. | | | | | REMARKS. |
|-------|---------------------|------------------------|------------------|--------------------|------|---------------------|------------------------|------|--------------------|------|---------------------|------------------------|------------------|--------------------|------|----------------|
| | Original Thickness. | Thickness by drilling. | | Diminution if any. | | Original Thickness. | Thickness by drilling. | | Diminution if any. | | Original Thickness. | Thickness by drilling. | | Diminution if any. | | |
| | | Port. | Std. | Port. | Std. | | Port. | Std. | Port. | Std. | | Port. | Std. | Port. | Std. | |
| DECK | L .54 | .56 | .48 | - | 4 | .38 | .40 | .38 | - | - | .32 | .32 | .32 | - | - | |
| " | K .52 | .44 | .44 | 9 | 8 | .38 | .40 | .40 | - | - | .46 | .44 | .48 | 2 | - | |
| RAKE | J .52 | .44 | .48 | 8 | 4 | .52 | .52 | .56 | - | - | .52 | .52 | .52 | - | - | |
| below | H .56 | .34 ^W | .36 ^W | 22 | 20 | .52 | .52 | .52 | - | - | .42 | .44 | .40 | - | 2 | W |
| " | G .56 | .48 | .44 | 6 | 12 | .50 | .56 | .56 | - | - | .46 | .52 ^W | .28 ^W | - | 18 | Plates renewed |
| " | F .56 | .56 | .54 | | 2 | .44 | .48 | .48 | - | - | .44 | .52 ^W | .32 ^W | - | 12 | this time. |
| " | E .54 | | | | | .48 | .48 | .48 | - | - | .50 | .44 ^W | .32 ^W | 6 | 18 | |
| " | D .52 | | | | | .48 | .48 | .48 | - | - | .50 | Steel | | | | |
| " | C .52 | | | | | .52 | .52 | .44 | - | 8 | .42 | .44 | .40 | - | 2 | |
| " | B .52 | | | | | .52 | .48 | .40 | 4 | 12 | .44 | .40 | .48 | 4 | - | |
| " | A .52 | | | | | .52 | .48 | .52 | 4 | - | .50 | | | | | |
| L | .80 | | | | | | | | | | | | | | | |

cement

Drillings at ends to be made in the vicinity of the peak bulkheads.

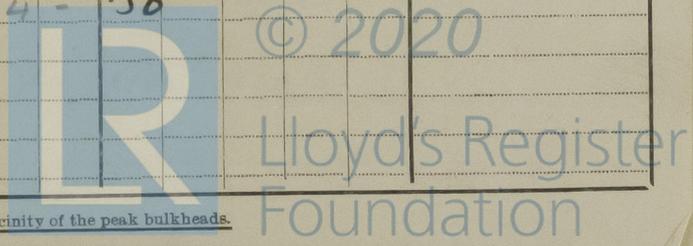

003321-003327-0051

To the Surveyors