



MAIN CARGO TANKS			
TANK NO.	LOCATION	GALLONS	BARRELS (WT)
2	FR 68-71	391589.9	9321.57
3	65-68	391928.0	9331.64
4	62-65	391885.6	9330.61
5	59-62	391473.5	9360.00
6	56-59	391687.9	9325.90
7	53-56	391329.3	9317.36
8	50-53	391485.0	9320.36
9	47-50	385098.9	9168.97
TOTAL		3126466.8	74439.21

SIDE CARGO TANKS				
TANK NO.	LOCATION	GALLONS	BARREL SIZE	
1 - P	FWB 71 - 72	10 682.22	25.43	40
2 - P	71 - 72	10 428.3	25.33	40
3 - P	68 - 71	10 736.6	31.18	76
4 - P	68 - 71	10 736.6	31.17	76
5 - P	65 - 68	10 372.16	30.89	133
6 - P	65 - 68	10 372.16	30.89	133
7 - P	62 - 65	10 699.7	40.55	38
8 - P	62 - 65	10 699.7	40.55	38
9 - P	59 - 62	17 010.3	40.47	86
10 - P	59 - 62	17 010.3	40.47	86
11 - P	56 - 59	17 010.3	40.47	86
12 - P	56 - 59	17 010.3	40.47	86
13 - P	53 - 56	18 930.5	40.45	92
14 - P	53 - 56	18 930.5	40.45	92
15 - P	50 - 53	17 686.6	39.92	60
16 - P	50 - 53	17 686.6	39.92	60
17 - P	47 - 50	15 219.2	36.40	42
18 - P	47 - 50	15 219.2	36.40	42
TOTAL		880 913.9	67 718.10	
TOTAL CARGO		592 864.9	141 158.1	

FUEL OIL TANKS			
TANK NO.	LOCATION	GALLONS	BARRELS
WING TANK	FR - 36 - 45 P.	104687.5	2497.54
WING TANK	36 - 46 S.	104687.5	2497.54
DEEP TANK	75 - 89 S.	99485.0	2369.69
DEEP TANK	75 - 89 R.	99605.4	2371.51
TOTAL FUEL		408465.4	9739.28

BALLAST TANKS AND COFFERDAMS		
TANK	LOCATION	TONS S
FORE PEAK	FR ^W 89 - FORD	314.23
DEEP TANK	75 - 89 R	380.17
DEEP TANK	75 - 89 S.	379.10
COFFERDAM	73 - 75 F	66.47
COFFERDAM	73 - 75 S.	66.47
COFFERDAM	46 - 47 F.	57.11
COFFERDAM	46 - 47 S.	57.11
AFT PEAK ^W BALLAST OR WASH WATER	0 - 9	60.07
TOTAL BALLAST		1380.73

FRESH WATER TANKS		
TANK	LOCATION	TONS F.W.
FEED WATER		
BOILED WATER	FR. # 10 - 18 ENG. RM.	36.30
INNER BOTTOM T.	" 11 - 27 PORT	41.80
DO.	" 11 - 24 STD.	31.41
DO.	" 27 - 44 PORT	77.15
DO.	" 27 - 44 STD.	70.82
TOTAL FEED WATER		256.79
DRINKING WATER		
F.W. TANKS	STEEL'S #6 PLAT. FR. # 10	86.88
DO	UNDER BRIDGE SK. P.	35.37
DO	UNDER BRIDGE SK. S.	26.57
TOTAL DRINKING WATER		99.30

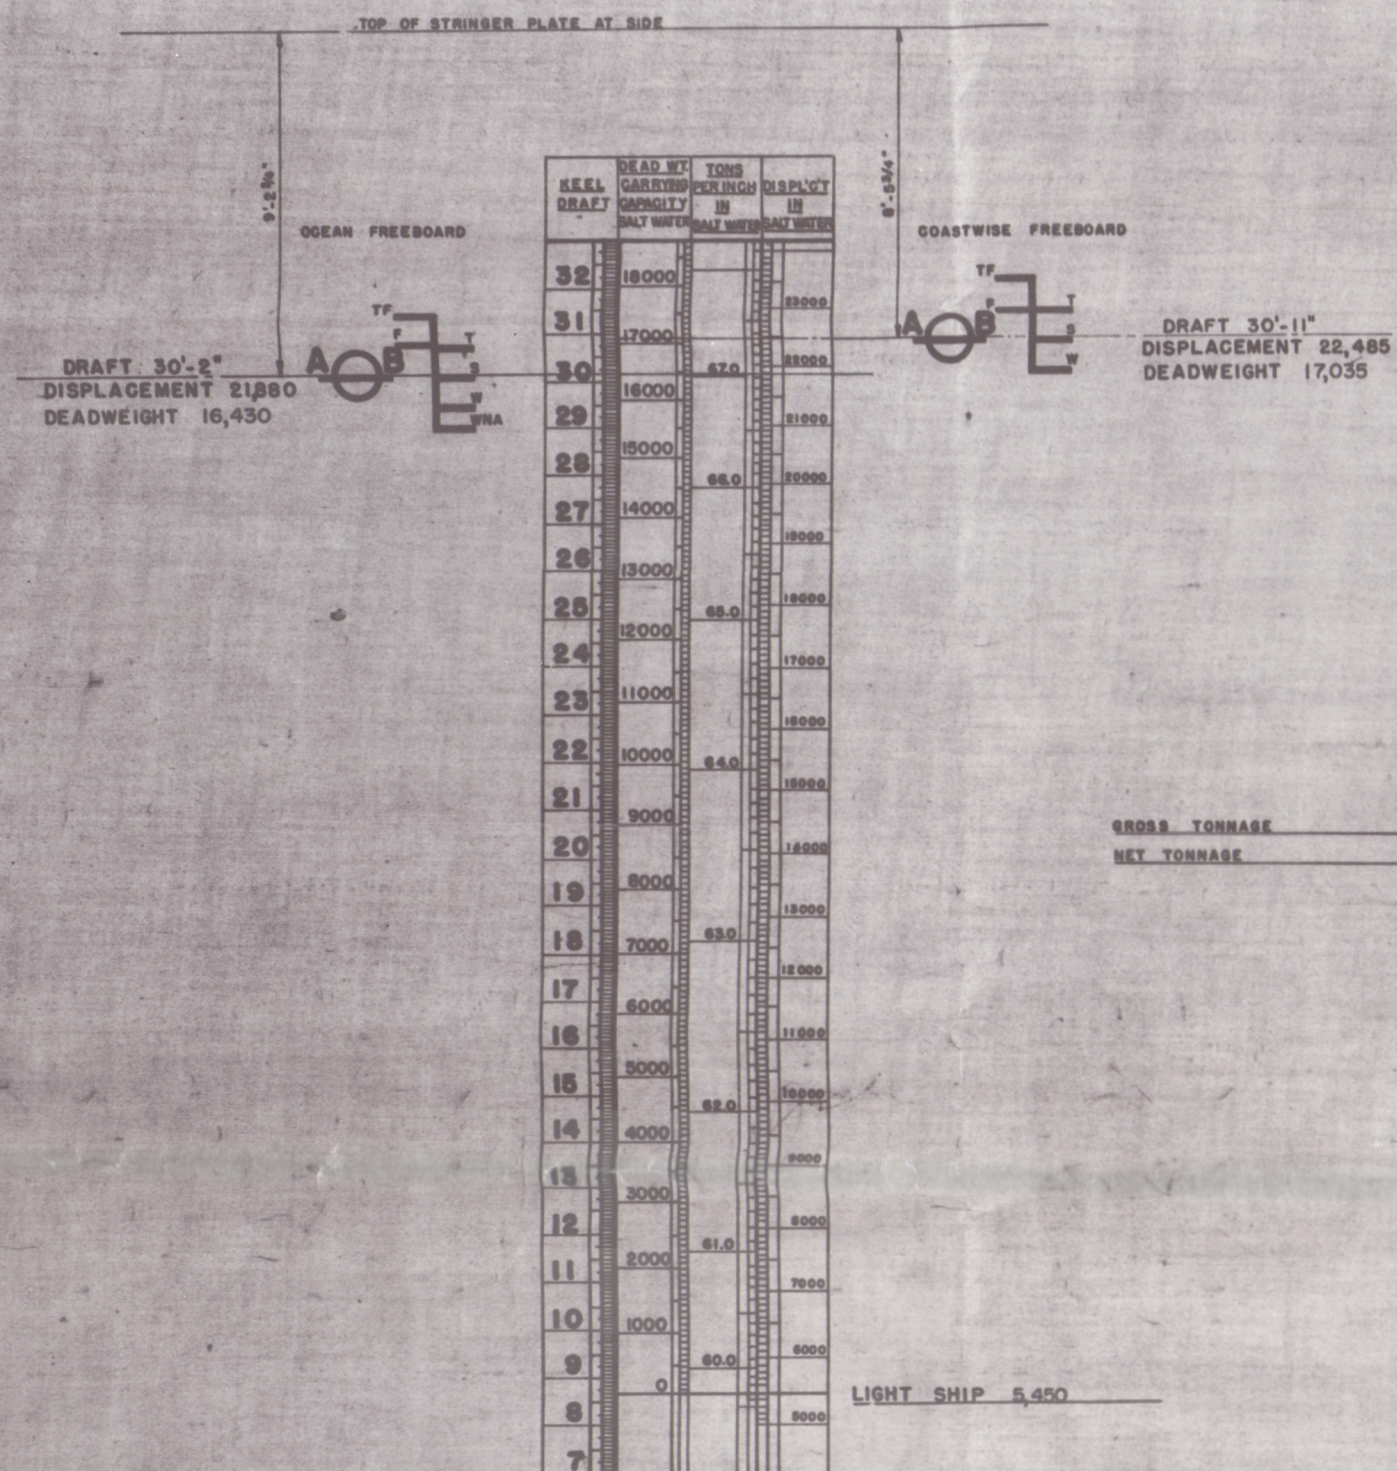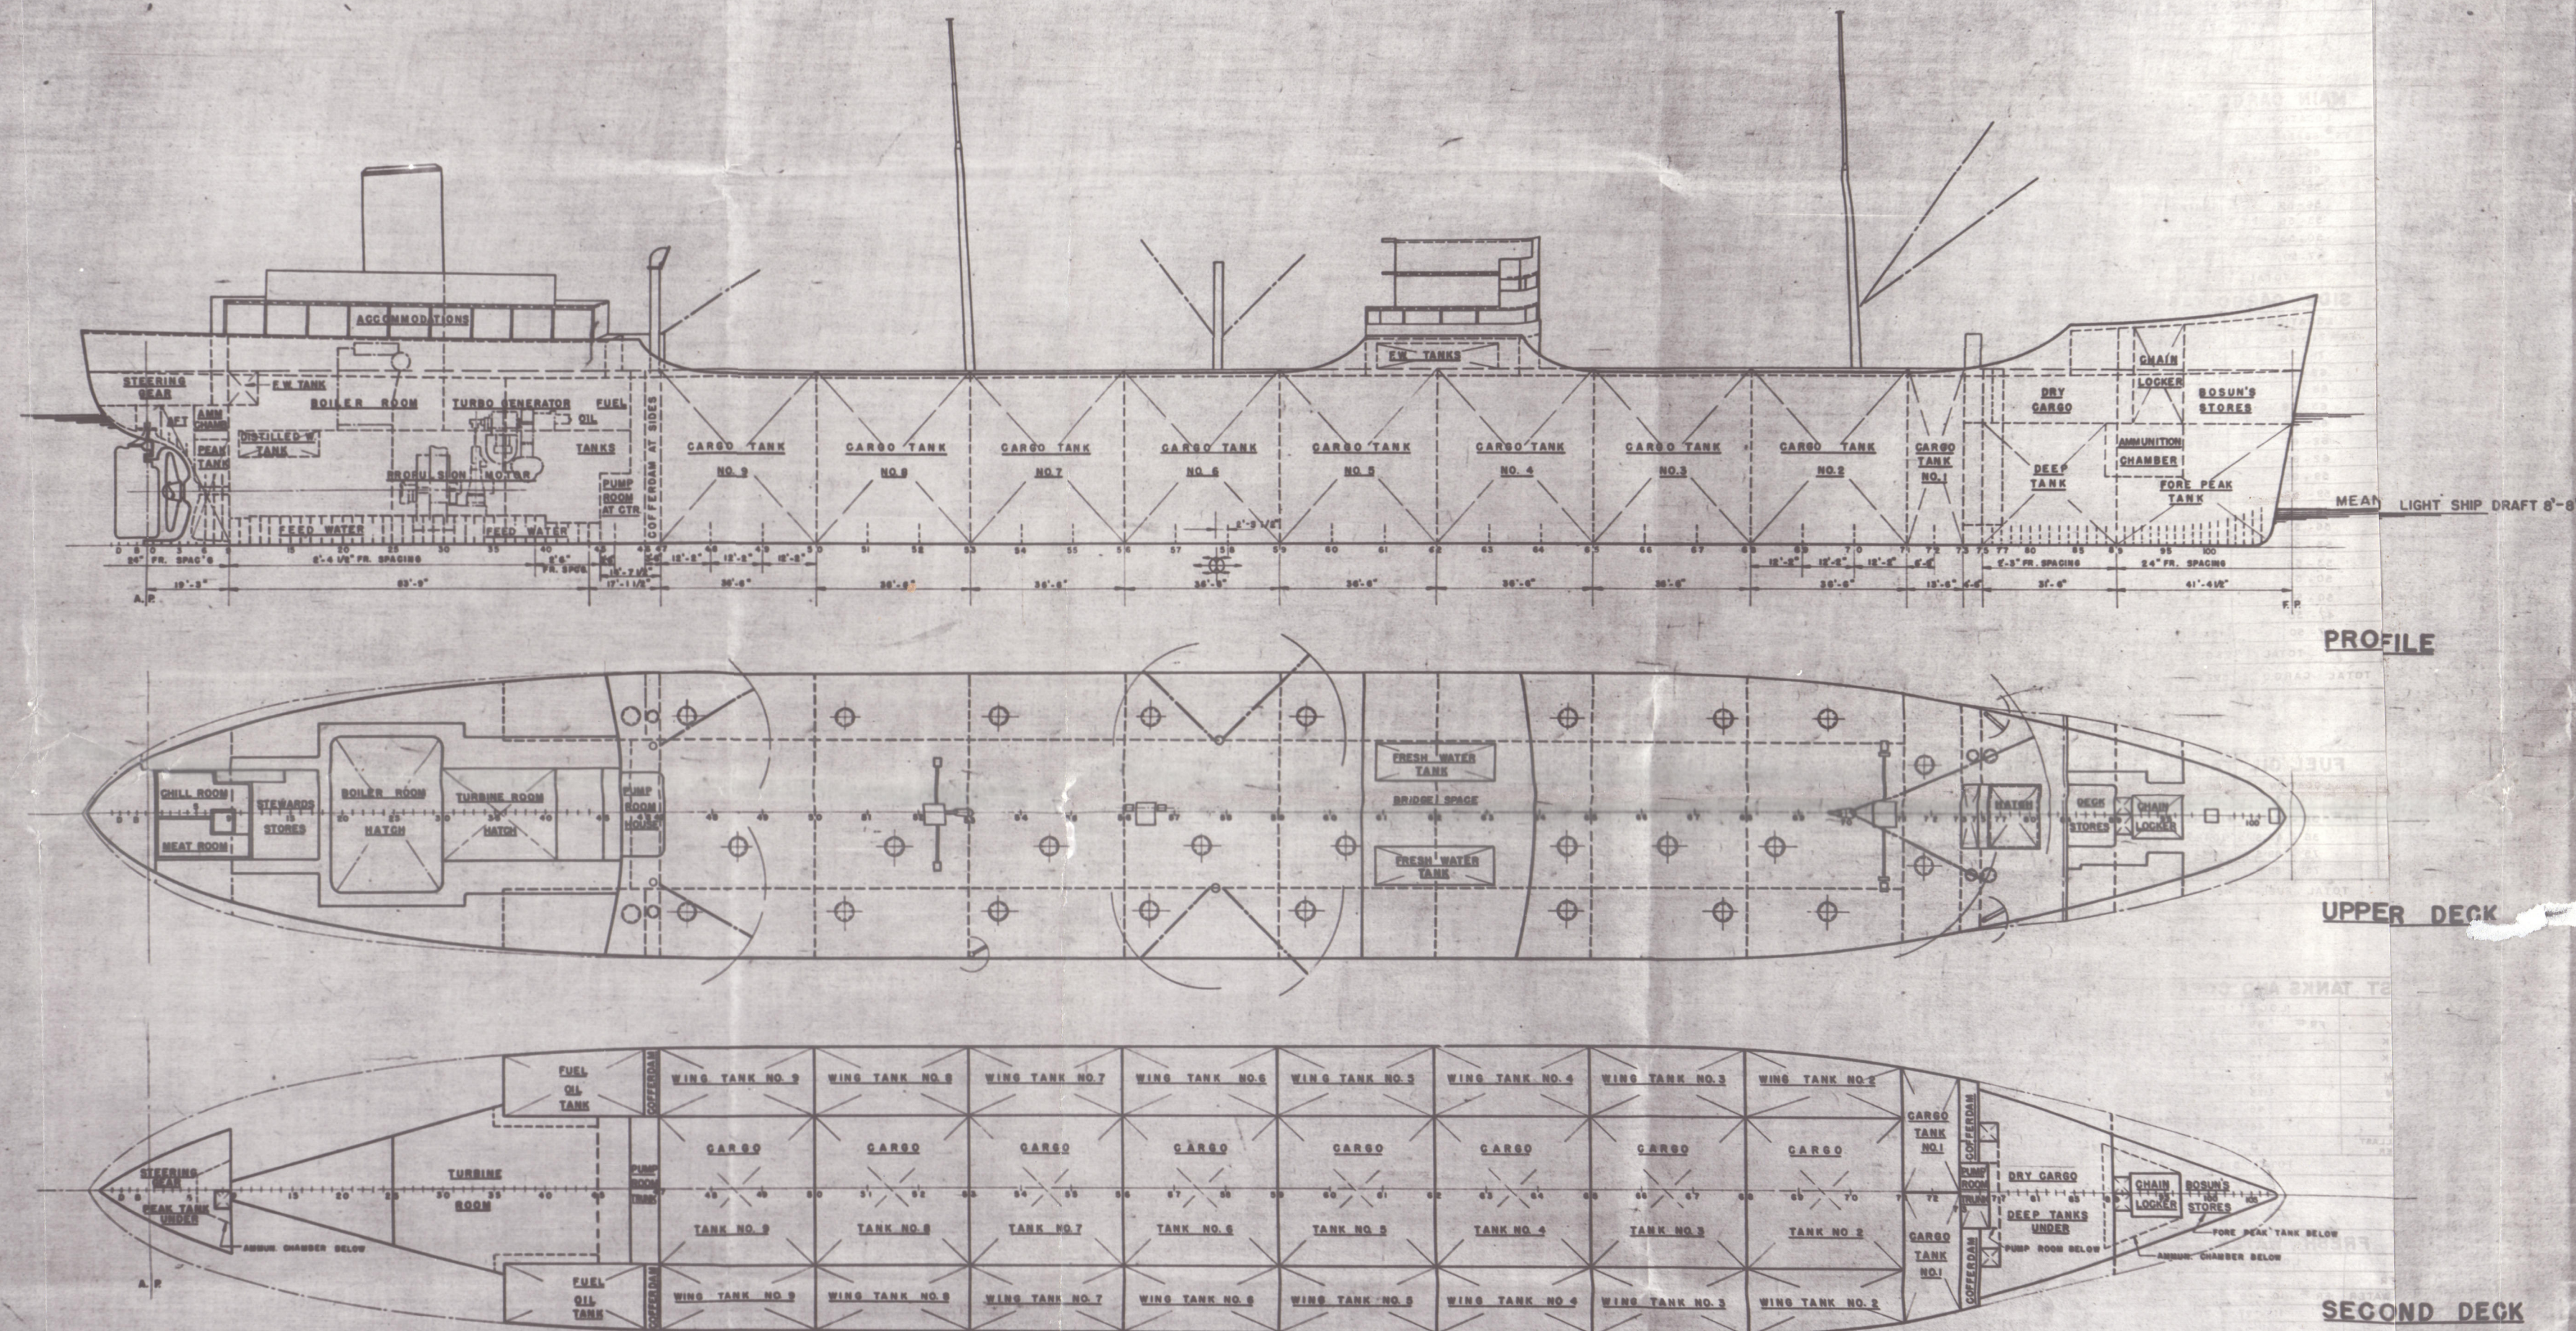

NOTE: THE LIGHTSHIP WEIGHT OF THE VESSEL AS DETERMINED FROM DEADWEIGHT DETERMINATION MADE ON ORIGINAL TANKERS IS 8,480 LONG TONS. THIS LIGHTSHIP WEIGHT IS THE WEIGHT OF THE VESSEL COMPLETE, AND READY FOR SEA IN EVERY RESPECT. IT INCLUDES THE WEIGHT OF DECKS IN MACHINERY, FIRE AND SANITARY LINES, FUEL OIL SYSTEMS, SPARE PARTS, BOSUN'S AND LEAD STORES, MATTRESSES AND BEDDING.

LIFE BOATS					
NO.	LENGTH	PERSONS	PROPELLED	LOCATION	WEIGHT
1	22'	16	MOTOR BOAT	MIDSHIP	1.3
1	22'	20	ROWBOAT	MIDSHIP	.9
3	22'	20	ROWBOAT	AFT	2.8
	22'	16	MOTORBOAT	AFT	1.2

BATTERY			
NO	TYPE	LOCATION	WEIGHT
1	AFT GUN	AFT	9.4
1	FWD GUN	FWD	3.0
4	20 M.M. ANTI-AIRCRAFT	MIDSHIP	2.9
4	20 M.M. ANTI-AIRCRAFT	AFT	2.9

PLASTIC ARMOR: ON MHP DECK HOUSE - WEIGHT ADDED	7.0
SUN PLATFORMS AND SULBARKS	TOTAL WEIGHT 46.4
AMMUNITION STOWAGE	TOTAL WEIGHT 8.0
ADDITIONAL QUARTERS FOR GUNNERS	TOTAL WEIGHT 14.7
DEBAUSSING SYSTEM	TOTAL WEIGHT 19.8
CARGO DECK	TOTAL WEIGHT 78.4

LIFE RAFTS AND FLOATS				
NO.	TYPE	PERSONS	LOCATION	WEIGHT
2	LIFE RAFT	20	CARGO DK. FWD.	2.0
2	LIFE RAFT	20	CARGO DK. AFT.	2.0
1	FLOAT RAFT	15	MIDSHIP DK. MSE	0.15
1	FLOAT RAFT	15	AFT. DK. MSE	0.15

THE FOLLOWING ITEMS ARE NOT INCLUDED IN THE LIGHT SHIP WEIGHT: AMMUNITION, FUEL OIL IN SETTLING OR STOWAGE TANKS, LUBE OIL IN SETTLING OR STORAGE TANKS, FRESH WATER IN CULINARY OR FEED WATER TANKS, CONSUMABLE REFRIGERATED OR DRY STORES AND CREW AND THEIR EFFECTS.

[illegible][illegible]

	DISTRIBUTION

T2-SE-AI TANKER
USMC HULLS-1914-60, 2393-2430, 2720-25, 2843-53

UNITED STATES MARITIME COMMISSION

EFFECTIVE HULL 57-USMC 1914

KAISER COMPANY, INC. K-700-9

PORTLAND, OREGON

CAPACITY PLAN

~~S.S. COUNCIL CREST~~

TROCHURUS

LE NOMS _____ DATE 12-17-63
 SIGNATURE _____

TRADED ☒ APPROVED ☒
CHECKED ☒ NAVAL ARCHITECT

APPROVALS

U.S.M.C. *John Griffith* 12-17

DRWG. NO.	K-700-8	ALT. A
-----------	---------	--------




"TROCHURUS"



Capacity plan

RECORDS DEPT.
LONDON

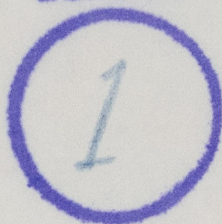

© 2020

Lloyd's Register
Foundation

003324-003332-0002