


3/8 EGLANTIER  
DISPOSITION OF MAIN MAST WITH  
10 TON DERRICK *See letter 16-2-22*  
MAST, DERRICK & RUNNING GEAR OF  
EX 3/8 BOLIVIER



6  
*Seca*

*(ex S.S. EGLANTIER.)*

*mainmast alteration*

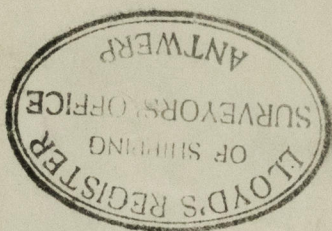

© 2020

Lloyd's Register  
Foundation

003328-003332-0119