


SINGLE SCREW STEEL COASTER

YARD No 334

SCALE 1/4" = 1' 0"





DIMENSIONS - 190' 8" B.P. x 30' 9" MLD. x 13' 9" MLD.

TO CLASS LLOYDS 100A1

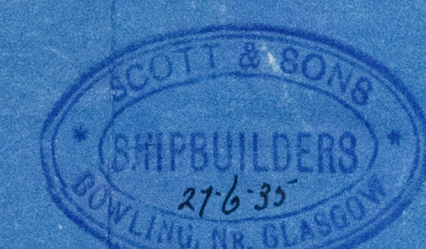



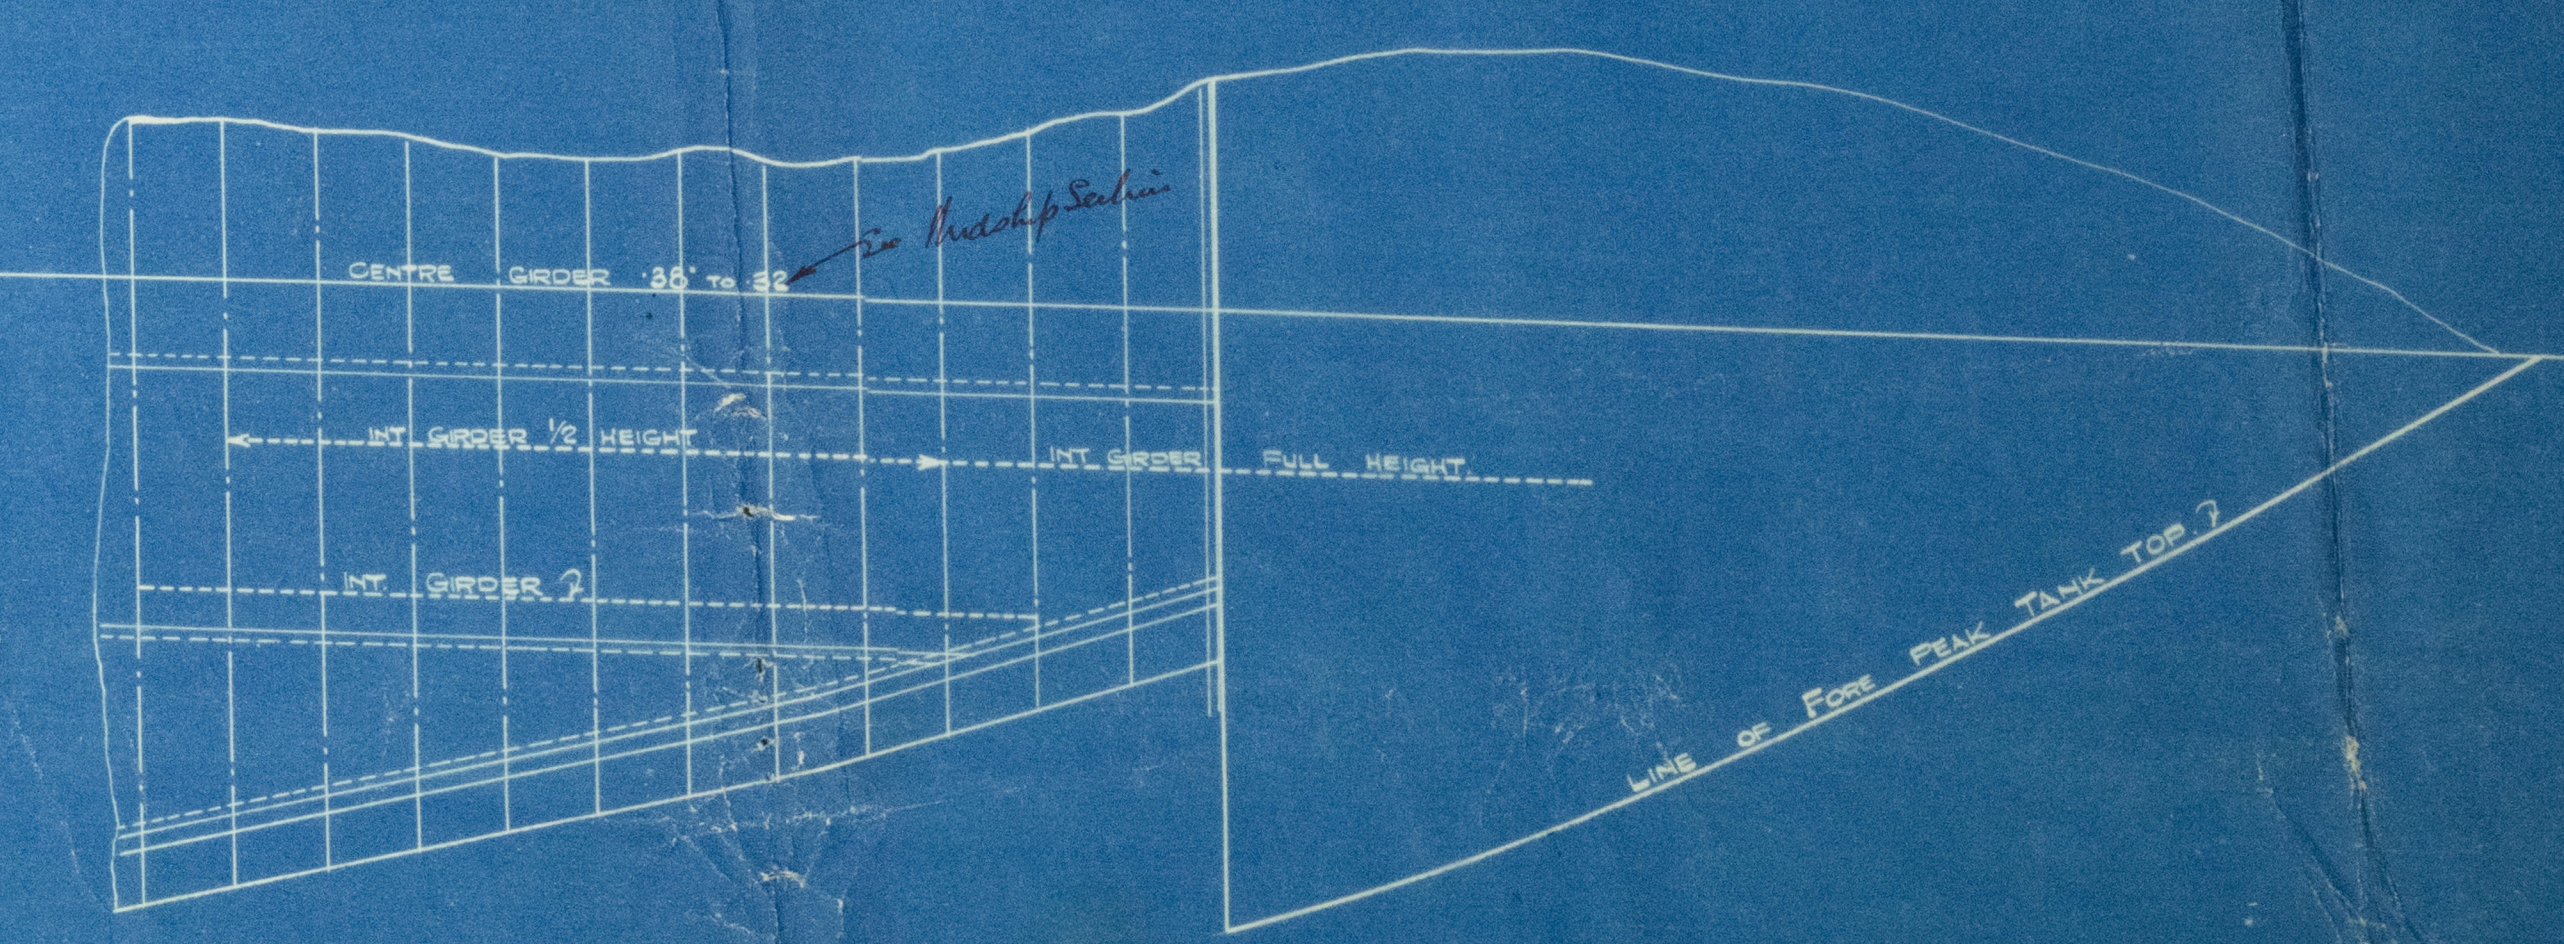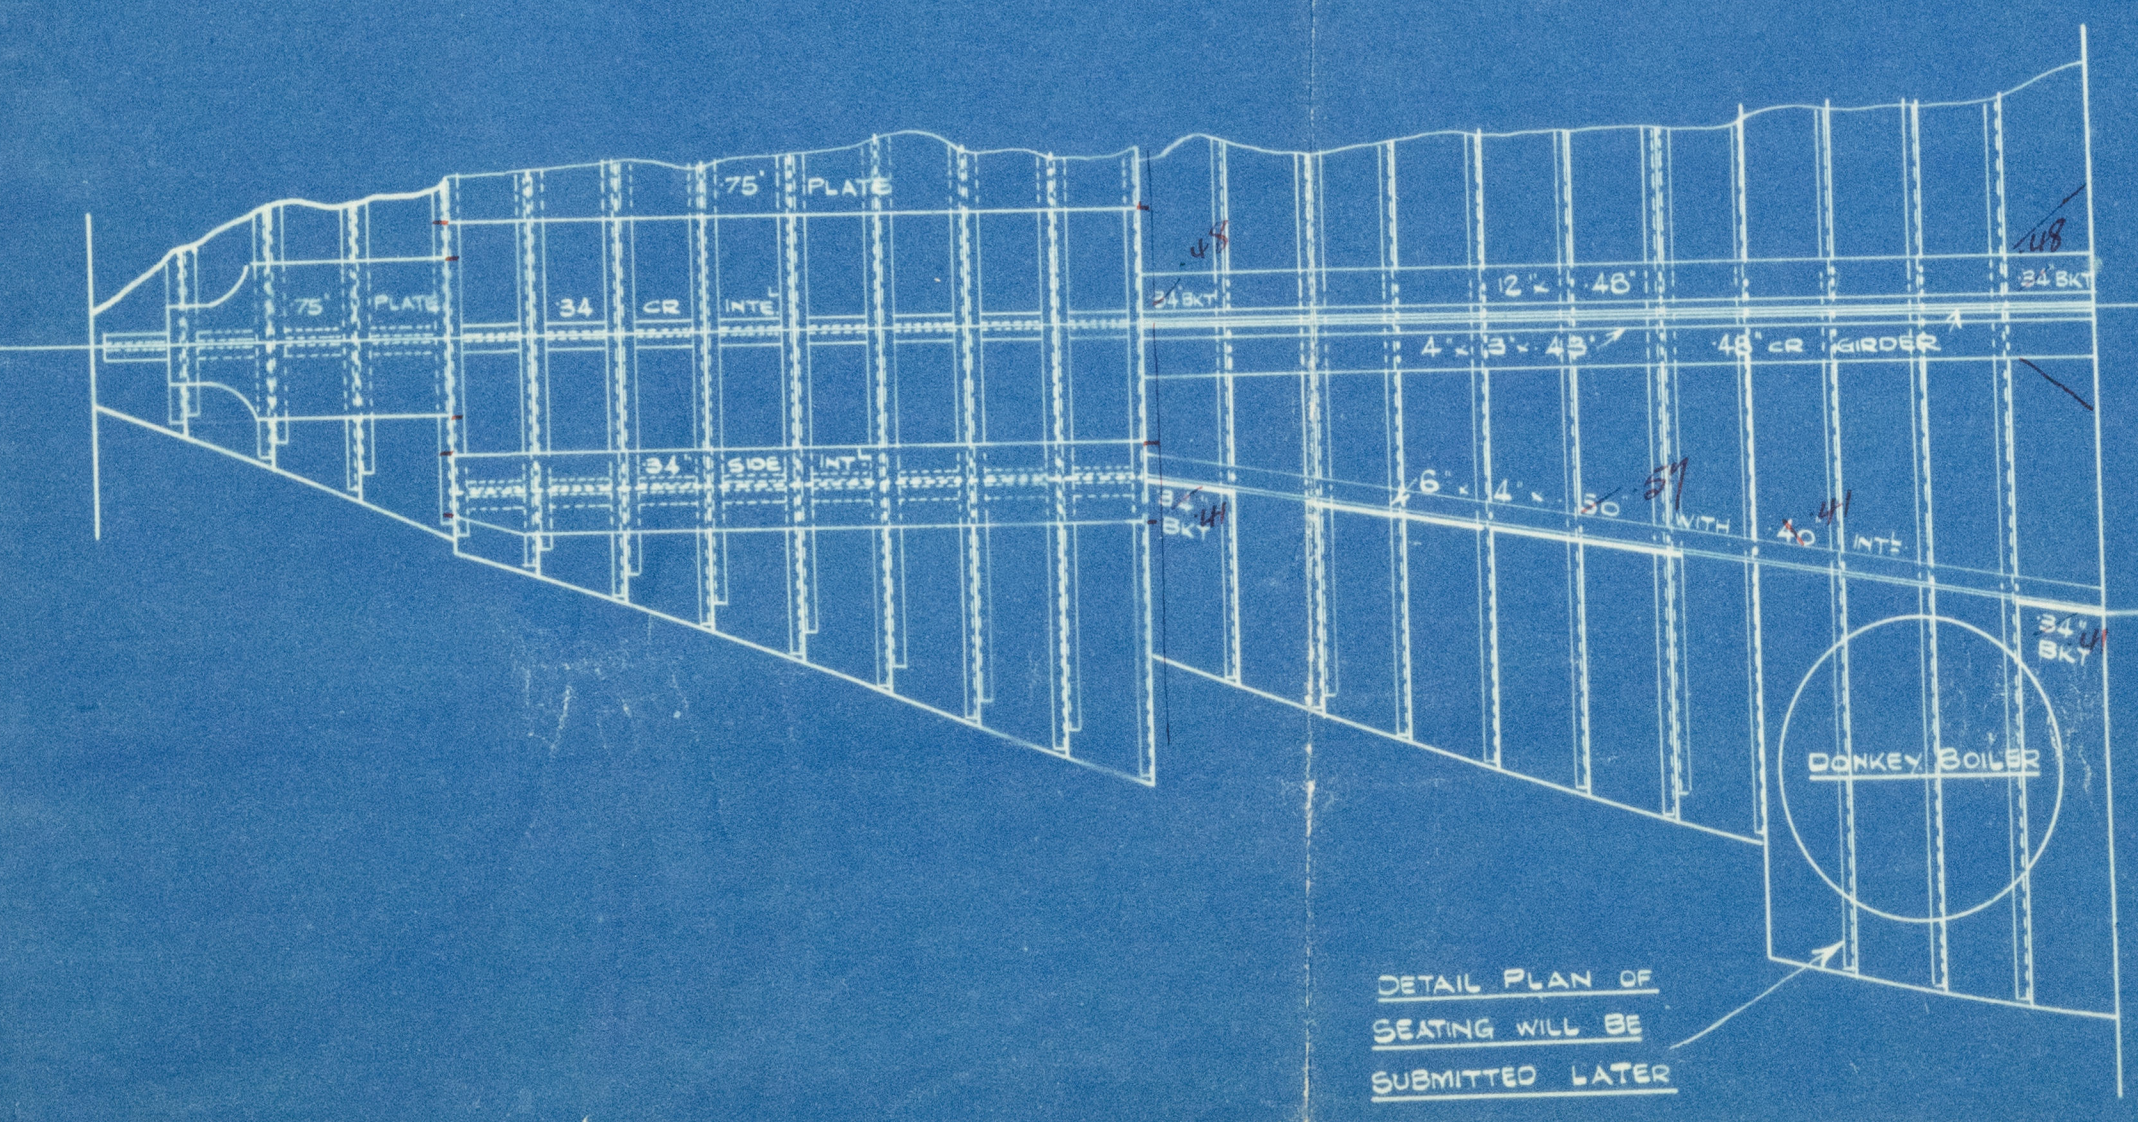  

APPROVED
LLOYD'S REGISTER OF SHIPPING
DATE 12/7/35



Messrs Scott & Son

Yard N^o 334

Profile & Decks

Gls. rfd. 55924

Yhd

GLASGOW REPORT No. 56351

Kahoon

GLASGOW REPORT No. 56559

$\frac{1}{4}$ 5 5 25
 18
 256



© 2020

Lloyd's Register
Foundation

003332-003332-0165