


ALL SECTIONS NEW BRITISH STANDARD

ALEXANDER STEPHEN & SONS, LTD.  
OLDERS  
ENGINEERS  
GLASGOW  
PLAN NO 2  
DATE 15/12/36

lunches, windlass, steering gear, deckhouse  
etc supported to surveyors satisfaction

— 4/4 EXTENDED 9/47  
90. 71285.

 

APPROVED  
LLOYD'S REGISTER OF SHIPPING  
*Richardson* © 2020  
DATE 6-1-87  
R Lloyd's Register  
Foundation

2/


Glasgow

Messrs. Alex. Stephen Lownd

Yard No 534.


Profile <sup>banton</sup>+

RETAIN

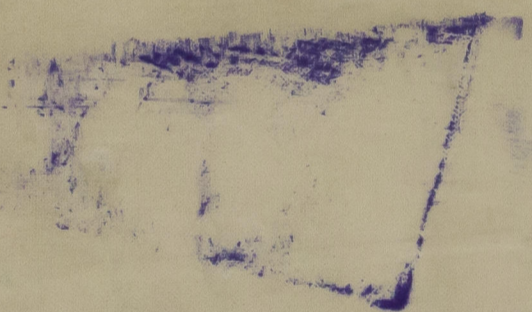


<sup>4</sup>bd  
GLASGOW REPORT No 60043

Canton  
GLASGOW REPORT No 60190

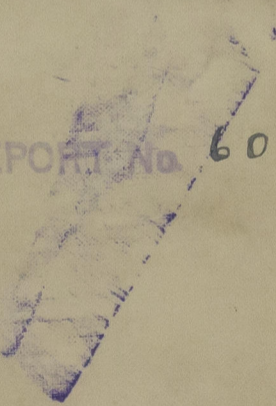

12-11-1900.

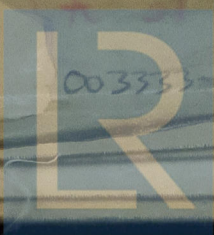

© 2020  
003333-003340-0129

Lloyd's Register  
Foundation