


N° 557

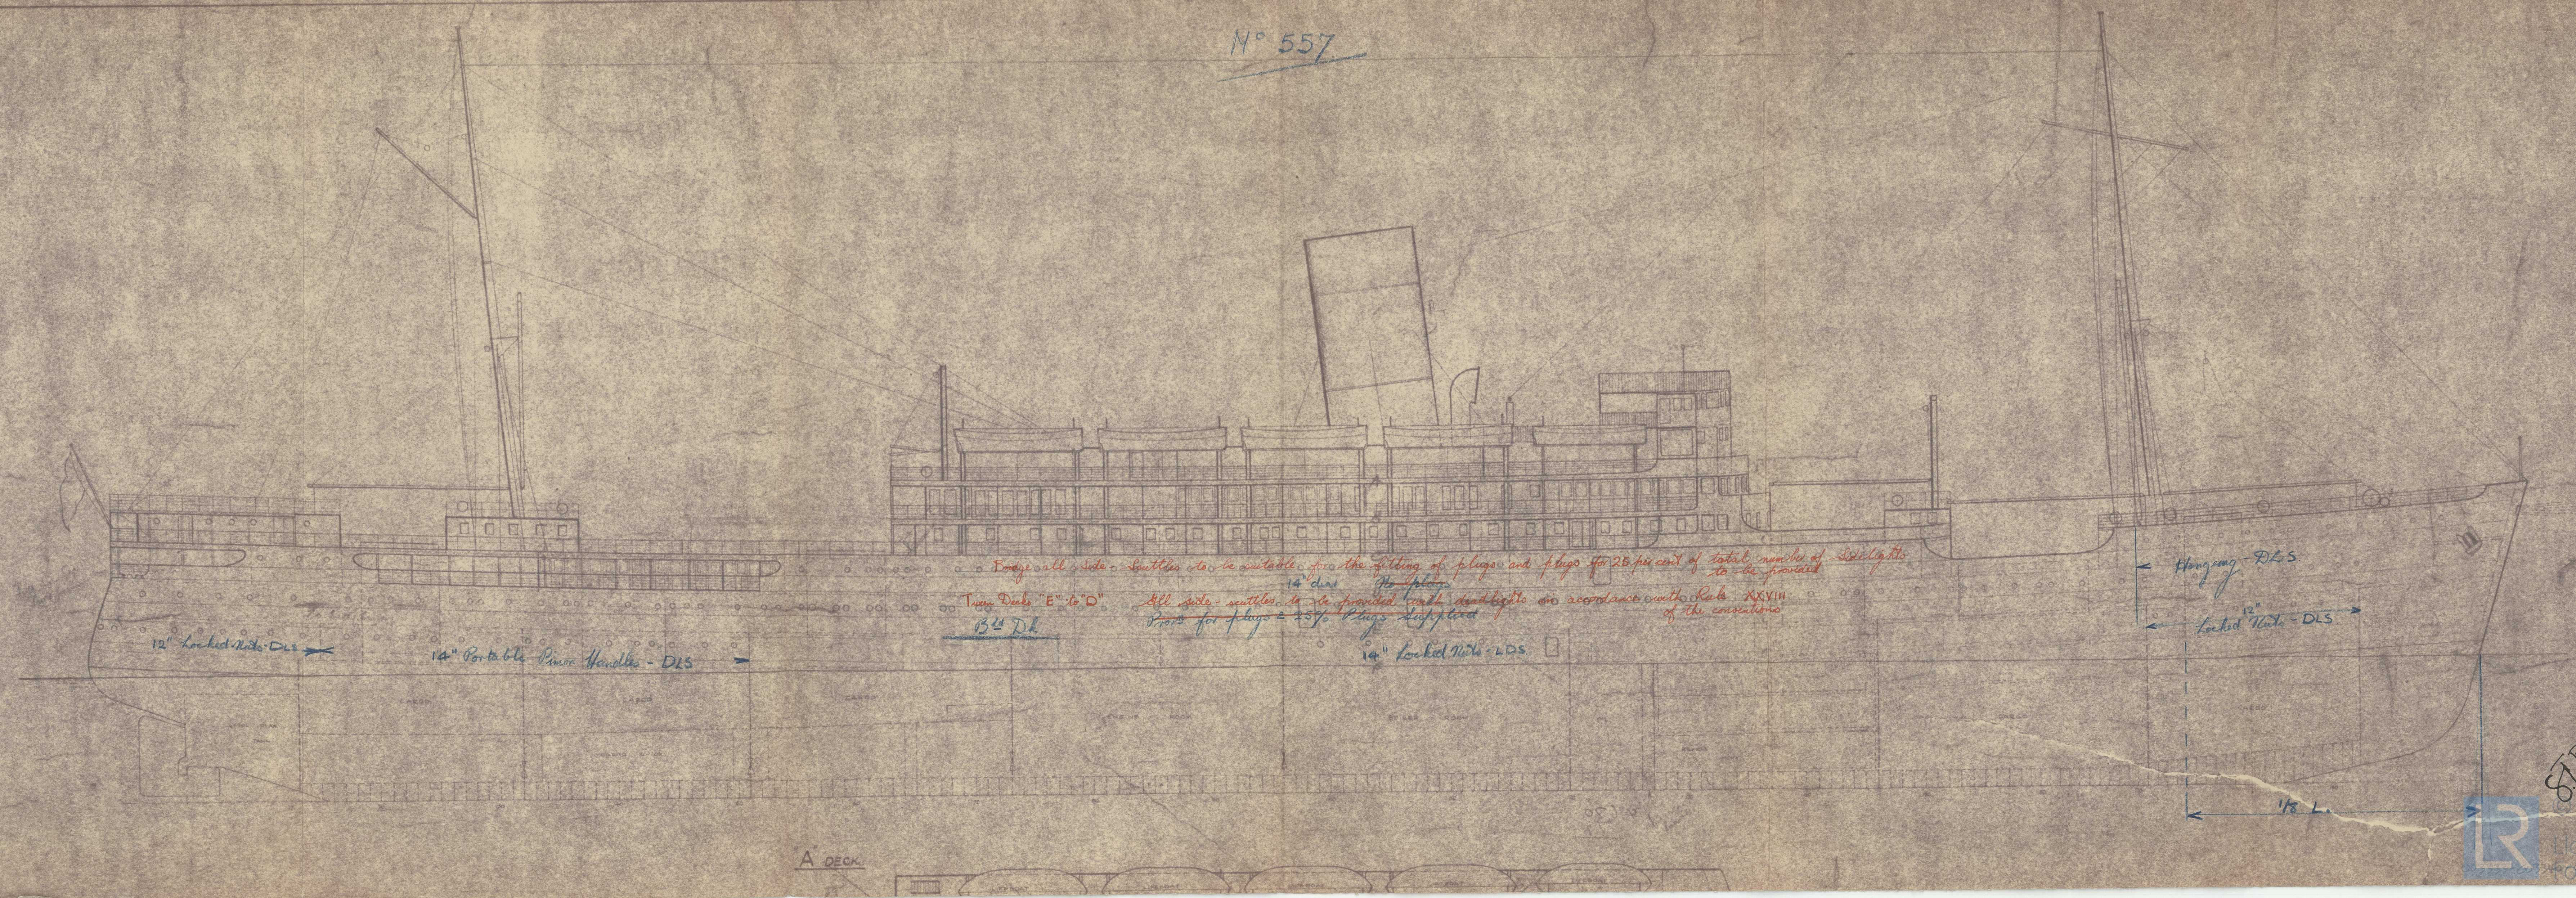

A Stephen Tom.

557.



© 2020

Lloyd's Register
Foundation

003333-003340-0131