

No. 38. S.S.
STEEL SCREW PILOT CUTTER.
PROFILE & DECK PLAN.

SCALE 1/4 INCH = 1 FOOT.

DIMENSIONS: LENGTH B.P. 90'-0"
 BREADTH MLD. 19'-6"
 DEPTH " 10'-6"

TO CLASS 100. A.I. 1923-24 RULES.

AFT PEAK BULKHEAD. N° 36 FRAME.

PLATING. 28.30 BOTTOM PLATE. 32.

STIFFERS. 4 x 3 x 30. SPACED. 24" APART. (BRACKETED AT DECK ONLY)

SHELL ANGLE. 3 x 3 x 36. DECK 3 x 3 x 36.

O.F. BUNKER & BOUNDARY BULKHEAD.
 PLATING. 30. BOTTOM PLATE. 32.
 STIFFERS. 4 x 3 x 30. SPACED 18" APART. FORE & AFT.
 BOUNDARY ANGLES. 4 x 4 x 32.
 CLEAR OF BUNKERS. STIFFERS. SPACED. 30" APART.

W.T. part of hull & etc.

W.T. BULK² N° 36. FRAME.

PLATING. 28. BOTTOM PLATE. 32.37

STIFFERS. 5 x 3 x 36. SPACED. 30" APART. (BRACKETED)



SHELL ANGLE. 3 x 3 x 36. DECK 3 x 3 x 36.

COLLISION BULK N° 56 FR.

PLATING. 28. BOTTOM PLATE. 32.

STIFFERS. 6 x 3 x 36. SPACED. 30" APART. (BRACKETED)

SHELL ANGLE. 3 x 3 x 36. DECK 3 x 3 x 36.

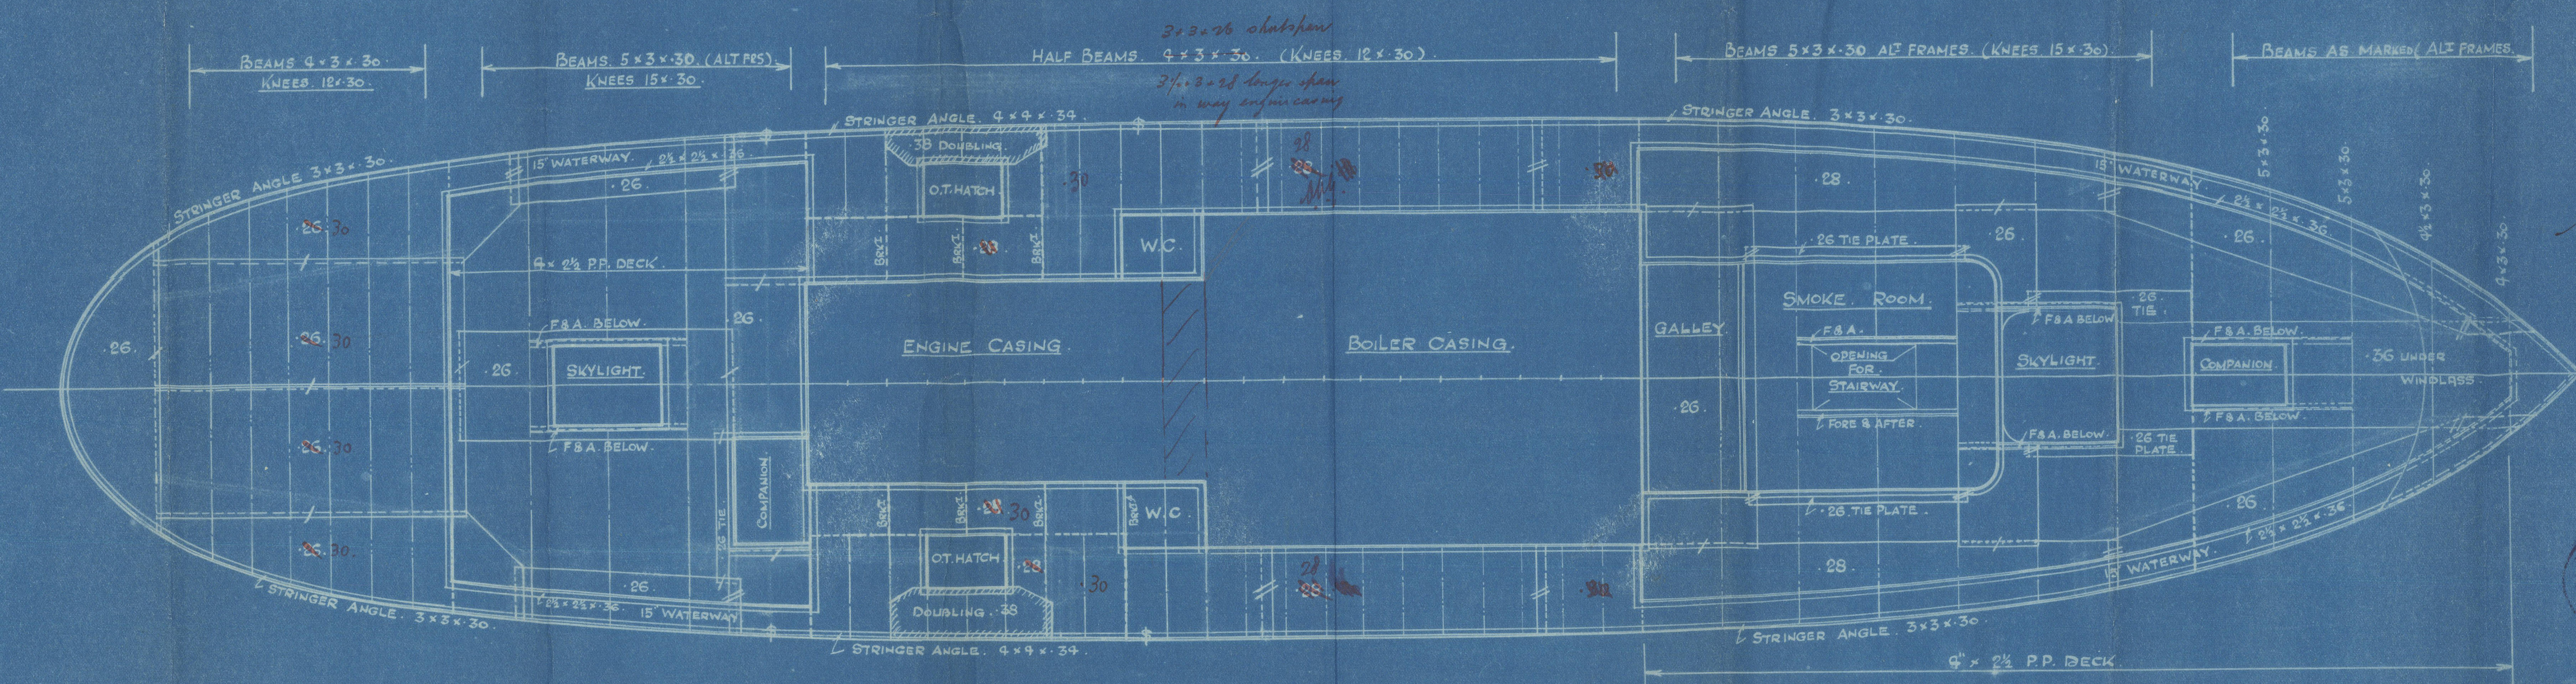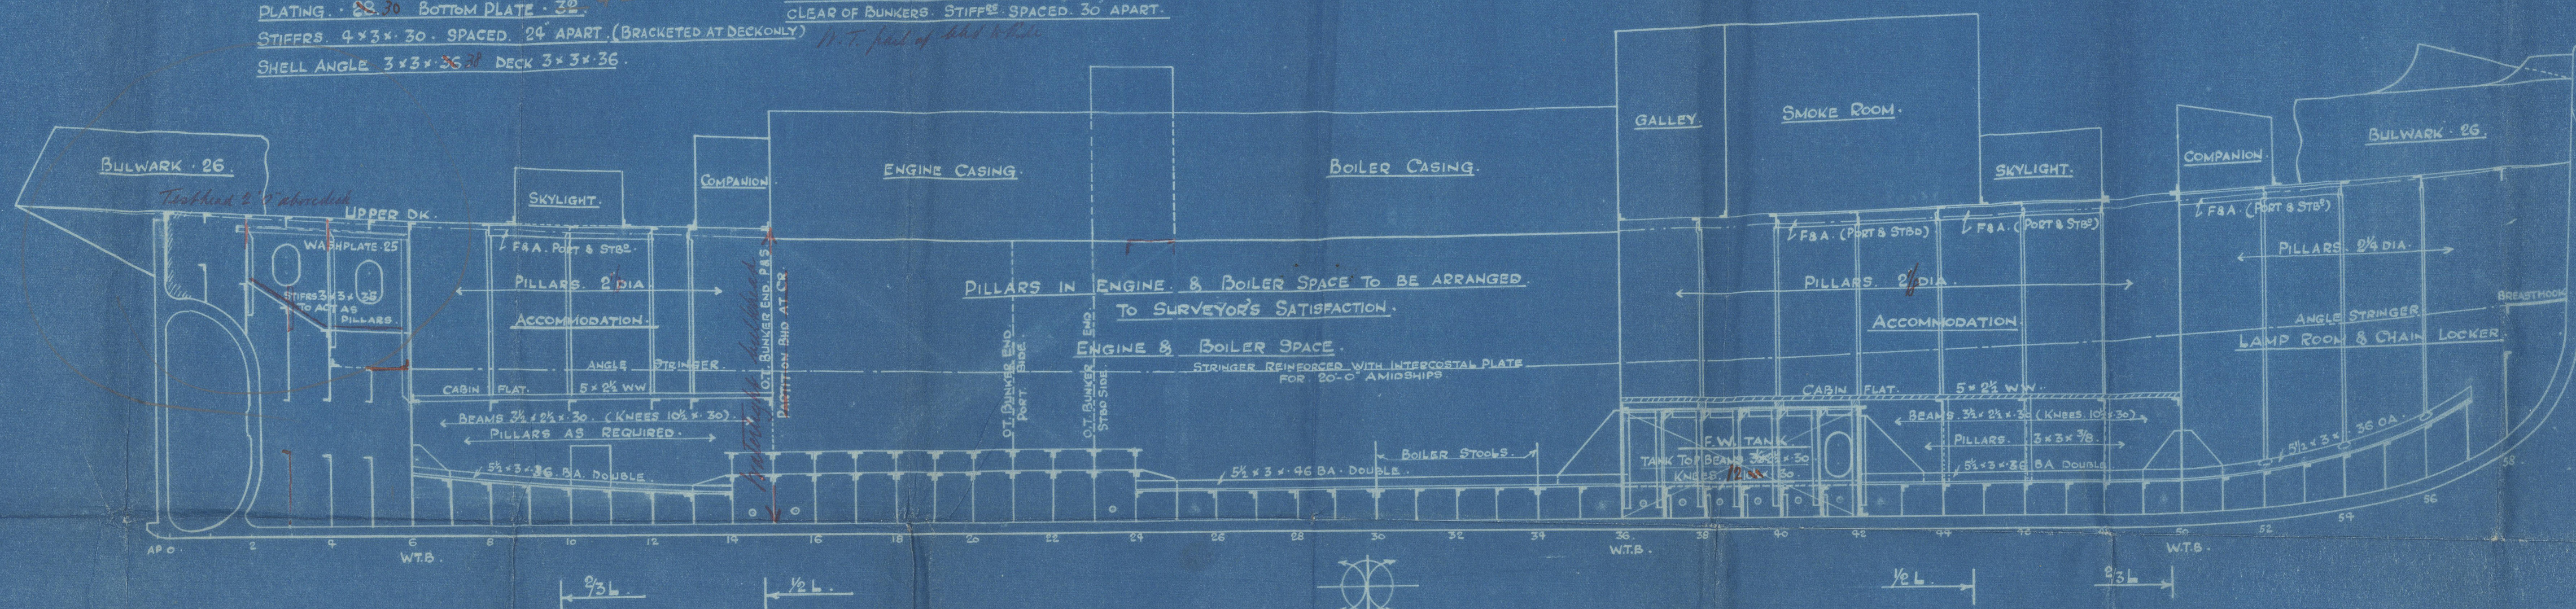

Amble S.B. Co. Ltd.

Profile & Deck plans

No 38

S. S. ROGER BECK.

NEWCASTLE ON TYNE.

Report No. 78647.



© 2020

Lloyd's Register

Foundation