


10/2/26.

— SECTION THRO' HOLDS —

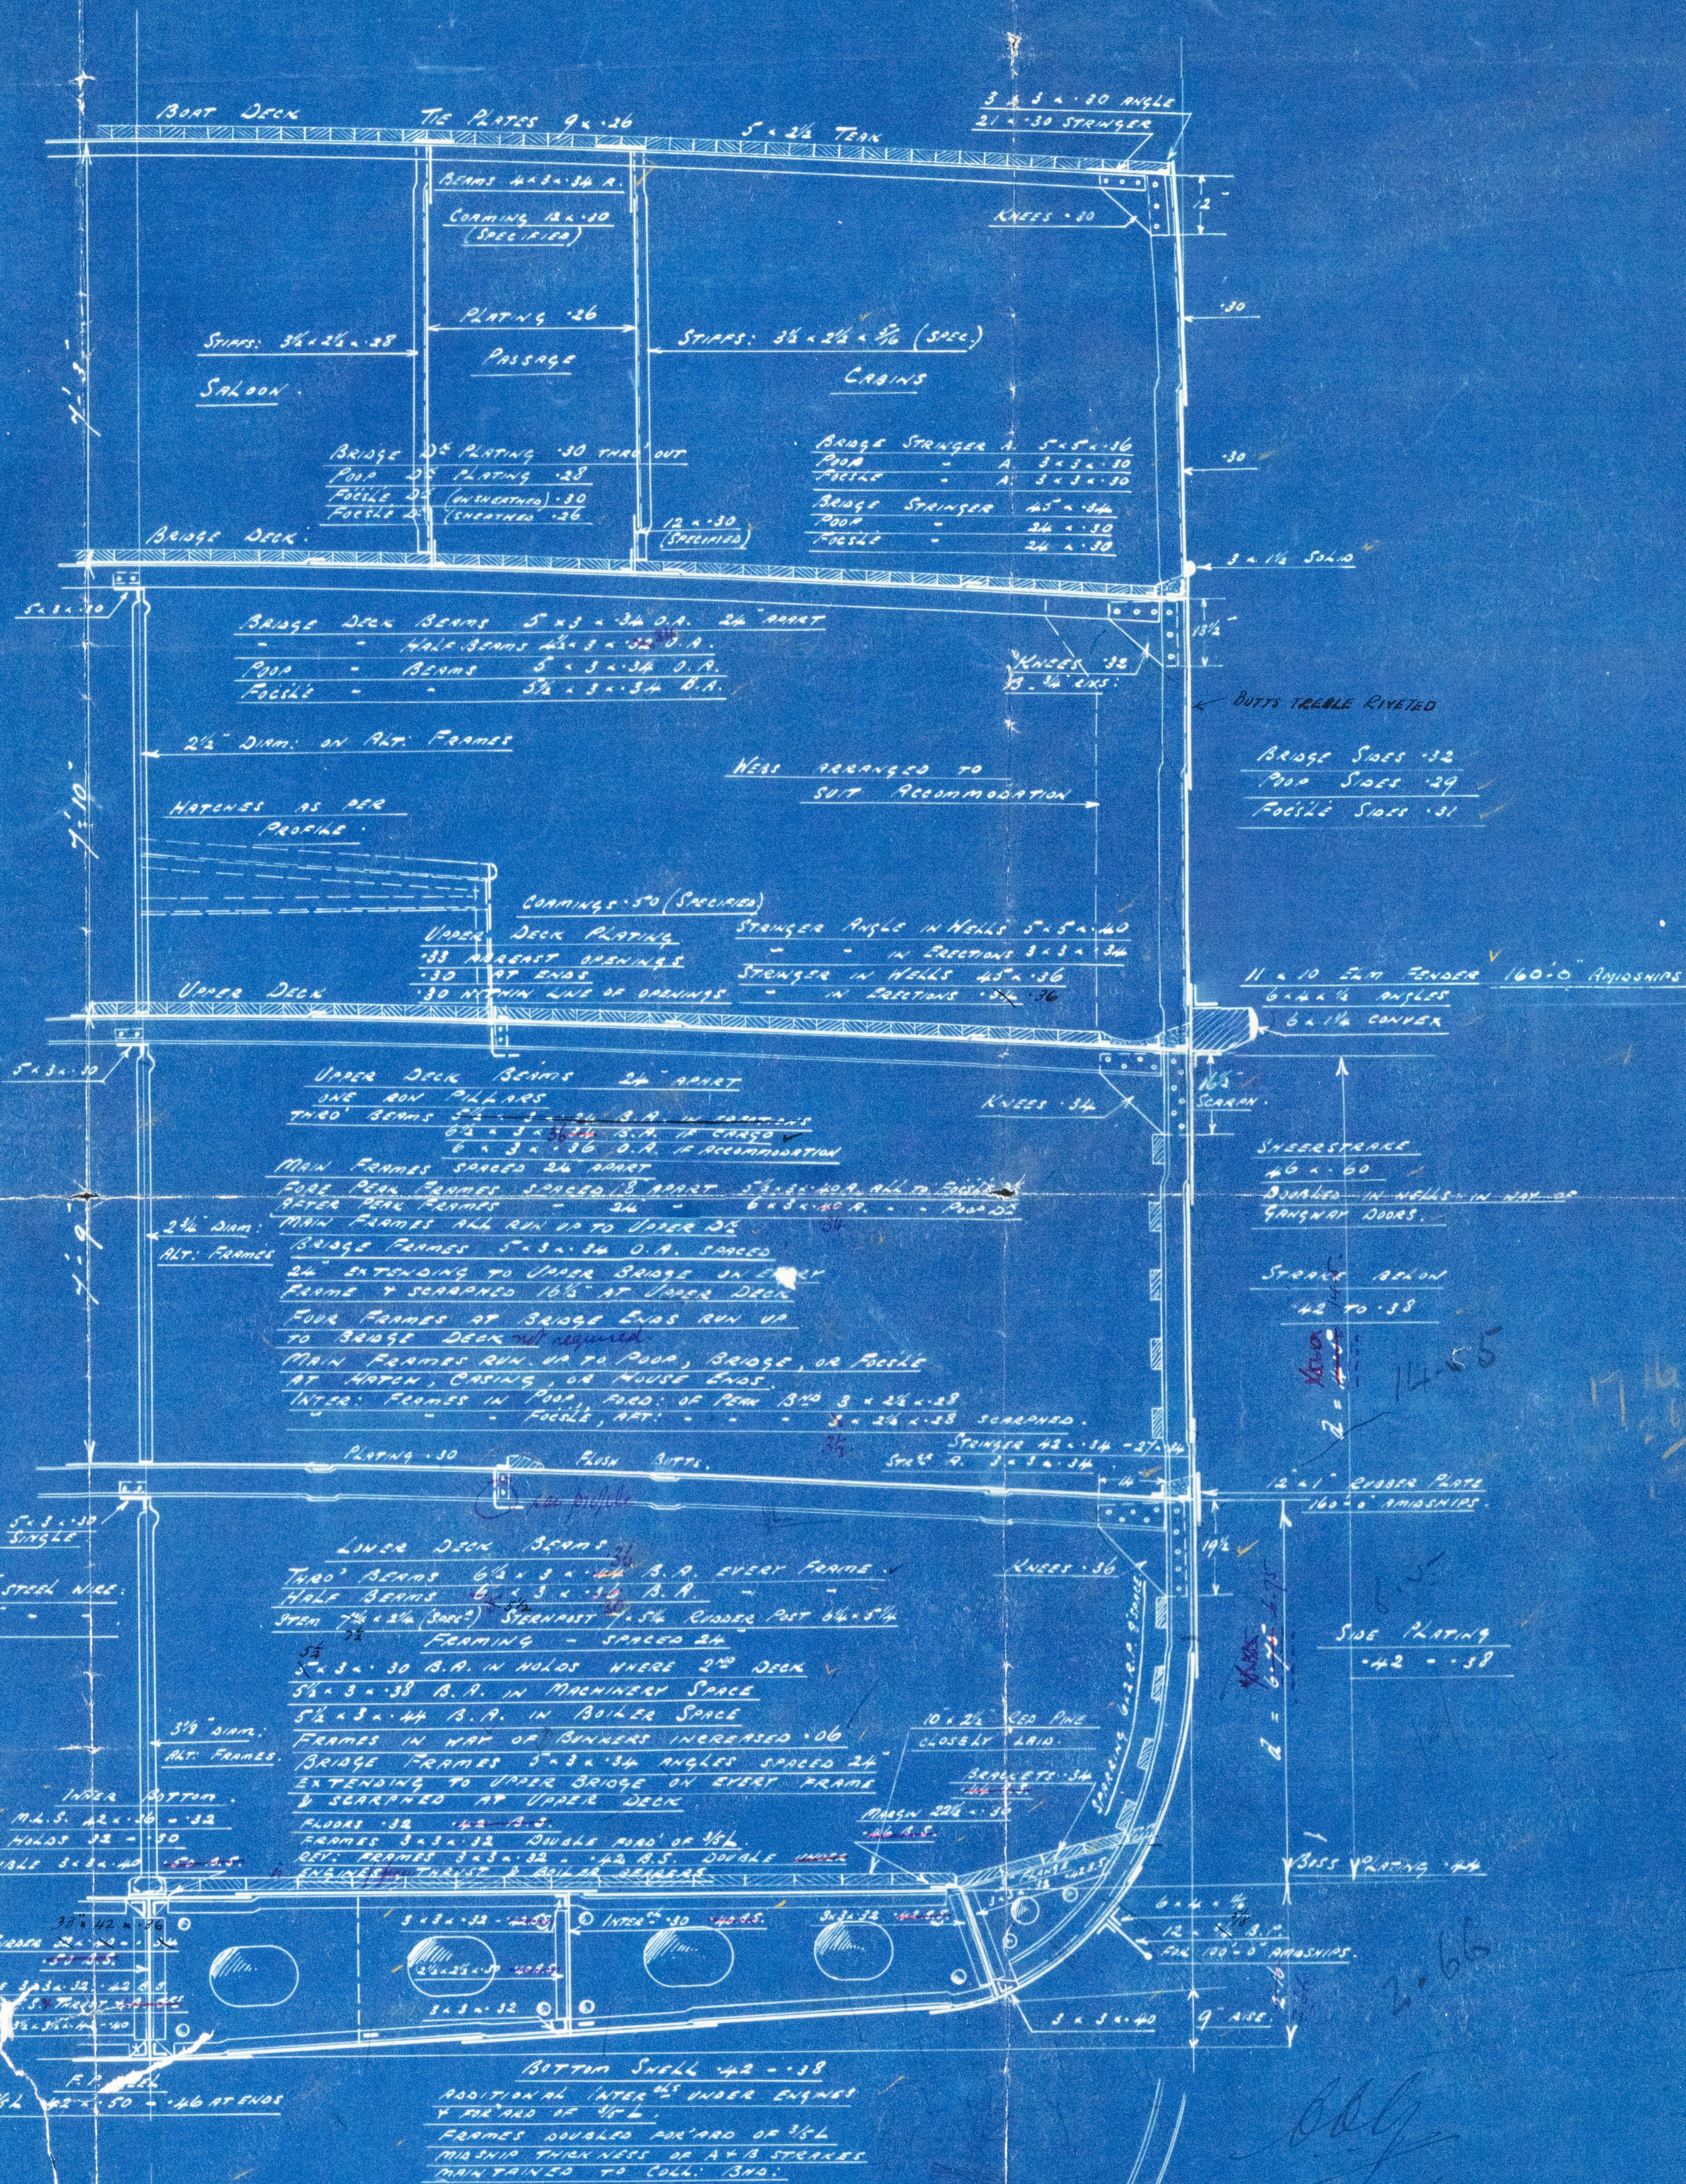



Earle's No 669

Plan of Midship Section

S.S. Sheringham

Port of Hull.

Report No 34387

003341-003348-0177

N. ER

LLOYS

MIDSHIP SECTION

E. 408 Ship No 669



© 2021

Lloyd's Register