

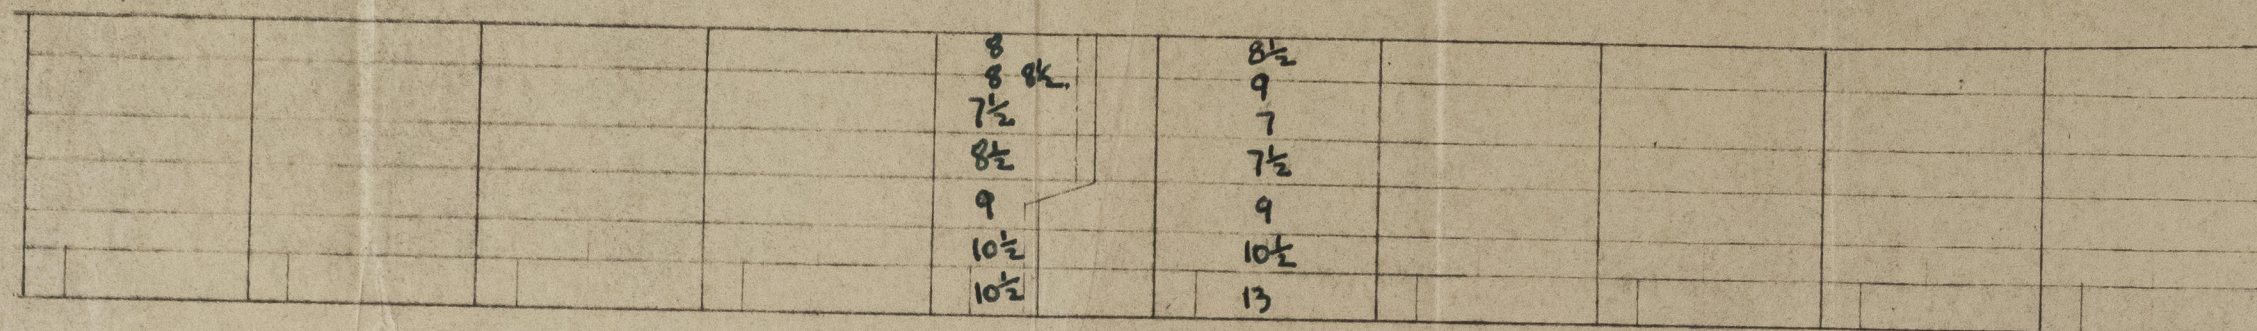


# M.V. "CONSTANCE"


ALL DRILLINGS IN MILLIMETRES.

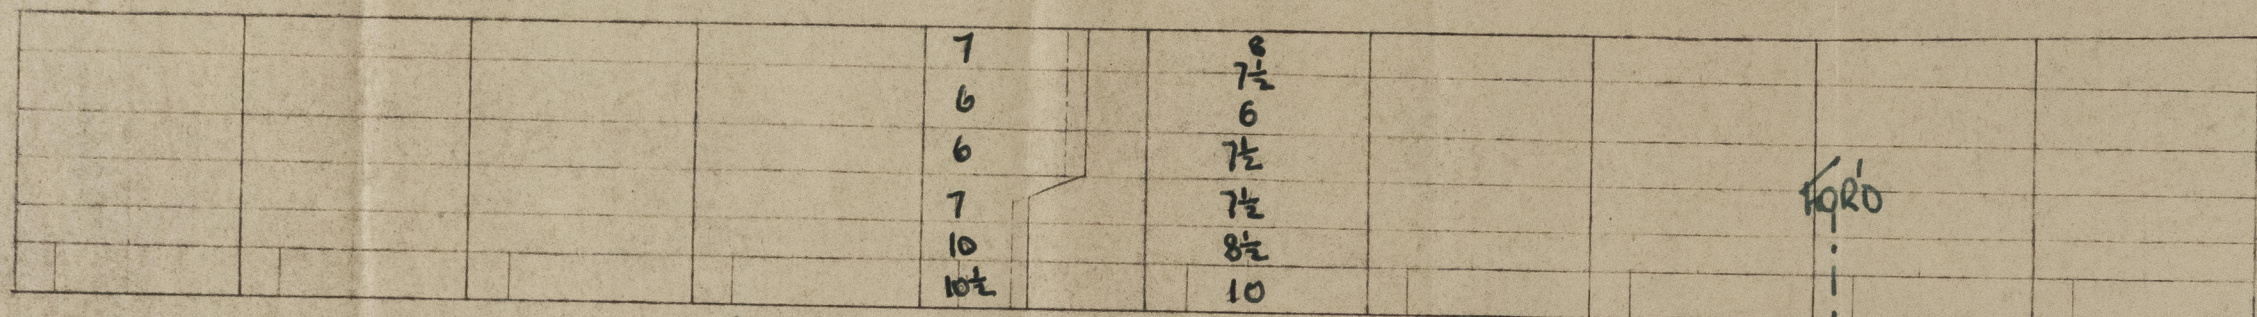


PORT LONG. BHKD

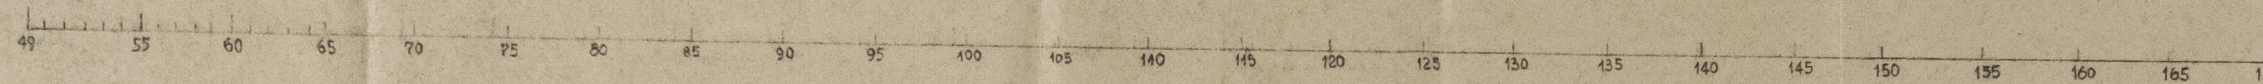


STBD LONG. BHKD

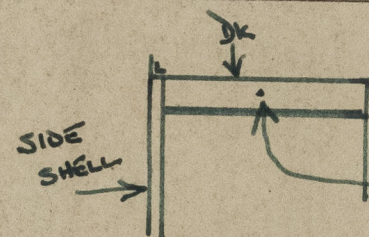


PLAN VIEW

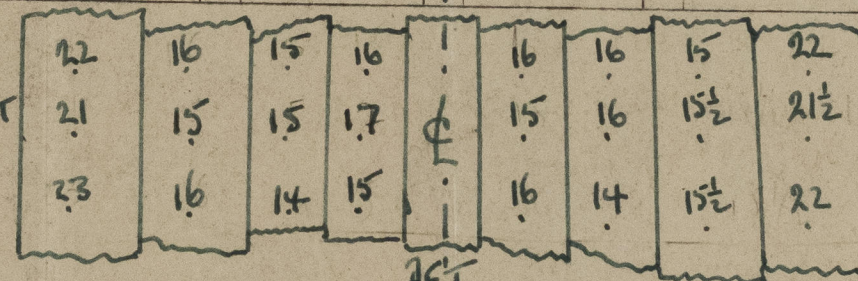


D.K. THICKNESSES AS DRILLED IN WAY OF NO. 5 CARGO TANK.

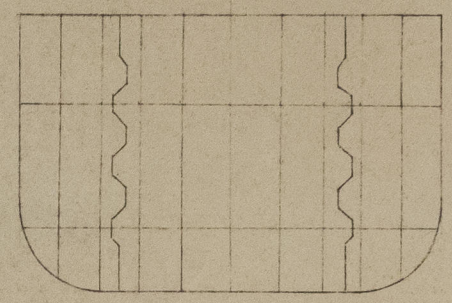


FRAME 49

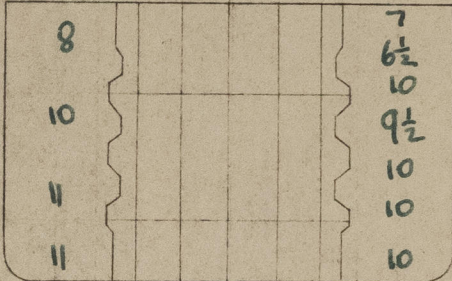



BULK'D FRAME 97

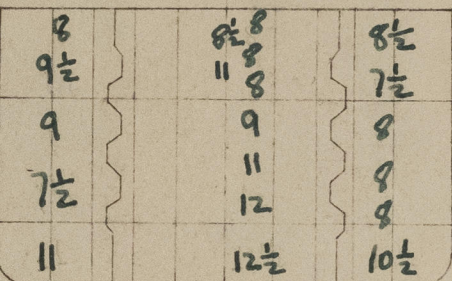

BULK'D FRAME 121

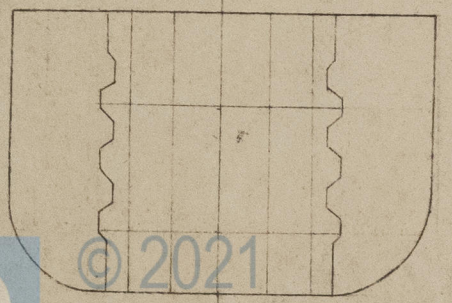

FRAME 137

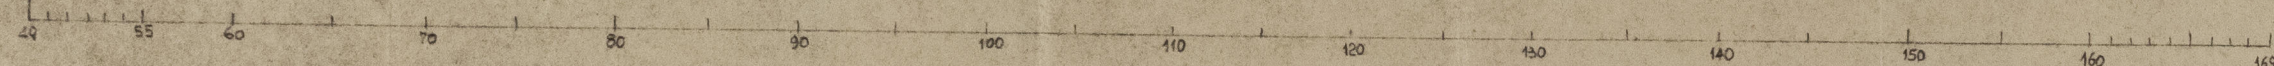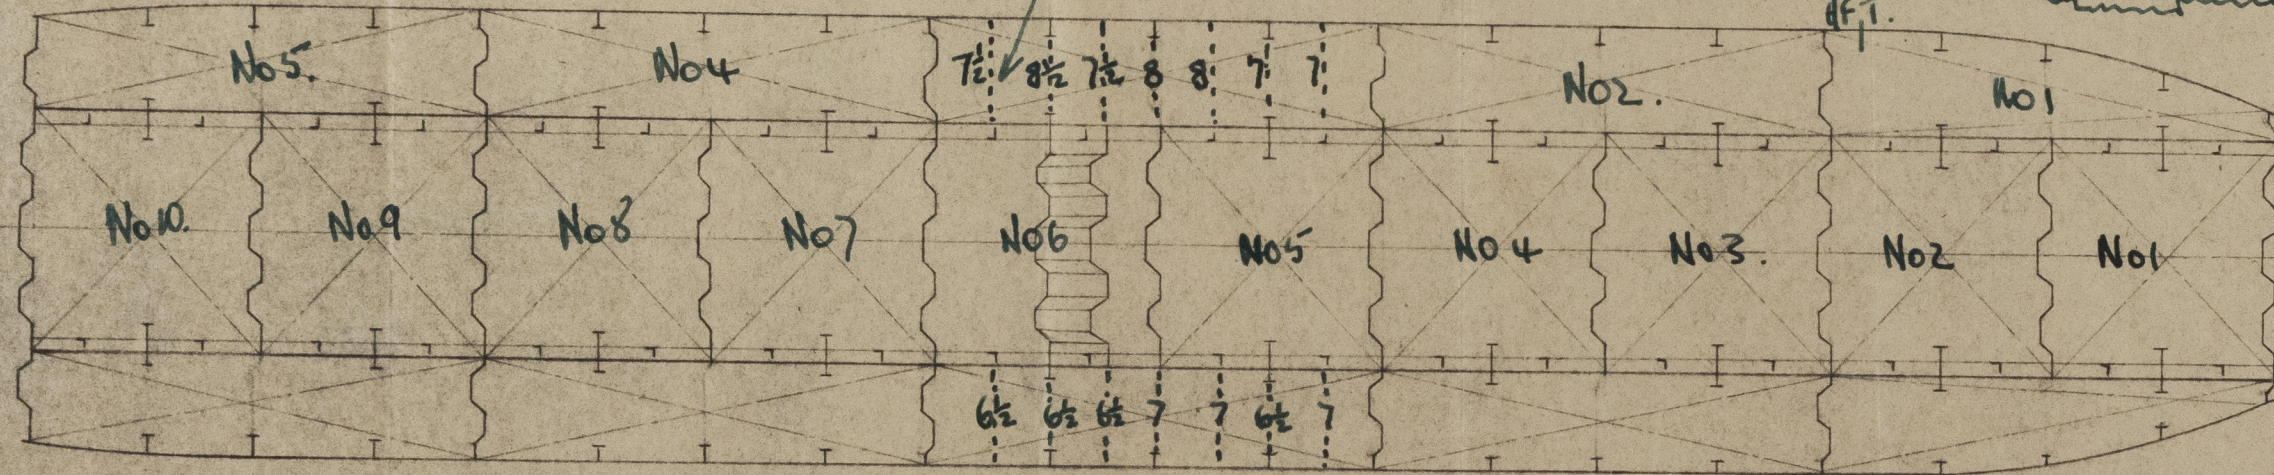

© 2021 Lloyd's Register Foundation



TO ACCOMPANY *naples* REPORT No. *4883*  
DATED *1, 53.*

003341- 003348- 0194



© 2021

Lloyd's Register  
Foundation