


S.S. NOVOR RITA. SOLEPIECE.

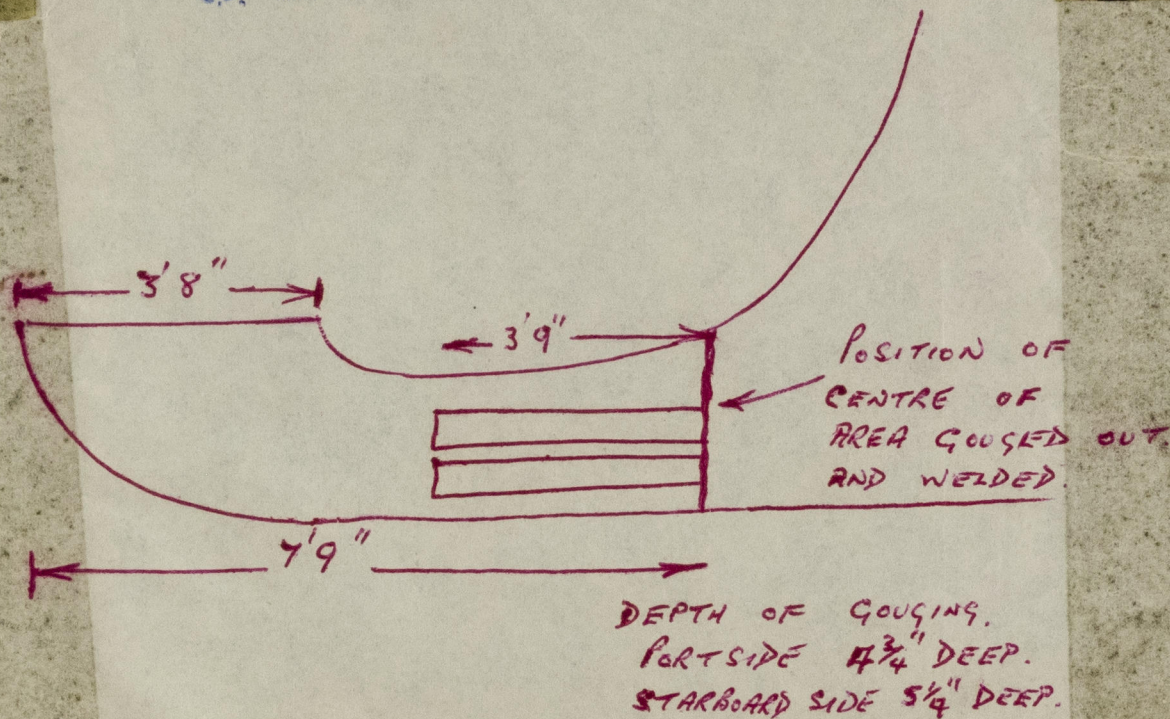

SS/MS "	
TO ACCOMPANY <i>Mil</i>	Rpt. No <i>8214</i>
Dated <i>7/57</i>	
SUBJECT:-	



© 2020

Lloyd's Register
Foundation

003349-003356-00341

