

9 JUN 1950

Rpt. C. 11 (Contd.)


Index No. ....

# Lloyd's Register of Shipping.

Ship's Name M/V "STAR OF EL NIL"

Official No. 93

Memorandum of alterations reported since ship was surveyed for assignment of Load Lines in

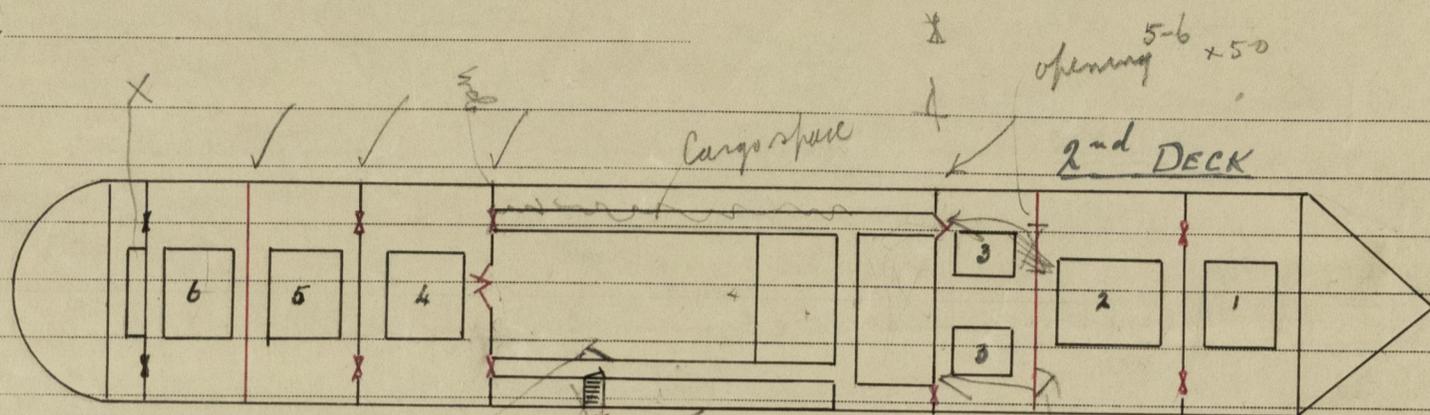

## In Shelter Deck Space

Nos. 1 to 2 holds bulkhead, Port and Starboard tonnage openings closed, by welded plates.

Additional bulkhead fitted, with no tonnage openings.

Bridge Front:- Starboard side tonnage opening closed by riveted plate.

Port side pressed steel door opening from both sides.

Bridge after bulkhead:- Port and Starboard tonnage openings, closed by welded plates.

Double steel doors, fitted on after engine room bulkhead 5'0"x5'7" height 13 sill.

✓ Nos. 4 to 5 holds bulkhead, port and starboard openings closed by welded plates.

✓ Nos. 5 to 6 holds bulkhead, additional bulkhead fitted, with no tonnage openings.

Starboard side Bridge housing: new companionway from shelter to main deck:-

Hard wood door size 5'6"x26" sill 18". Pressed steel, hinged door, also fitted for security purposes.

The above alterations were found to have been effected at some previous date.

Noted. 25 MAR 1948

PK Waplington



© 2020

Lloyd's Register  
Foundation