


Lloyd's Register of Shipping.

SURVEYS FOR FREEBOARD.

(CONDITIONS OF ASSIGNMENT.)

Ship's Name **"EMPIRE CONFIDENCE" ex "DUSSELDORF"** Port of Survey **London**
 Official Number **156144** Surveyor's Signature **Arthur H. Smith**
 Nationality and Port of Registry **BRITISH LONDON** Date of Survey **24/4/40, 25/4/40, 30/4/40, 2/5/40, 7/5/40, 6/8/40, 7/8/40, 9/8/40.**

Disposition and dimensions of superstructures, trunks, deckhouses and machinery casings to be inserted in the diagrams and tabular statement:

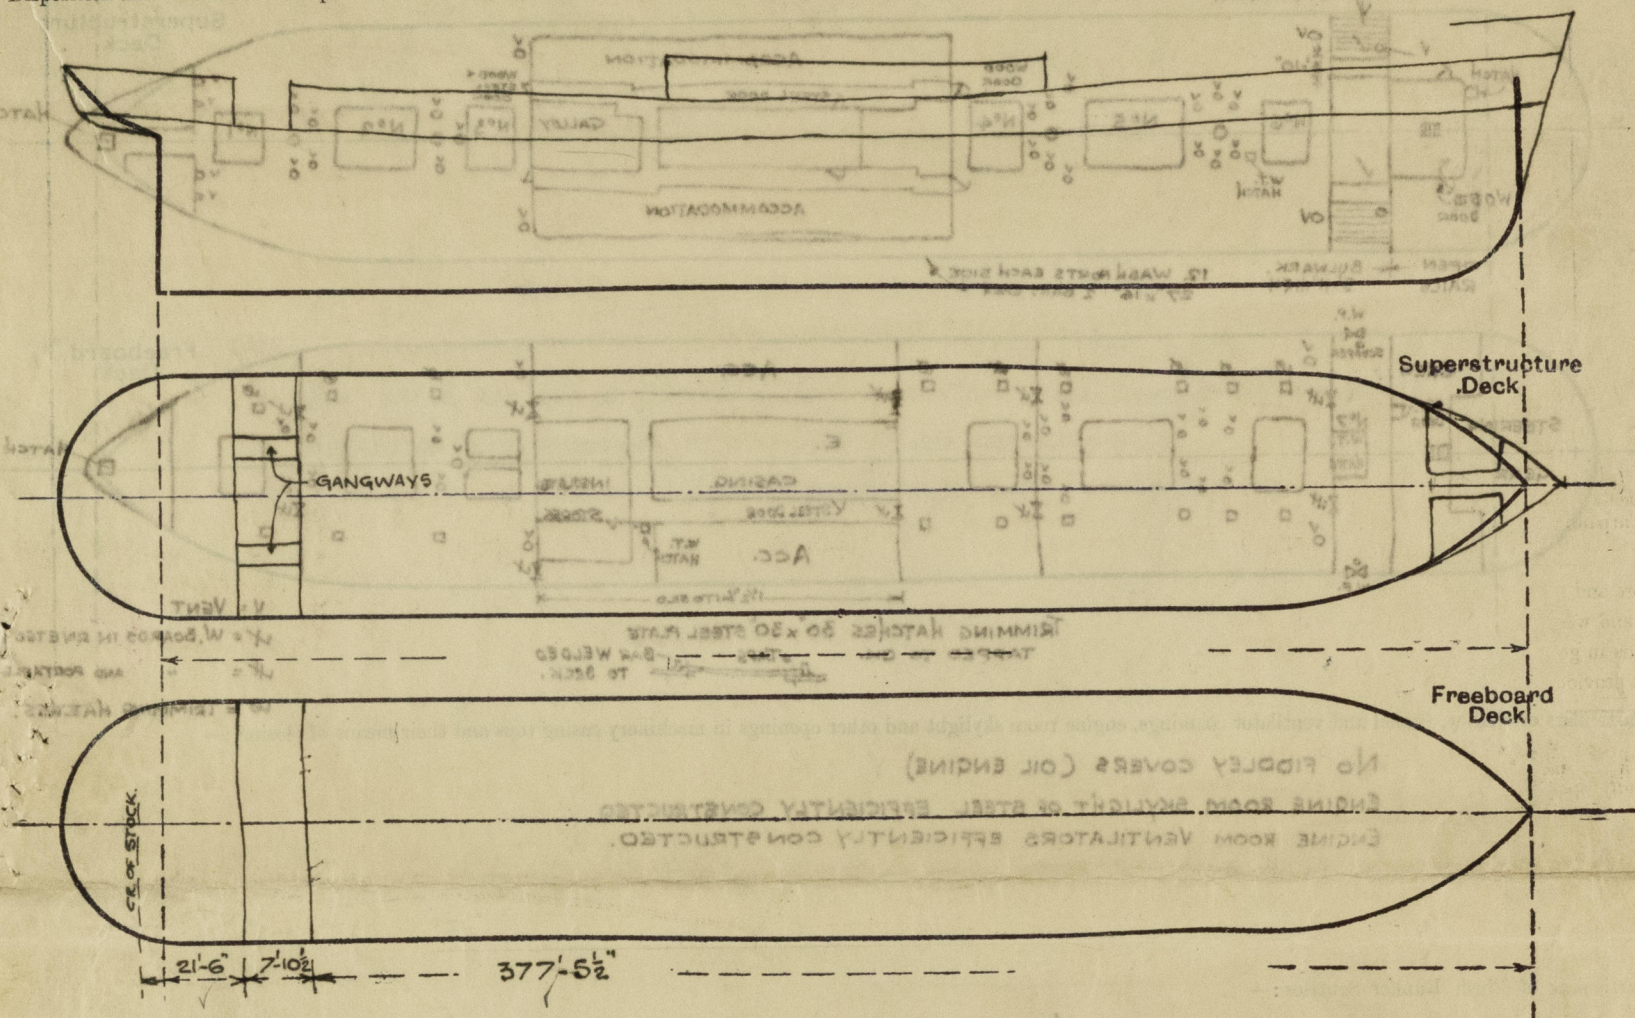


Particulars of Superstructures, Trunks, Casings, Deckhouses.

	Coaming	Plating	Stiffeners	Spacing	End Attachments of Stiffeners	Size of Openings	Height of Sills	Height of Casings
Poop Bulkhead ...	VERTICAL PLATING	3/8" WELDED	4 1/2" x 3" x 5/16" L	30"	LUGS	NONE	✓	8'-0" SIDE 8'-8" CR. ✓
Raised Quarter Deck Bulkhead ...								
Bridge, After Bulkhead } ...	VERTICAL PLATING	5/16" WELDED	4" x 2 1/2" x 3/2" L	30"	UNATTACHED	3'-1" x 4'-5" P.S.	24"	8'-0" SIDE 8'-8" CR. ✓
Bridge, Forward Bulkhead } ...								
Forecastle Bulkhead ...								
Trunk, Aft ...								
Trunk, Forward ...								
Exposed Machinery Casings on Freeboard or Raised Quarter Decks ...	16" x 3/8"	.35"	4 5/8" x 3" x .35" L	30"	LUGGED TO BEAMS	5'-0" x 2'-1" S	16"	8'-3" ✓
Exposed Machinery Casings on Superstructure Decks ...	15" x 3/8"	.35"	4 5/8" x 3" x .35" L	30"	BRACKETS	5'-0" x 2'-1" P.S.	15 1/2"	7'-8" ✓
Machinery Casings within Superstructures not fitted with Class I Closing Appliances ...								
Deckhouses on Flush Deck Ships ...								

Particulars of Closing Appliances (state if capable of being manipulated from both sides).

Poop Bulkhead ...	No OPENINGS. ✓
Raised Quarter Deck Bulkhead ...	
Bridge, After Bulkhead } ...	PORTABLE STEEL PLATES WITH HOOK BOLTS SPACED 13"/14" AND W. BOARDS IN RIVETED CHANNELS, PORTABLE PLATES ARE PACKED AND VIRTUALLY W.T. ✓
Bridge, Forward Bulkhead } ...	
Forecastle Bulkhead ...	
Exposed Machinery Casings on Freeboard or Raised Quarter Decks ...	No EXPOSED CASINGS. ✓
Exposed Machinery Casings on Superstructure Decks ...	No EXPOSED CASINGS. ✓
Machinery Casings within Superstructures not fitted with Class I Closing Appliances ...	HINGED STEEL DOORS OPERATED BOTH SIDES. ✓
Deckhouses on Flush Deck Ships ...	NONE ✓

The following diagrams should be used to indicate the positions of cargo and coaling hatchways, gangway, cargo and coaling ports, ventilators, companionways, etc., which would affect the seaworthiness of the ship:—

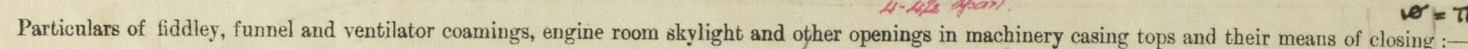

Particulars of Flush Bunker Scuttles:—

Particulars of Companionways :—

Particulars of Ventilators in exposed positions on freeboard and superstructure decks :—

VENTILATORS AT MASTS AND DERRICK POSTS
SUPPORTED BY DERRICK TABLES. ✓

VENTILATORS PROVIDED WITH WOOD PLUGS AND
CANVAS COVERS. ✓

Particulars of Air Pipes in exposed positions on freeboard, raised quarter, or superstructure decks :—

- ✓ AIRPIPES FITTED WITH WOOD PLUGS. ✓
- X " " " HINGED PLATE COVERS. ✓
- O TO COMMON OVERFLOW TANK AND CARRIED UP FUNNEL. ✓
- AIR PIPES SECURED TO AND PROTECTED BY BULWARKS. ✓

Empire Confidence

Particulars of Scuppers and Sanitary Discharge Pipes :—

Particulars of Side Scuttles :—

Vertical distance of Sill of lowest Side Scuttle above top of keel..... 32'-0"

Particulars of Guard Rails :—


Particulars of Gangways, Lifelines, etc. :—

GANGWAYS AT ~~TONNAGE~~ WELL

LIFELINES CAN BE PROVIDED AS AND WHEN REQUIRED

Particulars of Freeing Arrangements.

State position of each freeing port	{ After Well :— 6" ABOVE DECK. { Forward Well :—
(F. and A. position and height above deck edge)		

State whether the freeing ports are fitted with shutters, bars, or rails, and give particulars of such:—

Additional area where sheer is less than standard.

such:— **VERTICAL BARS**
OPENINGS CLOSED WOOD
SECURED TO SHELL BY FLAT BARS.

PARTICULARS OF PROTECTION TO OPENINGS, ETC.

HATCHWAYS ON FREEBOARD AND SUPERSTRUCTURE DECKS.											
	SUPERSTRUCTURE DK.						FREEBOARD DK.				
Description of Hatchway	Nº 1	Nº 2	Nº 3	Nº 4	Nº 5	Nº 6	Nº 1	Nº 2	Nº 3	Nº 4	
Dimensions of Hatchway	18'4" x 14'9"	33'1" x 18'0"	18'4" x 18'0"	18'4" x 18'0"	34'1" x 18'0"	18'4" x 18'0"	18'4" x 14'9"	33'1" x 18'0"	18'4" x 7'9"	18'4" x 18'0"	
COAMINGS	<div> <div>Height above Deck</div> <div>Thickness</div> <div>Stiffeners</div> <div>Brackets, Stops</div> </div> <div> <div>Sides</div> <div>Ends</div> </div>										
HATCH BEAMS	<div> <div>Number</div> <div>Scantling and Sketch</div> <div>Bearing Surface</div> </div>										
FORE AND AFTERS	<div> <div>Number</div> <div>Spacing</div> <div>Unsupported Lengths</div> <div>Scantling* and Sketch</div> <div>Bearing Surface</div> </div>										
HATCH COVERS	<div> <div>Material</div> <div>Thickness</div> <div>How fitted</div> <div>Bearing Surface</div> </div>										
Spacing of Cleats	20"	AS	AS	AS	AS	AS	20"	AS	AS	AS	
Number of Tarpaulins	3	Nº 1	Nº 1	Nº 1	Nº 1	Nº 1	3	Nº 1	Nº 1	Nº 1	
<p>*Are wood fore and afters steel shod at all bearing surfaces? <input checked="" type="checkbox"/></p> <p>Are battens and wedges efficient and in good condition? <input checked="" type="checkbox"/></p> <p>Are tarpaulins in good condition and in accordance with rule requirements? <input checked="" type="checkbox"/></p> <p>Are lashings provided in accordance with rule requirements? <input checked="" type="checkbox"/> YES, LOCKING BARS.</p>											

Particulars of any special features:—

Endorsement at first survey and at surveys for renewal of Certificate:—

The fittings and appliances are in accordance with the particulars shown on this form (or as now modified) and are in good condition.

