

02 - p 13 001
002 - 142 001
winter 6 quills bill

27.9.12
(MS 548)
7500 30.10.12

Messrs Lloyd's Register
Hull

20.7.12 RK

MIDSHIP SECTION

STEEL SCREW TRAWLERS


N^{os} 549-50 + 548 + 560

DIMS. LEN 133'-4" x 23'-0" EX x 13'-1" MLD

SCALE 1/2" = 1 FOOT

TO CLASS 100A.1 AT LLOYDS FOR FISHING PURPOSES ENGINE & BOILER CASING AS PREVIOUSLY APPROVED. DECK PLATED OVER IN WAY OF ENGINE & BOILER CASING.

PLAN No. 2680
FOR ENCLOSURE TO
Messrs Lloyd's Register
Hull FROM
CARPENTERS & SONS, LTD.
SHIPBUILDERS 851 BY
20/3/13. RK

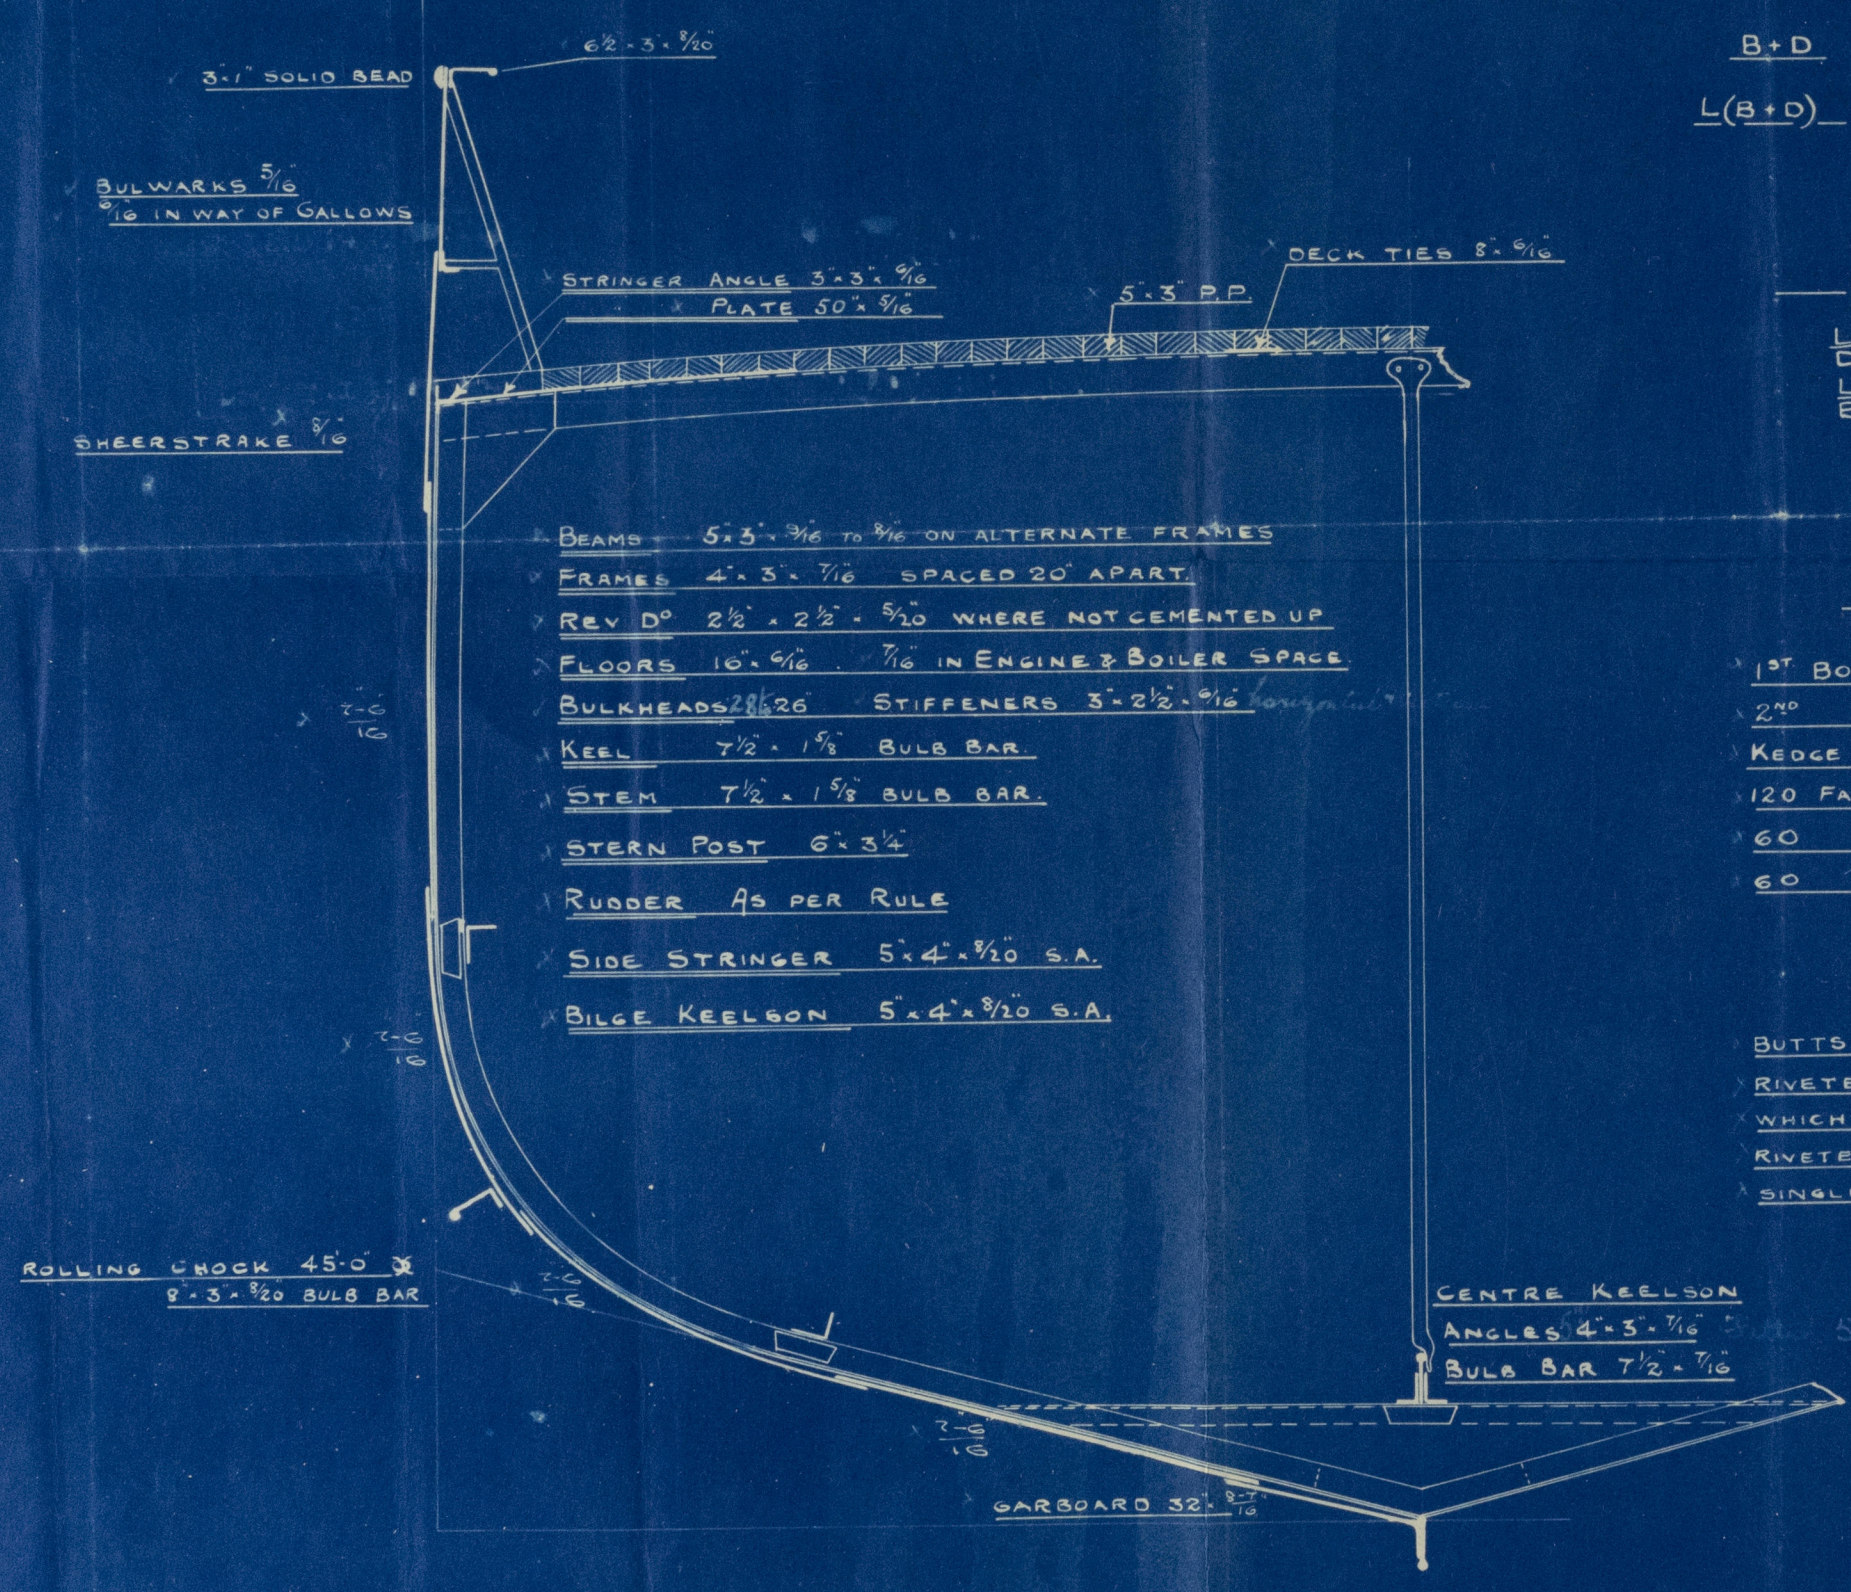

NUMERALS

B+D	=	35.95
L(B+D)	=	4793.21

PROPORTIONS

W/L OF	=	10.19
	=	5.79

EQUIPMENT

1 ST BOWER ANCHOR	6 CWTs EX STOCK
2 ND "	5 1/2 " " "
KEDGE ANCHOR	3 " " "
120 FATHOMS	1 1/2" CABLE
60 "	6" HAWSER
60 "	5" WARP

RIVETING

BUTTS OF SHELL PLATING LAPPED & DOUBLE RIVETED EXCEPT GARBOARD & SHEER STRAKE WHICH ARE TO BE STRAPPED & DOUBLE RIVETED. LANDINGS DOUBLE RIVETED BULWARKS SINGLE RIVETED

CENTRE KEELSON
ANGLES 4" x 3" x 1/16"
BULB BAR 7 1/2" x 1/16"

C.B.
27.9.12



Cochran & Sons.

N^o. 549. 550. 548. 560

Duplicate.

Midship Section.

1/2 Venator Shell Rpt No: 25993h^o 549
Tribune " " " 26027. h^o 550
" Volcan " " " 26207. h^o 5278.
H



© 2020

Lloyd's Register
Foundation

003357-003368-0279