








N^o 1052-3.

PLAN OF STEEL DECKS.

DIMENSIONS 460'-0" B.P. x 59'-0" MLD. x 34'-0" MLD.

SCALE $\frac{1}{8}$ " = 1 FOOT.

TO CLASS LLOYDS 100A.1 CARRYING PETROLEUM IN BULK

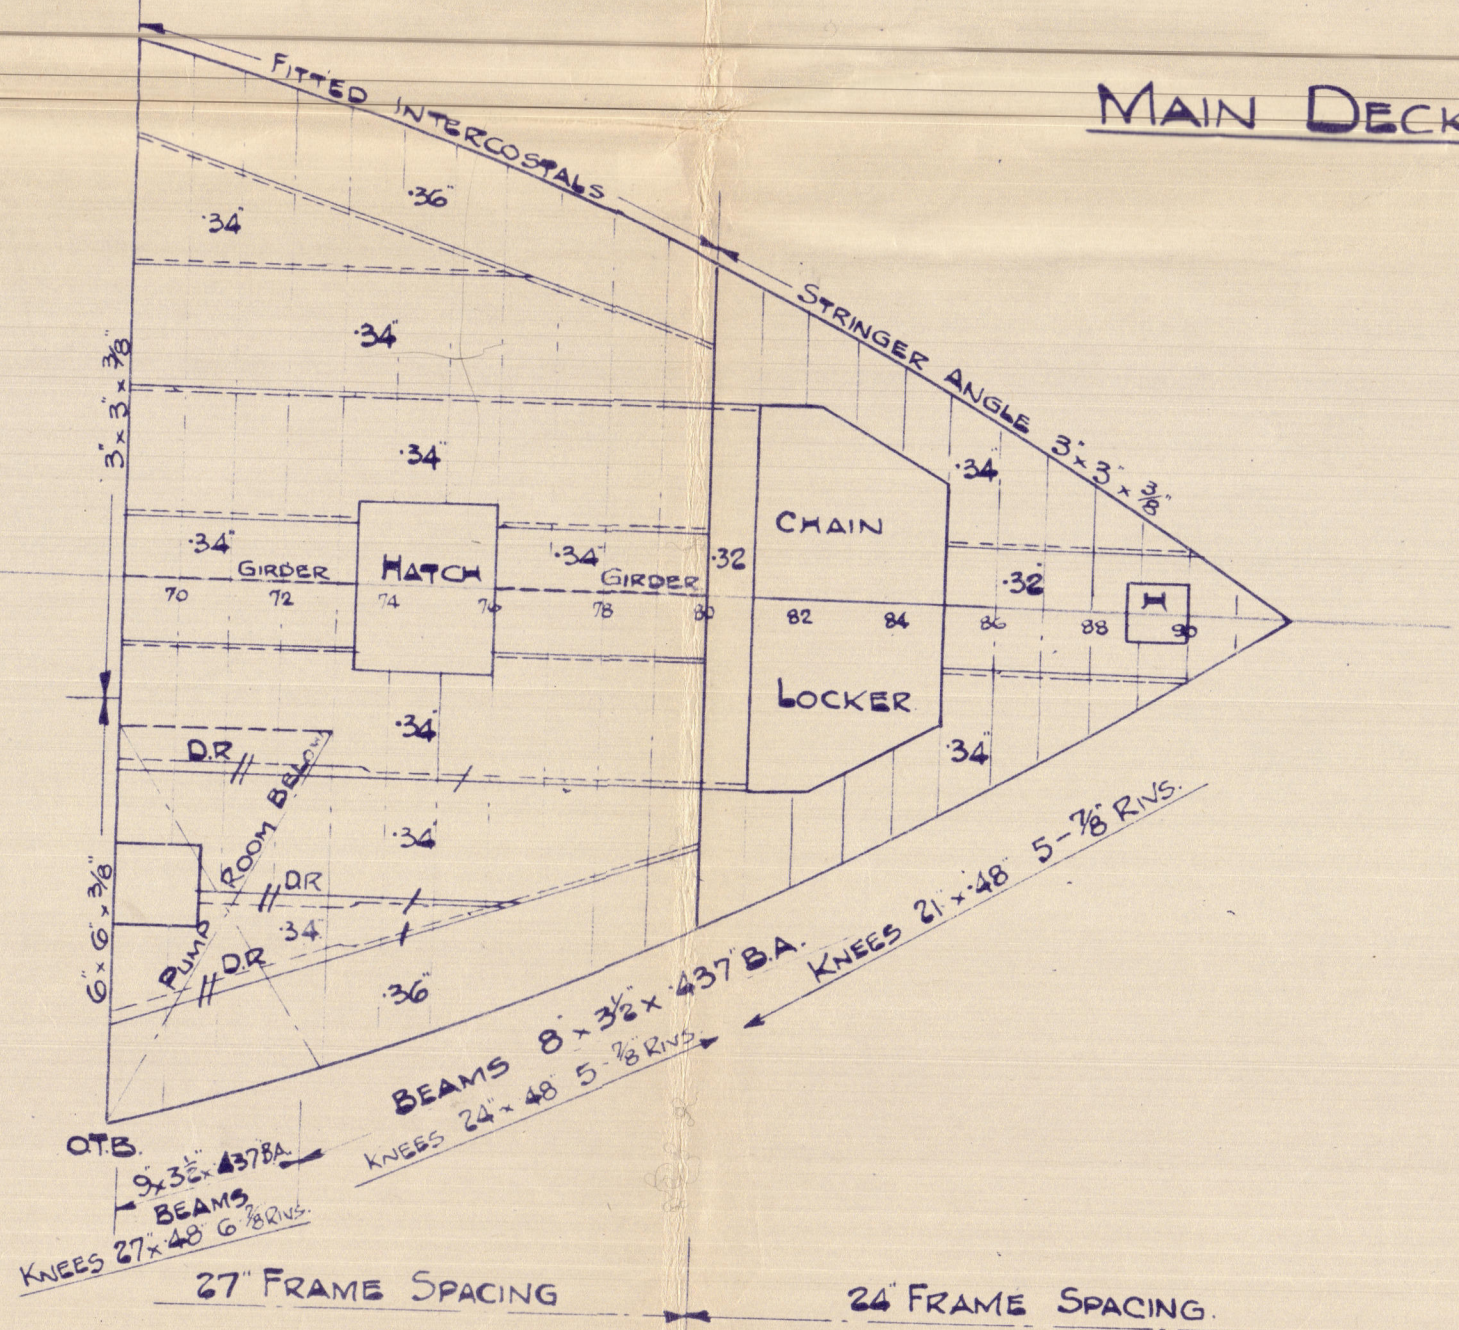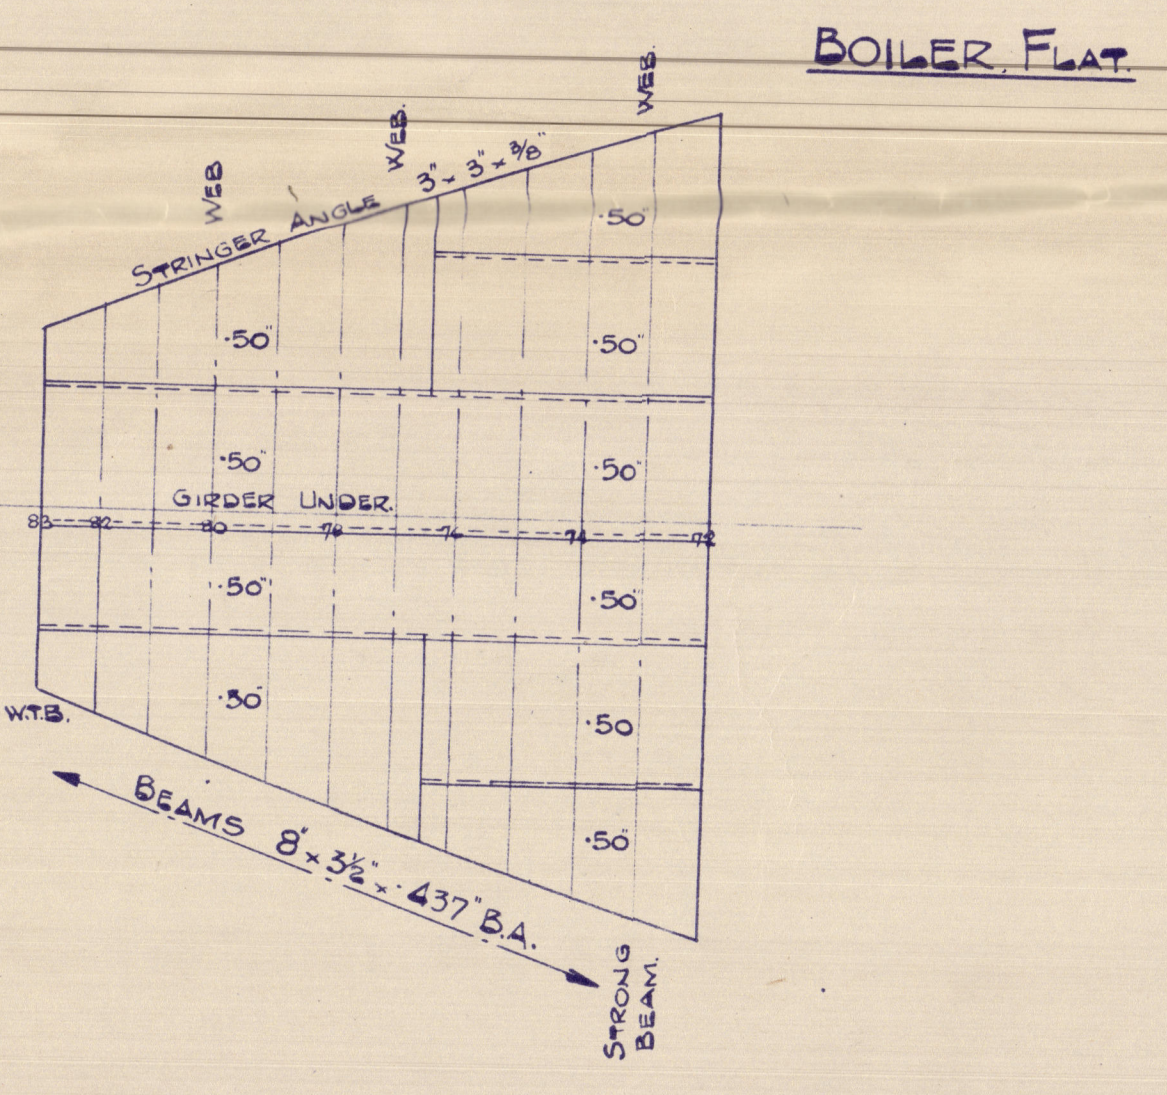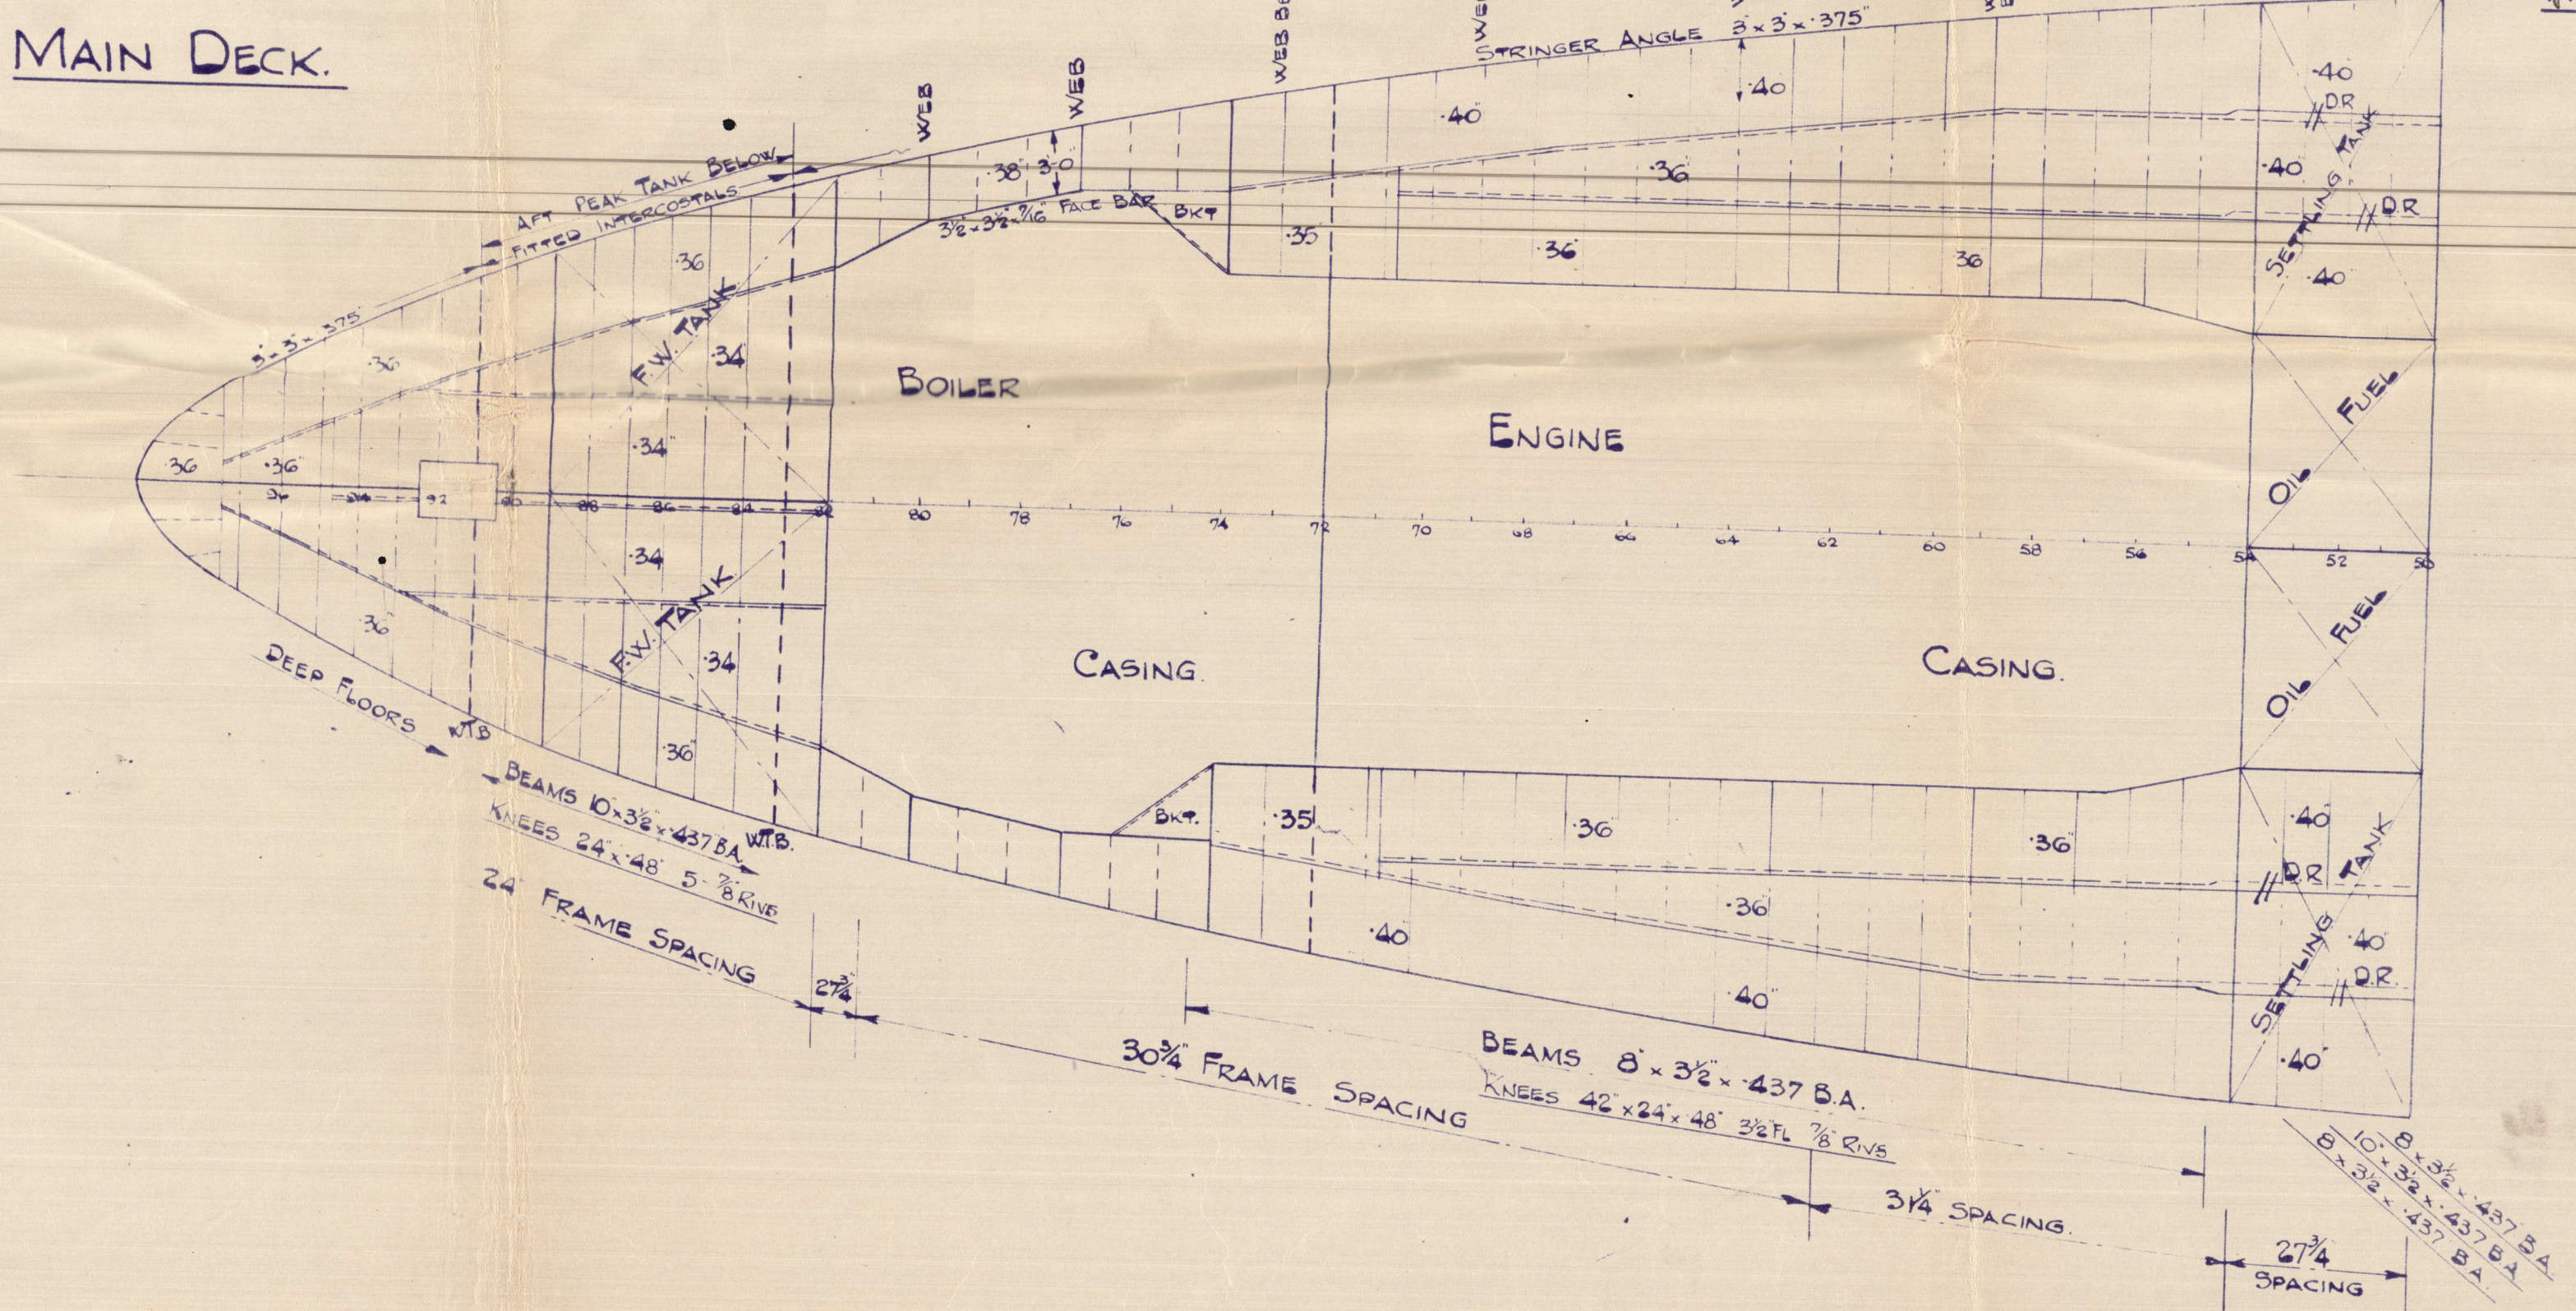 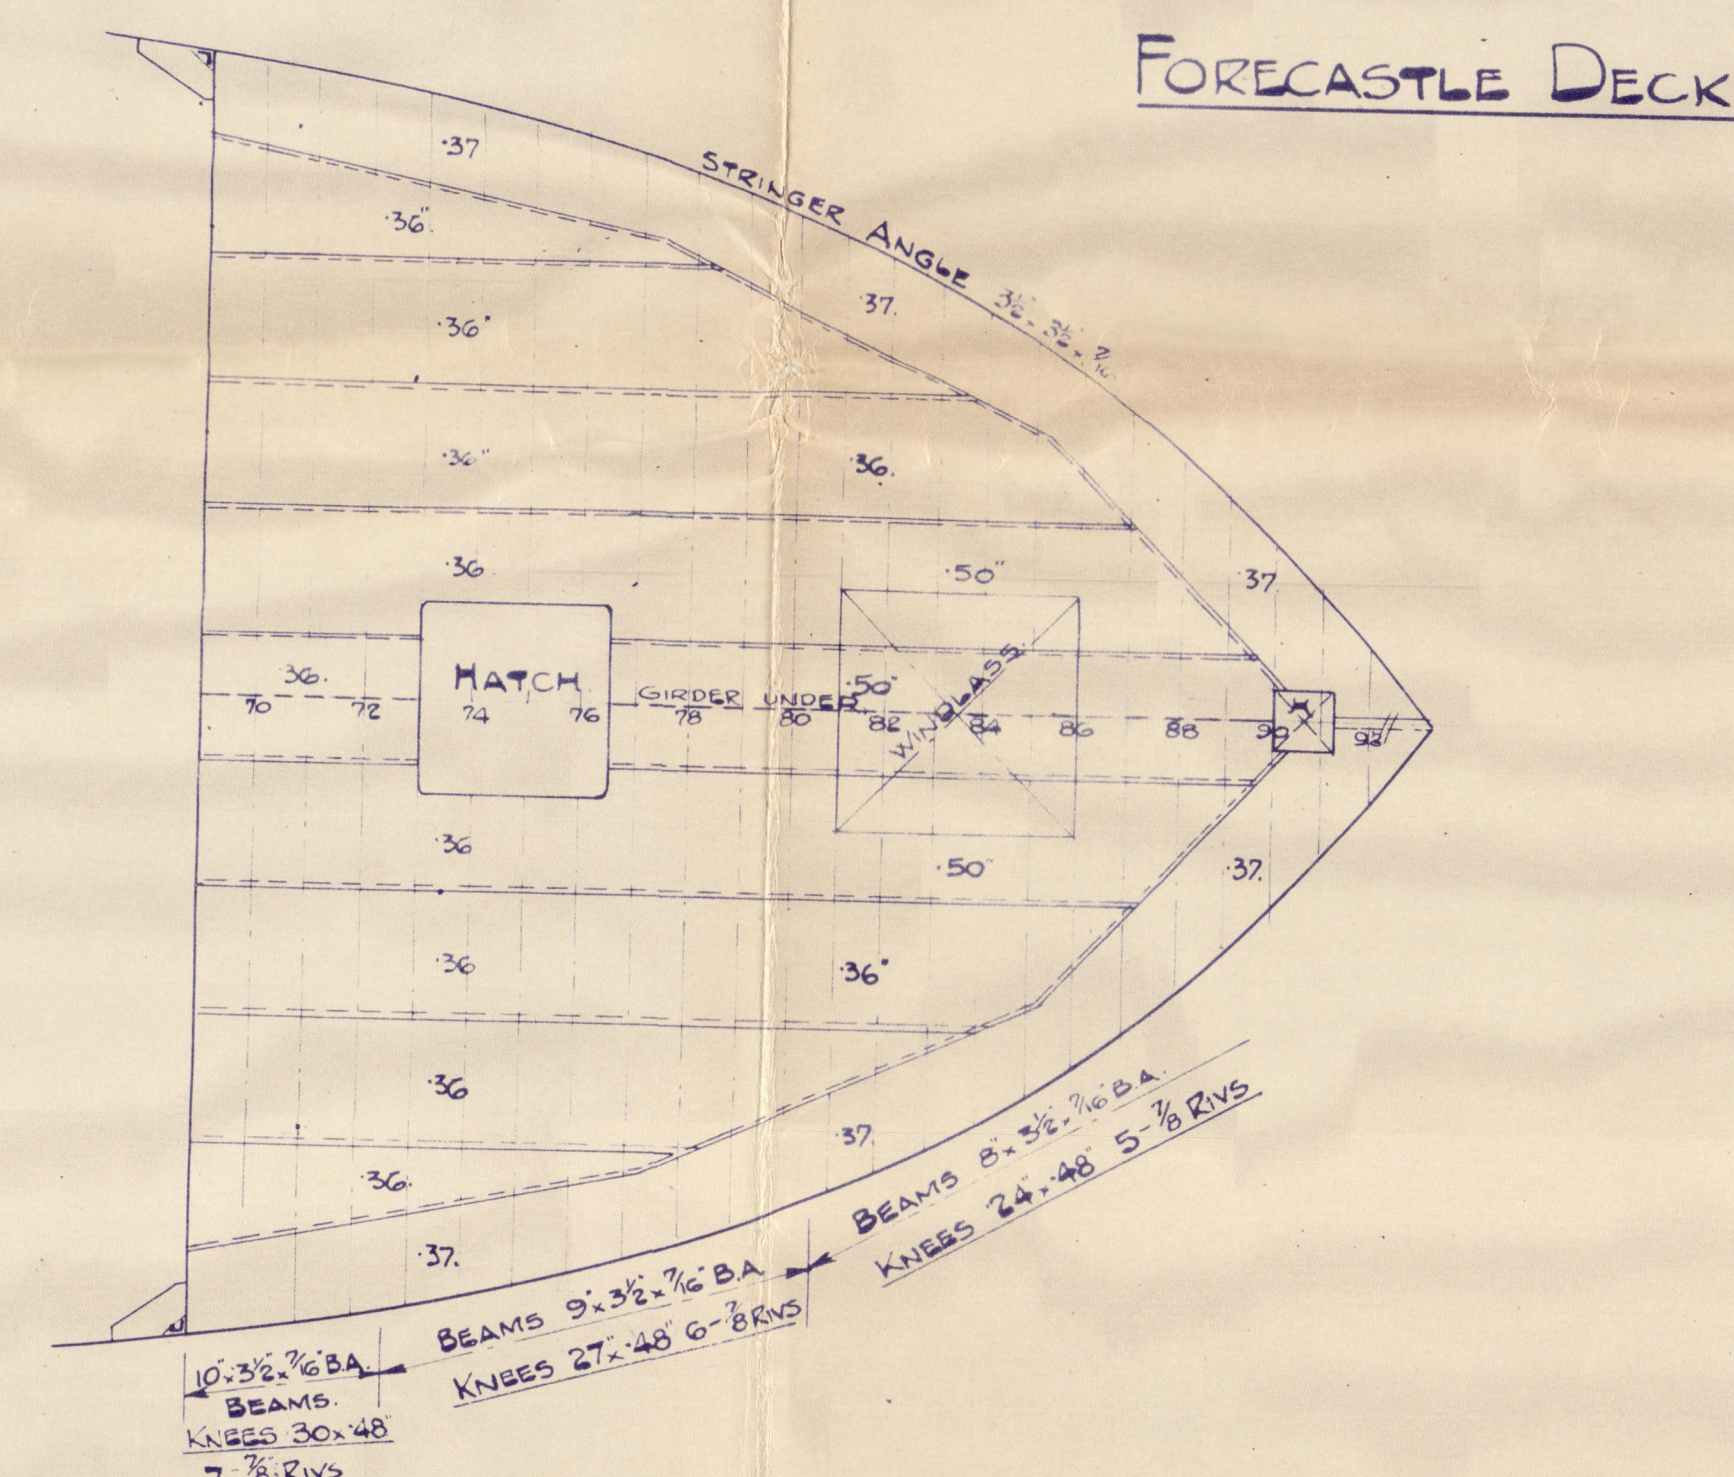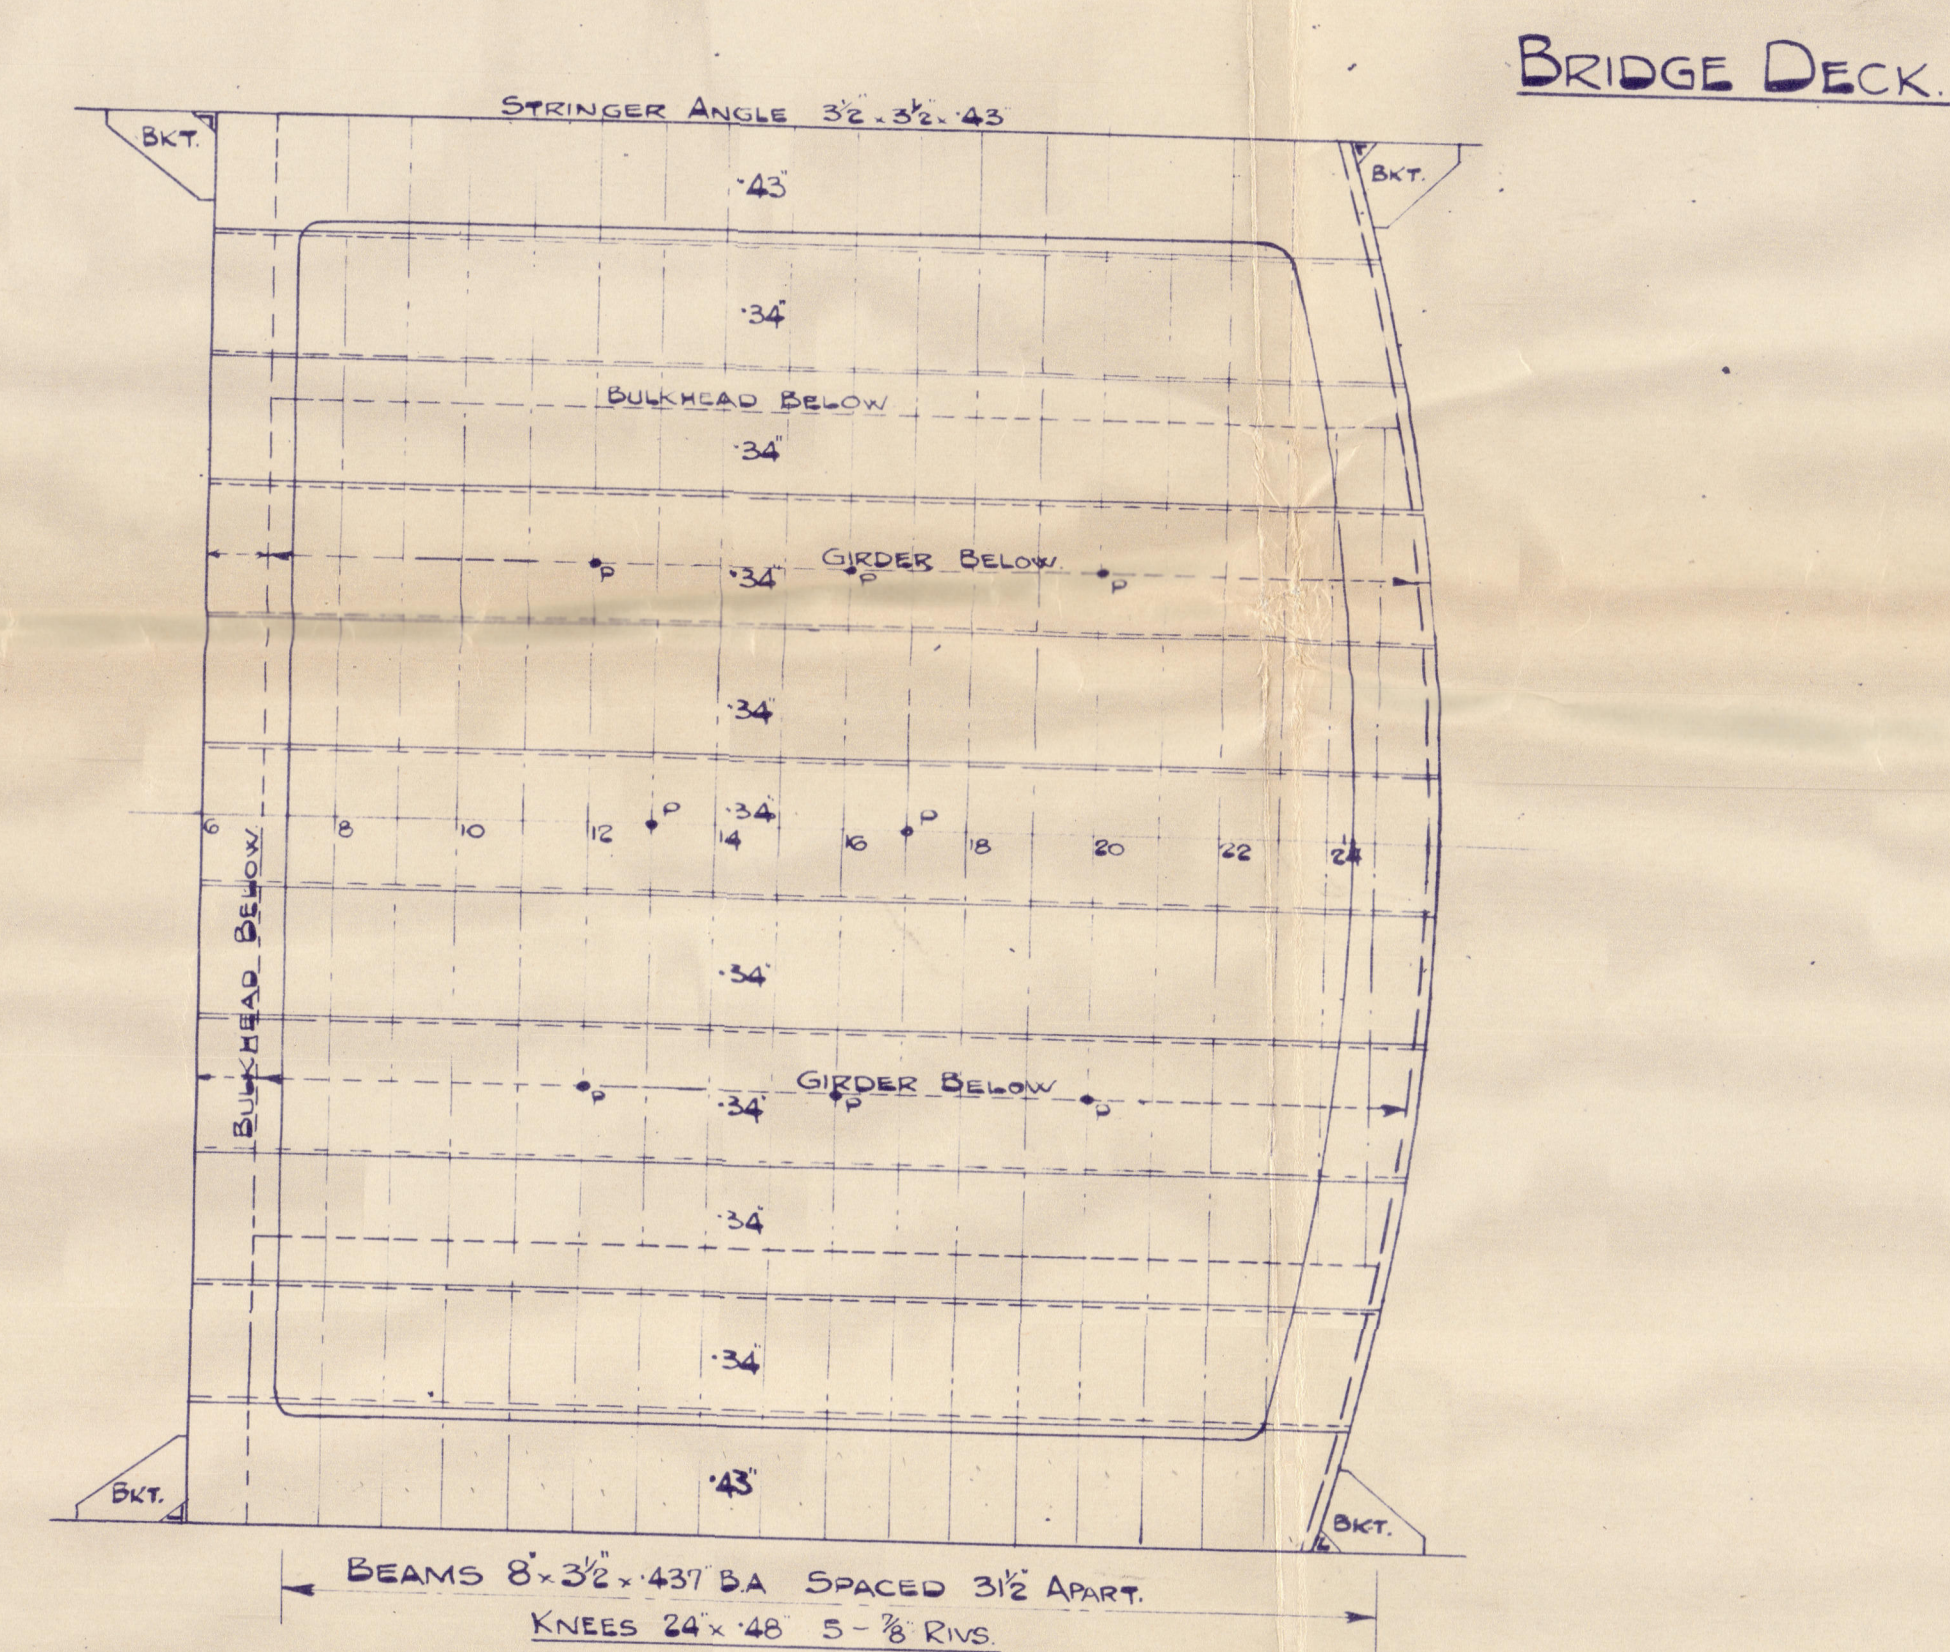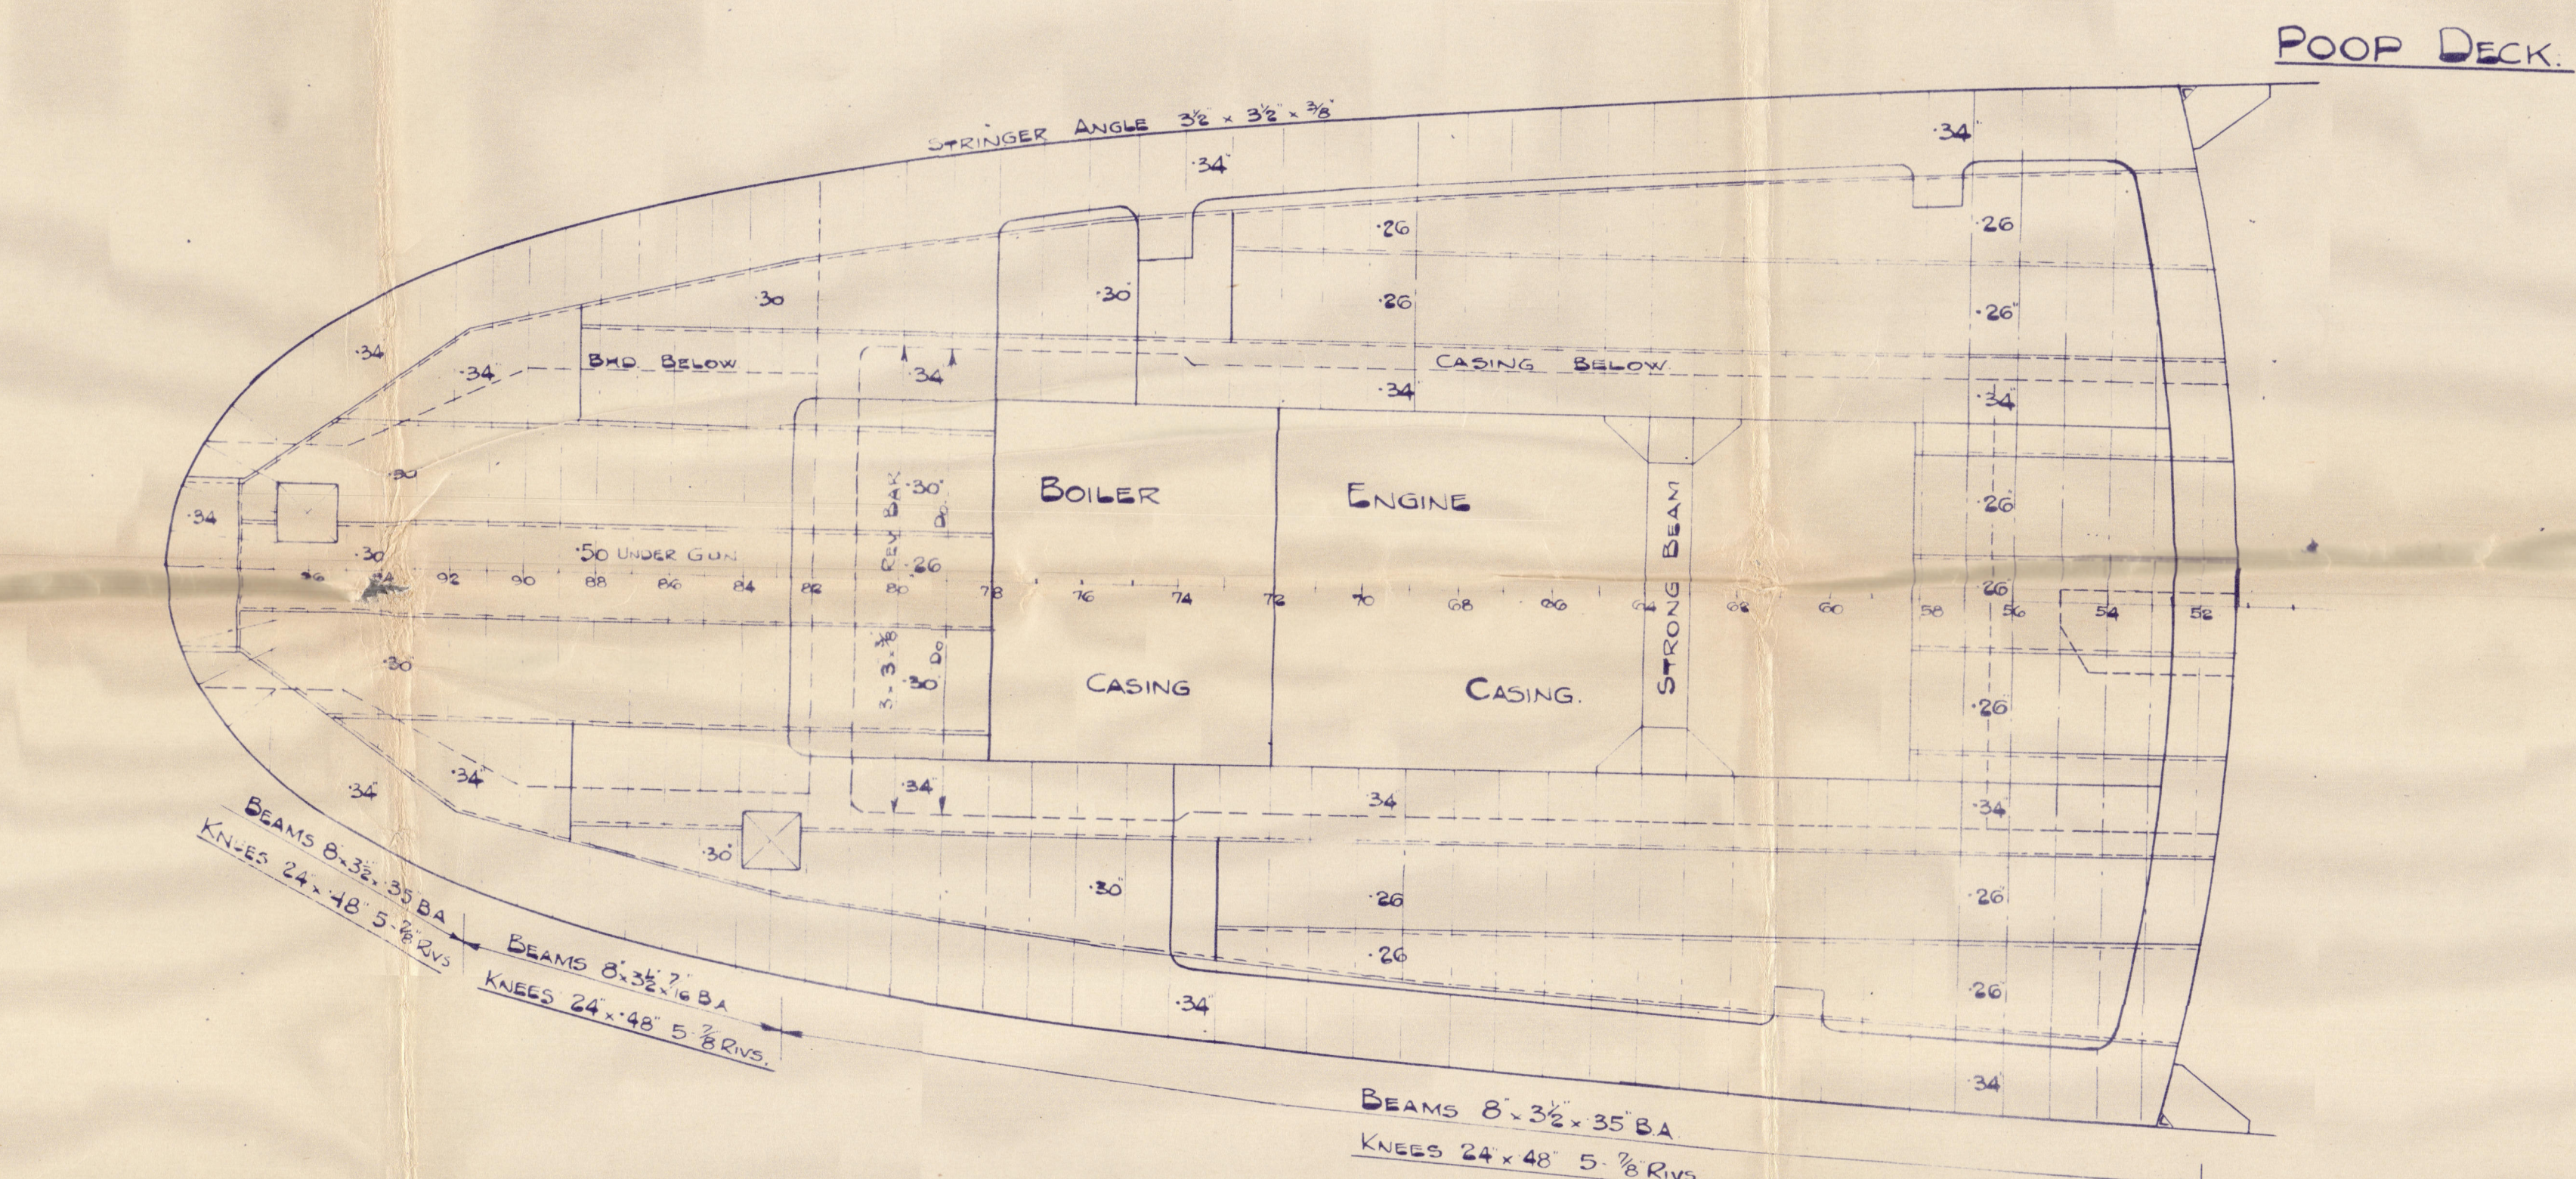

Holliday

(19)

HARLAND & WOLFF LTD.
BELFAST

No. 105913

TITLE Steel decks

DATE APPROVED not app.

app for 107819.

EX
Empire Diamond

N/N STORO

303-5



© 2020

Lloyd's Register
Foundation

003369-003376-0084