


PROFILE & DECK PLANS.

LENGTH B.P. 331'-0". BREADTH MLD 46'-6". DEPTH MLD 25'-6".

SCALE 1/8" = 1 FOOT.

S S 252.

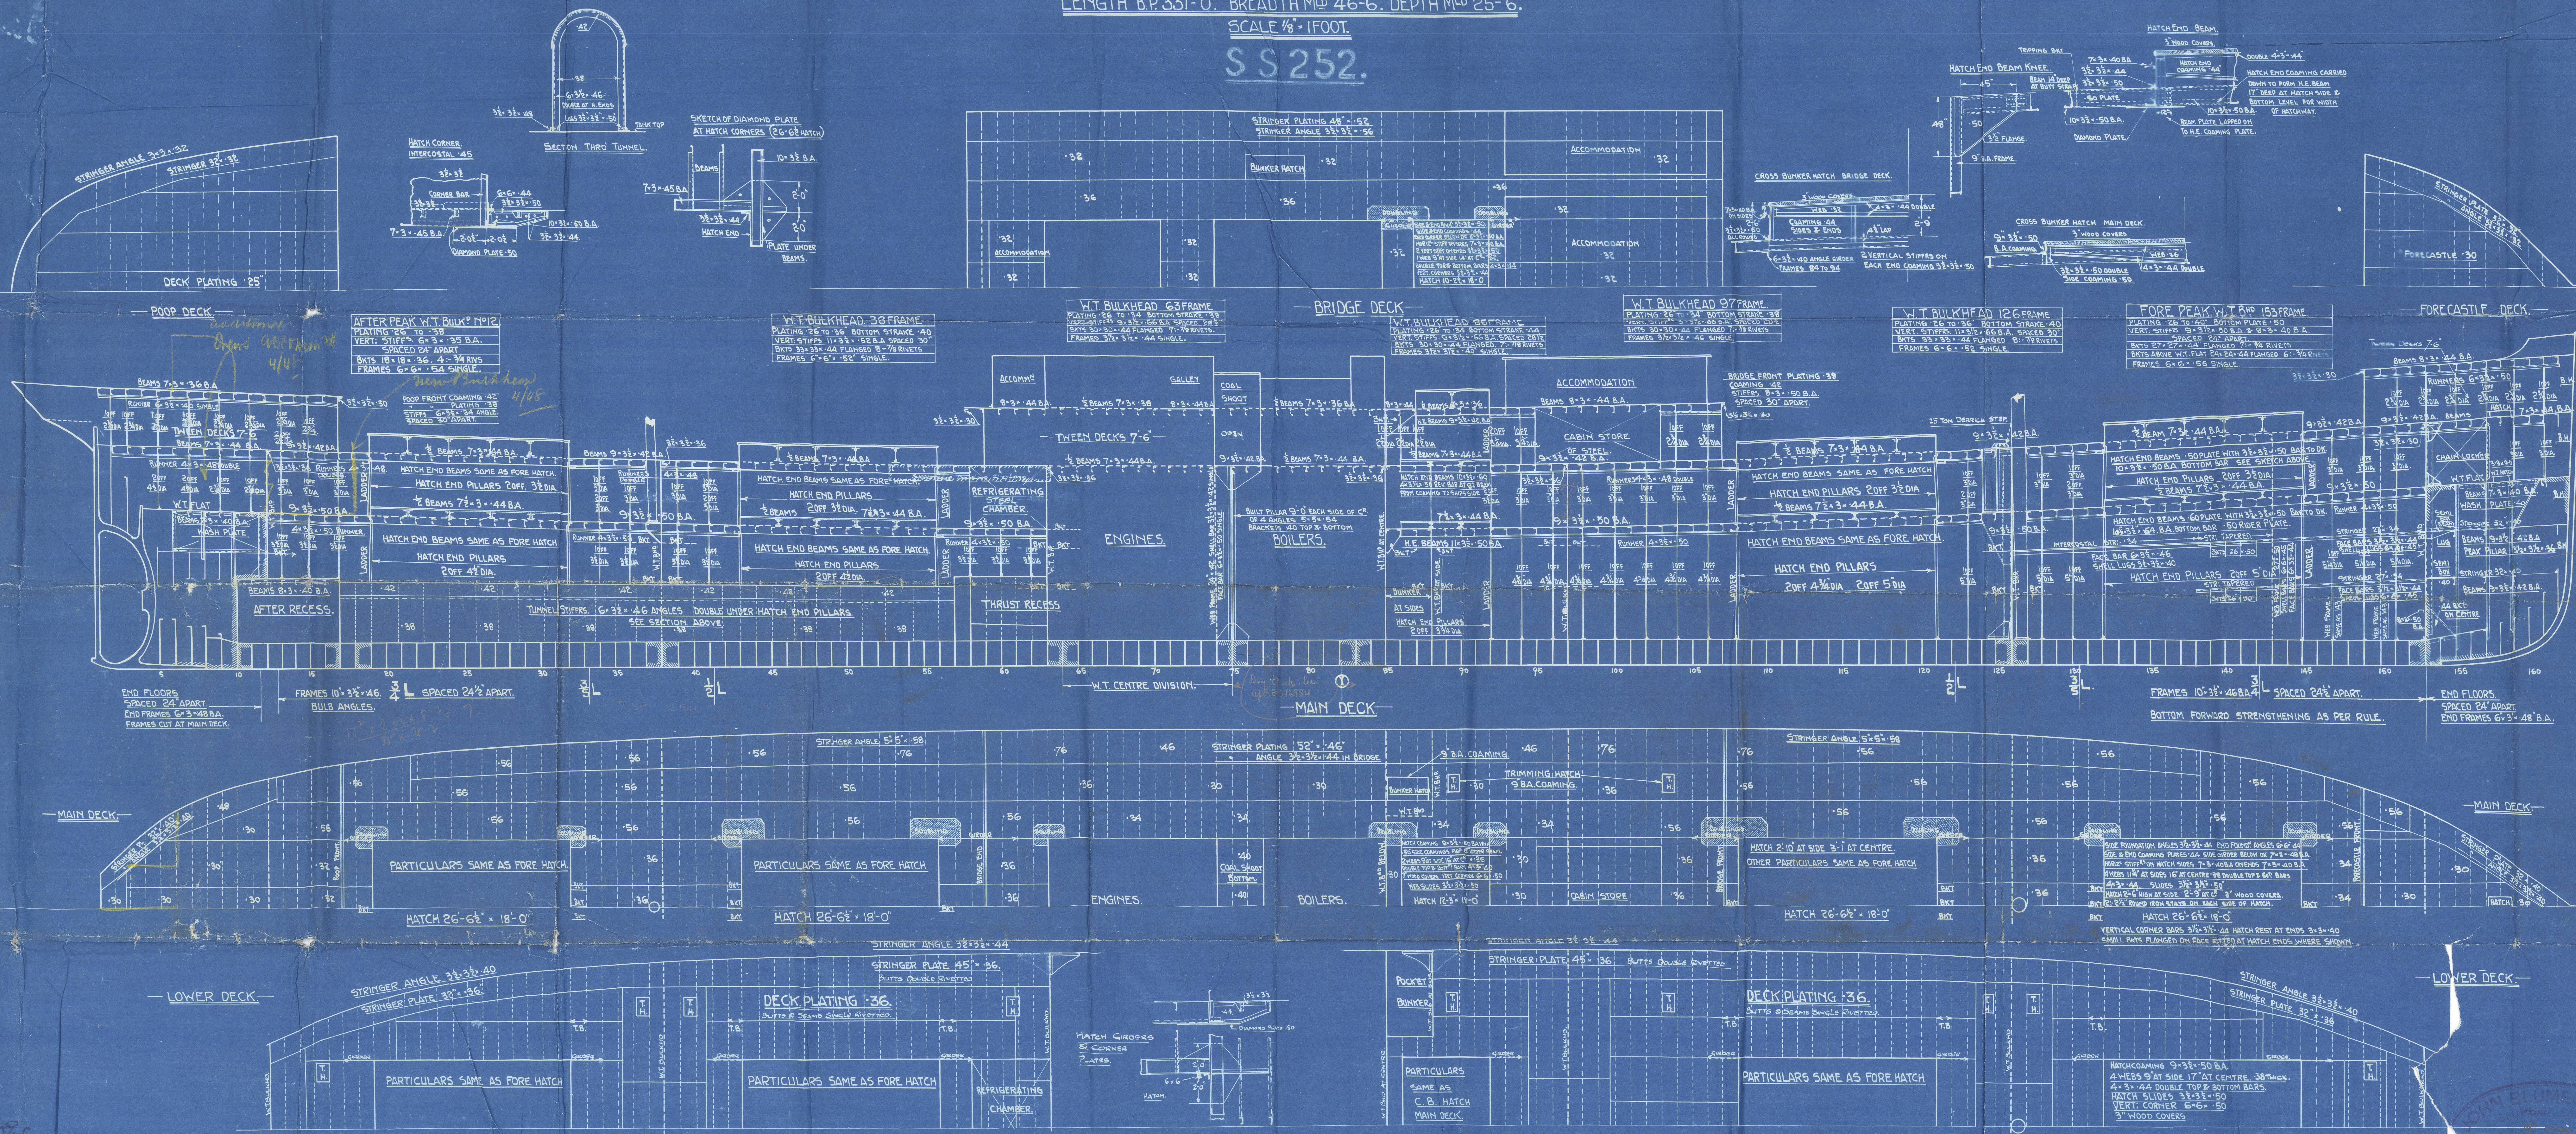

SUNDERLAND

MESSRS J. BLUMER & Co.


S/S "CYPRIAN PRINCE"

No 252

PROFILE (As BUILT) *Gloucester City*

SLO. RPT. No 27616 II

KADER BAKSH *

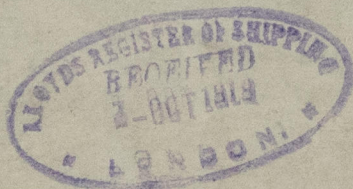

© 2020

Lloyd's Register
Foundation

003377-003384-0123