



S.S.

PRINCE

Cyprian Prince

ARRANGEMENT OF FASTENINGS ON W.T. DOORS AT BRIDGE FRONT.

SCALE 1" = 1 FOOT.

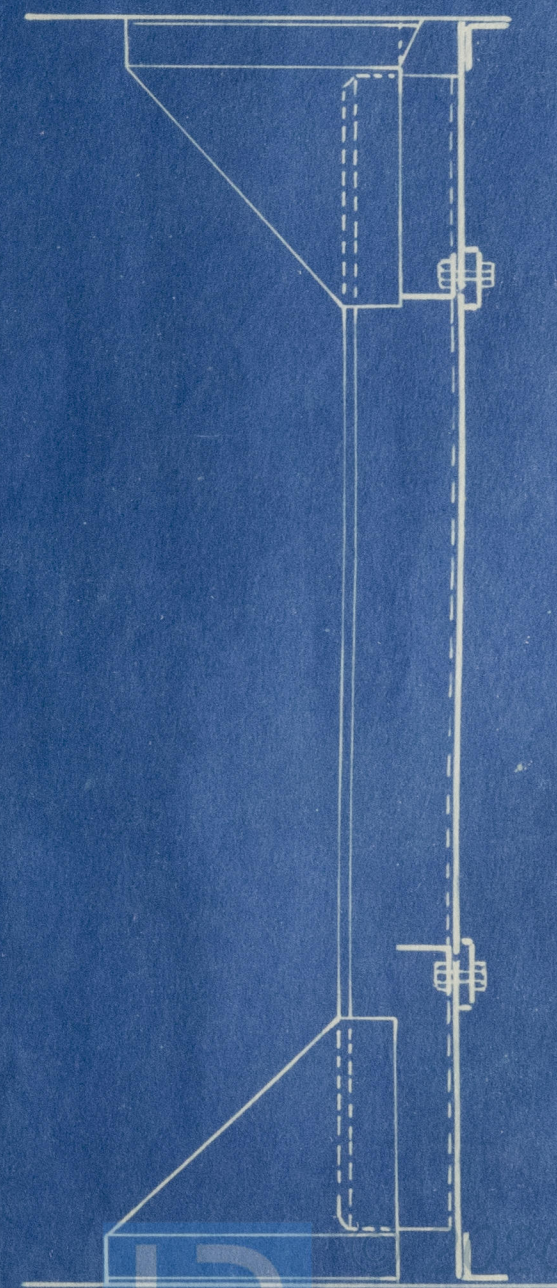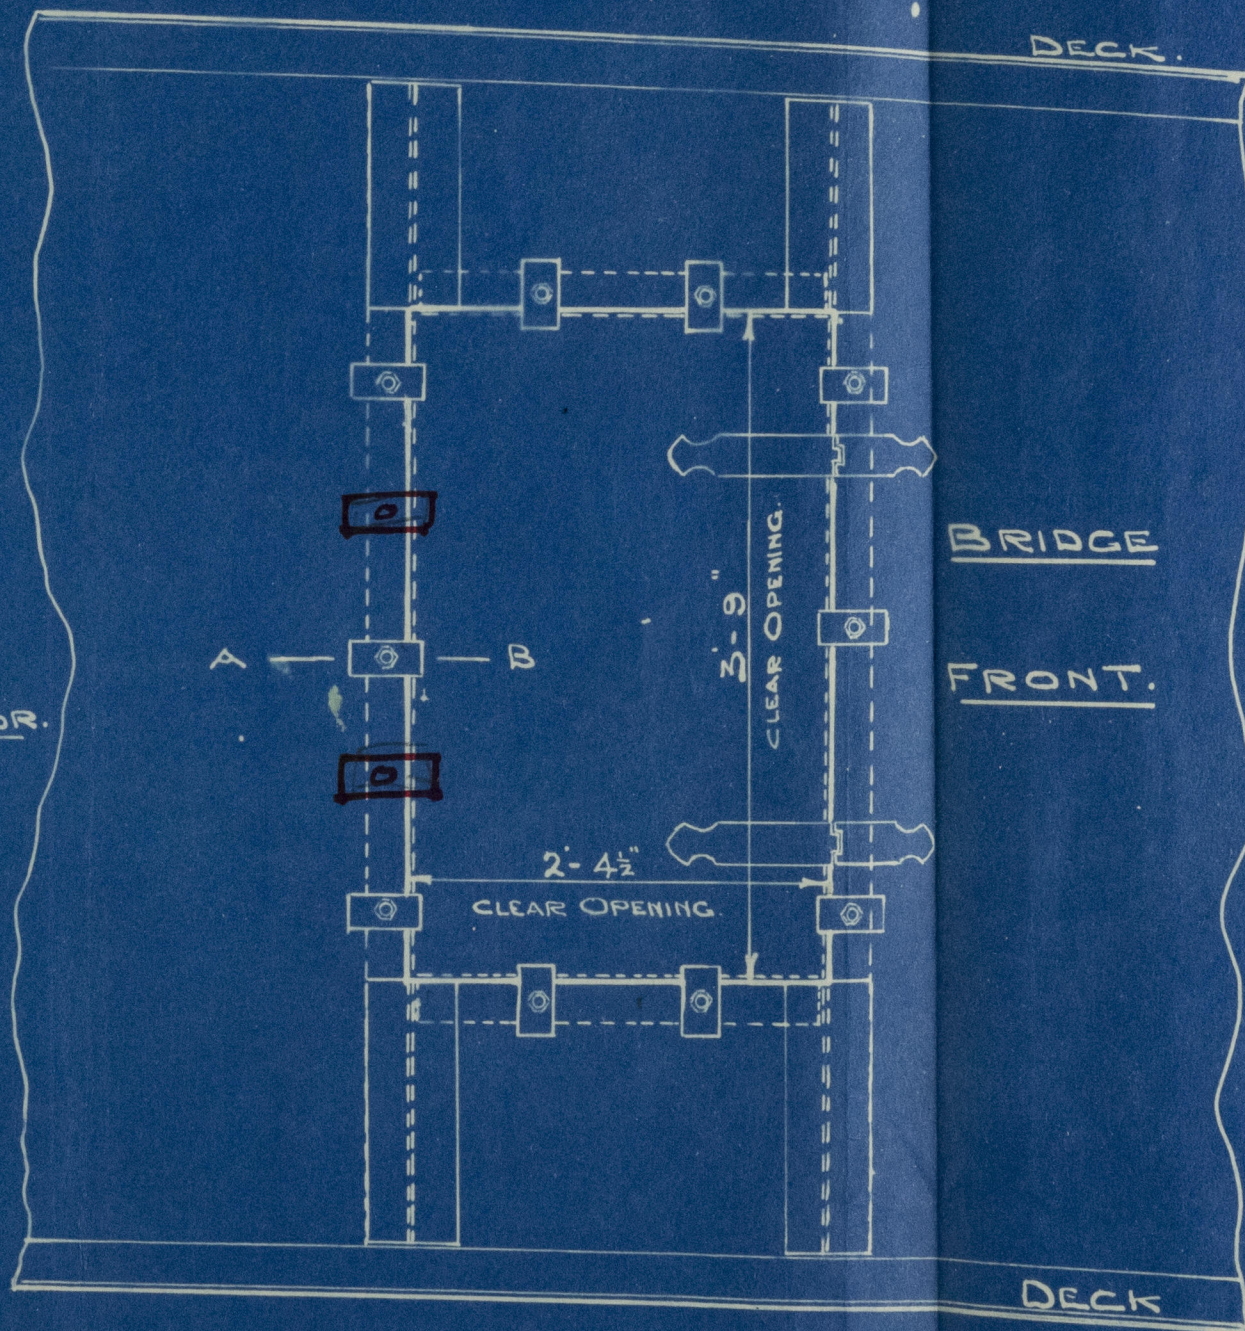

Handwritten signature and date 11.5.32



Lloyd's Register Foundation