

24 MAR 1939


LENGTH B.P. - 231'-0"; BREADTH M.L.P. - 36'-6"; DEPTH M.L.P. - 15'-0".

SCALE:- $\frac{1}{8}" = 1$ FOOT.

NOTE:- THIS DRAWING IS THE PROPERTY OF THE ANGLO-SAXON PETROLEUM CO. LTD. AND IS ISSUED SUBJECT TO THE REQUIREMENTS OF THE SPECIFICATION AND CONTRACT BEING COMPLIED WITH, WITHOUT PREJUDICE.

THE ANGLO-SAXON PETROLEUM Co. LTD.

MARINE SUPT (C.ZULVER)

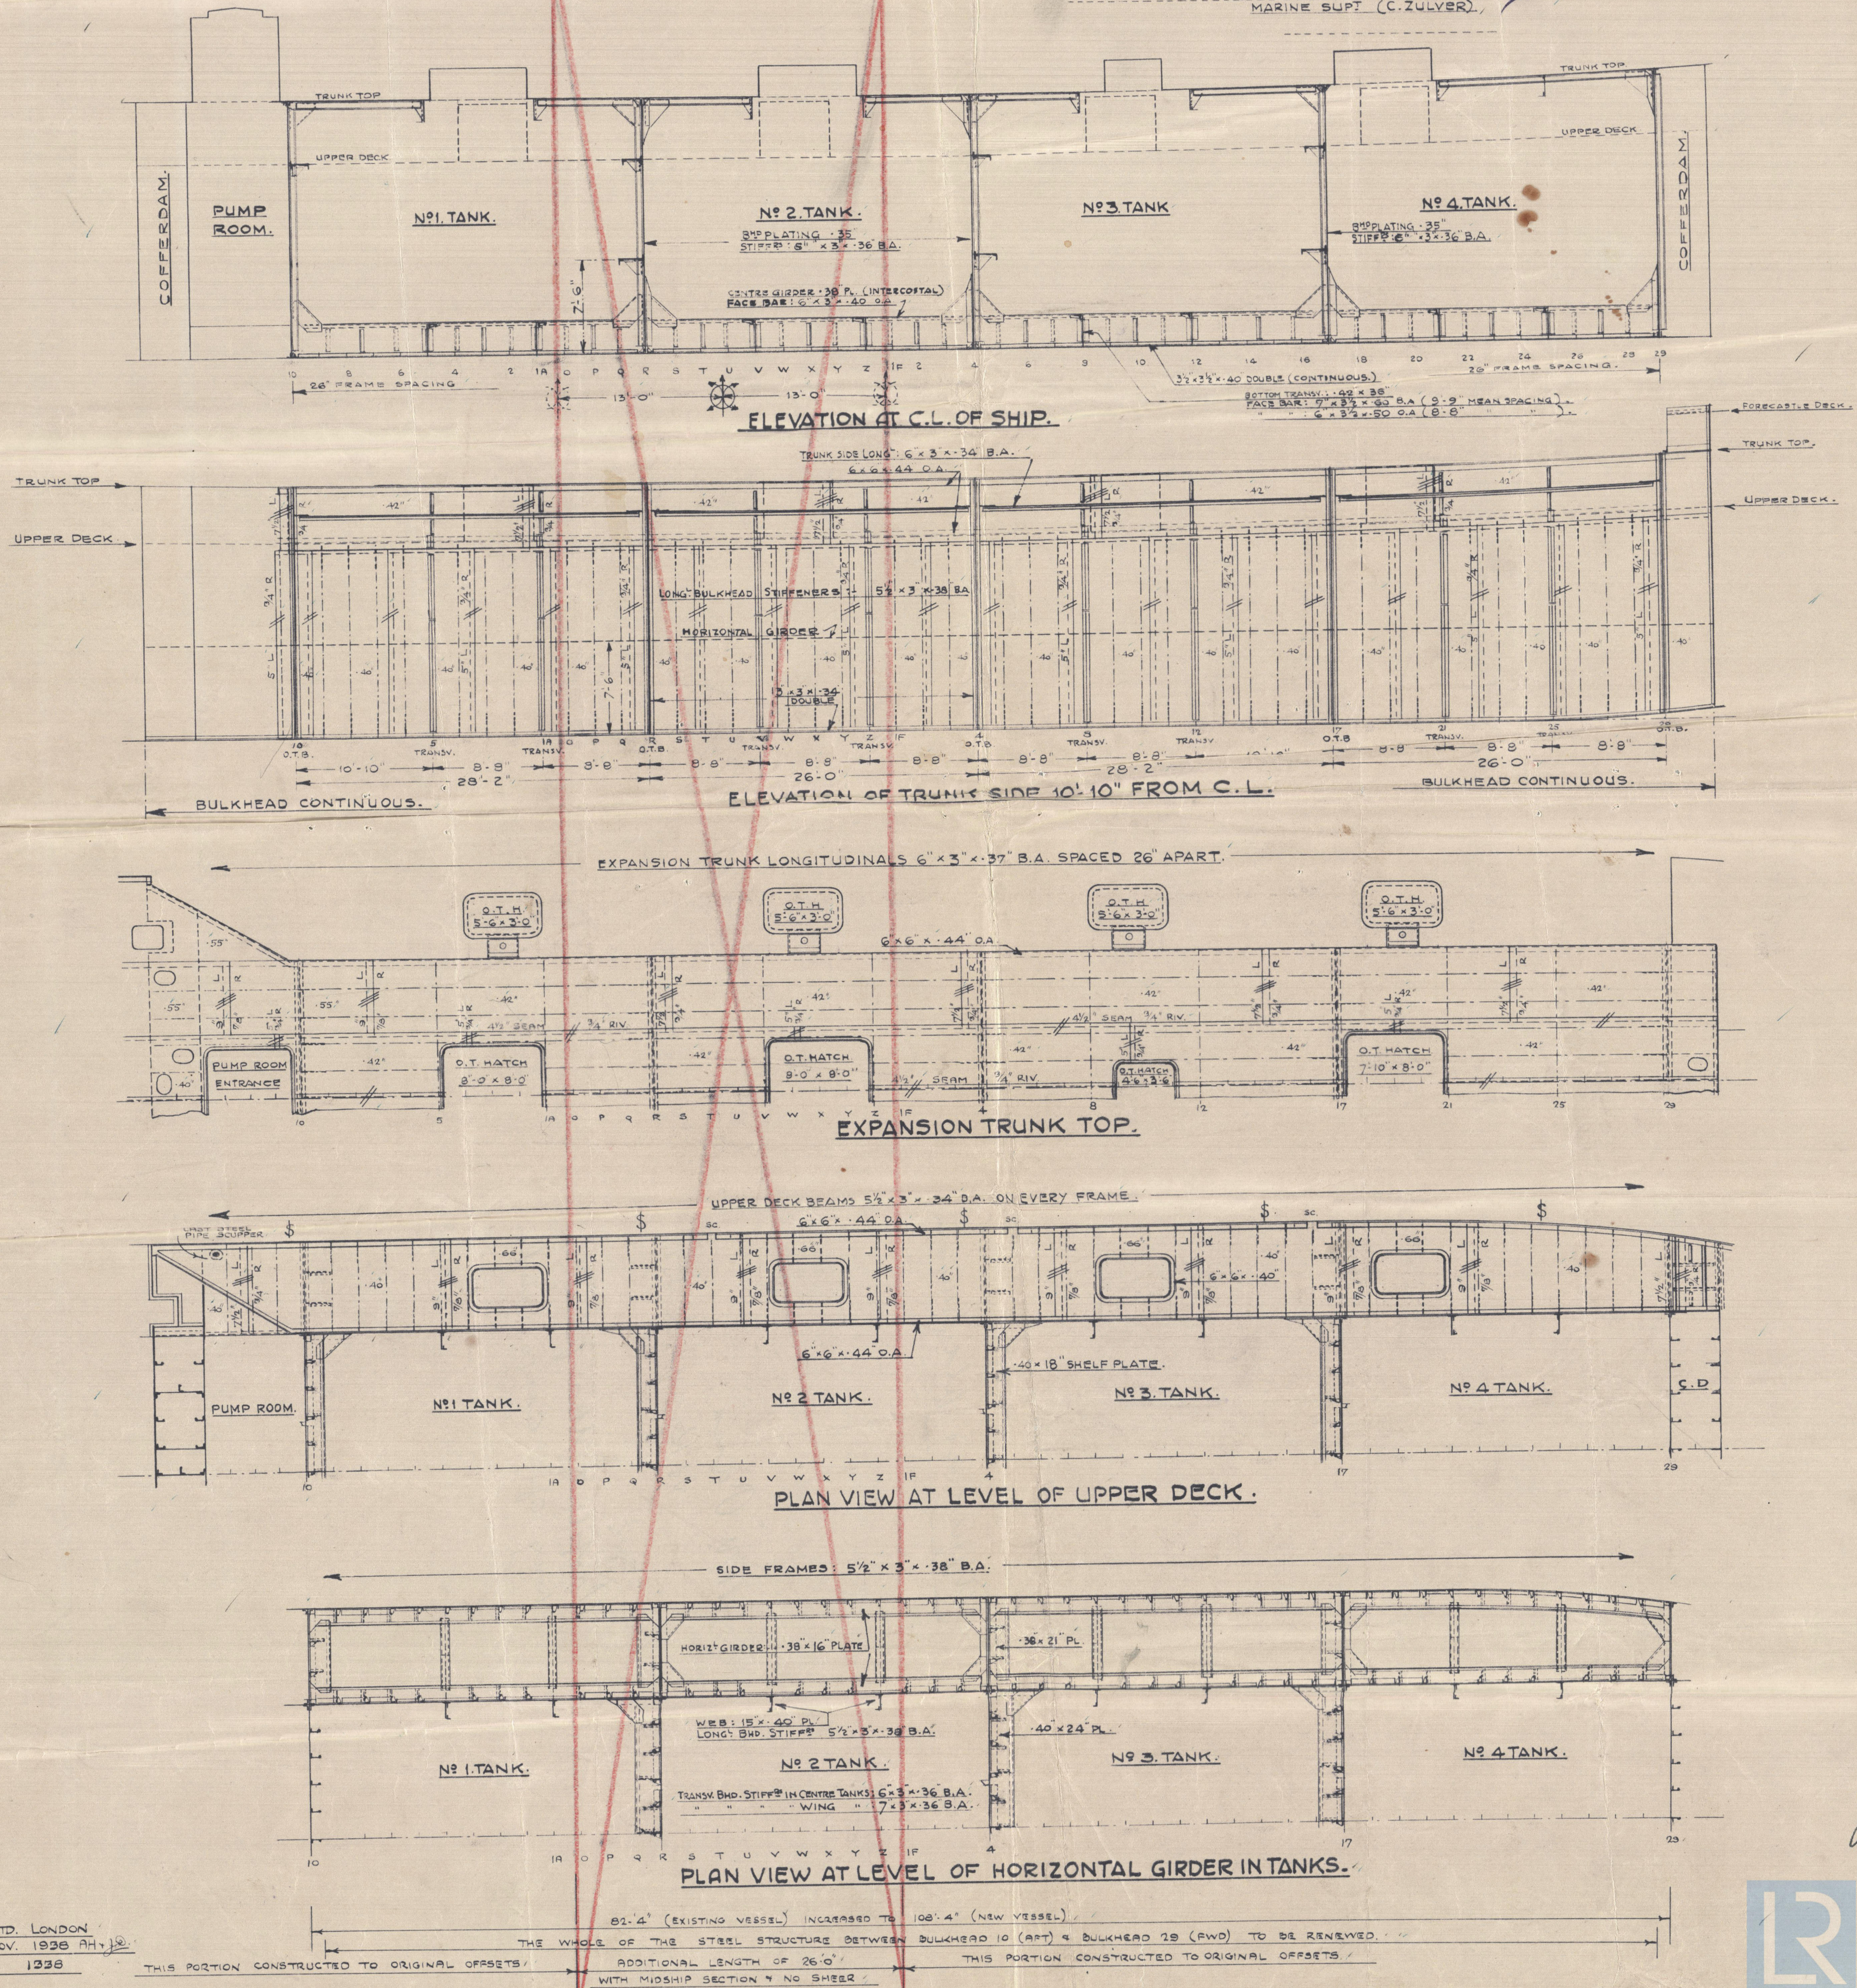

A.S.P.C. LTD. LONDON
8TH NOV. 1938 AH + jo.
D.O. No 1338

© 2020
Lloyd's Register
Foundation

003385-003390-0034

Approved plan (attaching)

M. J. Pava.

H. K. g. m. No 8513.

Part
Profile & the plan ⁱⁿ the
way of cargo tanks