

8/9/19

VICKERS T. S. S. N^{OS} 573, 4, 5. BEARDMORES N^{OS} 616.17.




RUDDER & STERNPOST.

SCALE 1/2 INCH = ONE FOOT.

DETAILS 1/2 INCHES = ONE FOOT.


PARTICULARS.

SPEED AT SEA	15 KNOTS
ANGLE OF RUDDER	40°
DRAFT OF SHIP	29'-0"
AREA OF RUDDER	185 sq. A & D. 788
DIA OF RUDDER HEAD	13 1/2 DIA.
MATERIAL.	
RUDDER STOCK & MAIN PIECE	FORGED STEEL
RUDDER ARMS	WROUGHT IRON OR FORGED STEEL
STERNPOST	CAST STEEL
ALL TO PASS BOTH LLOYD'S & BOARD OF TRADE TESTS.	

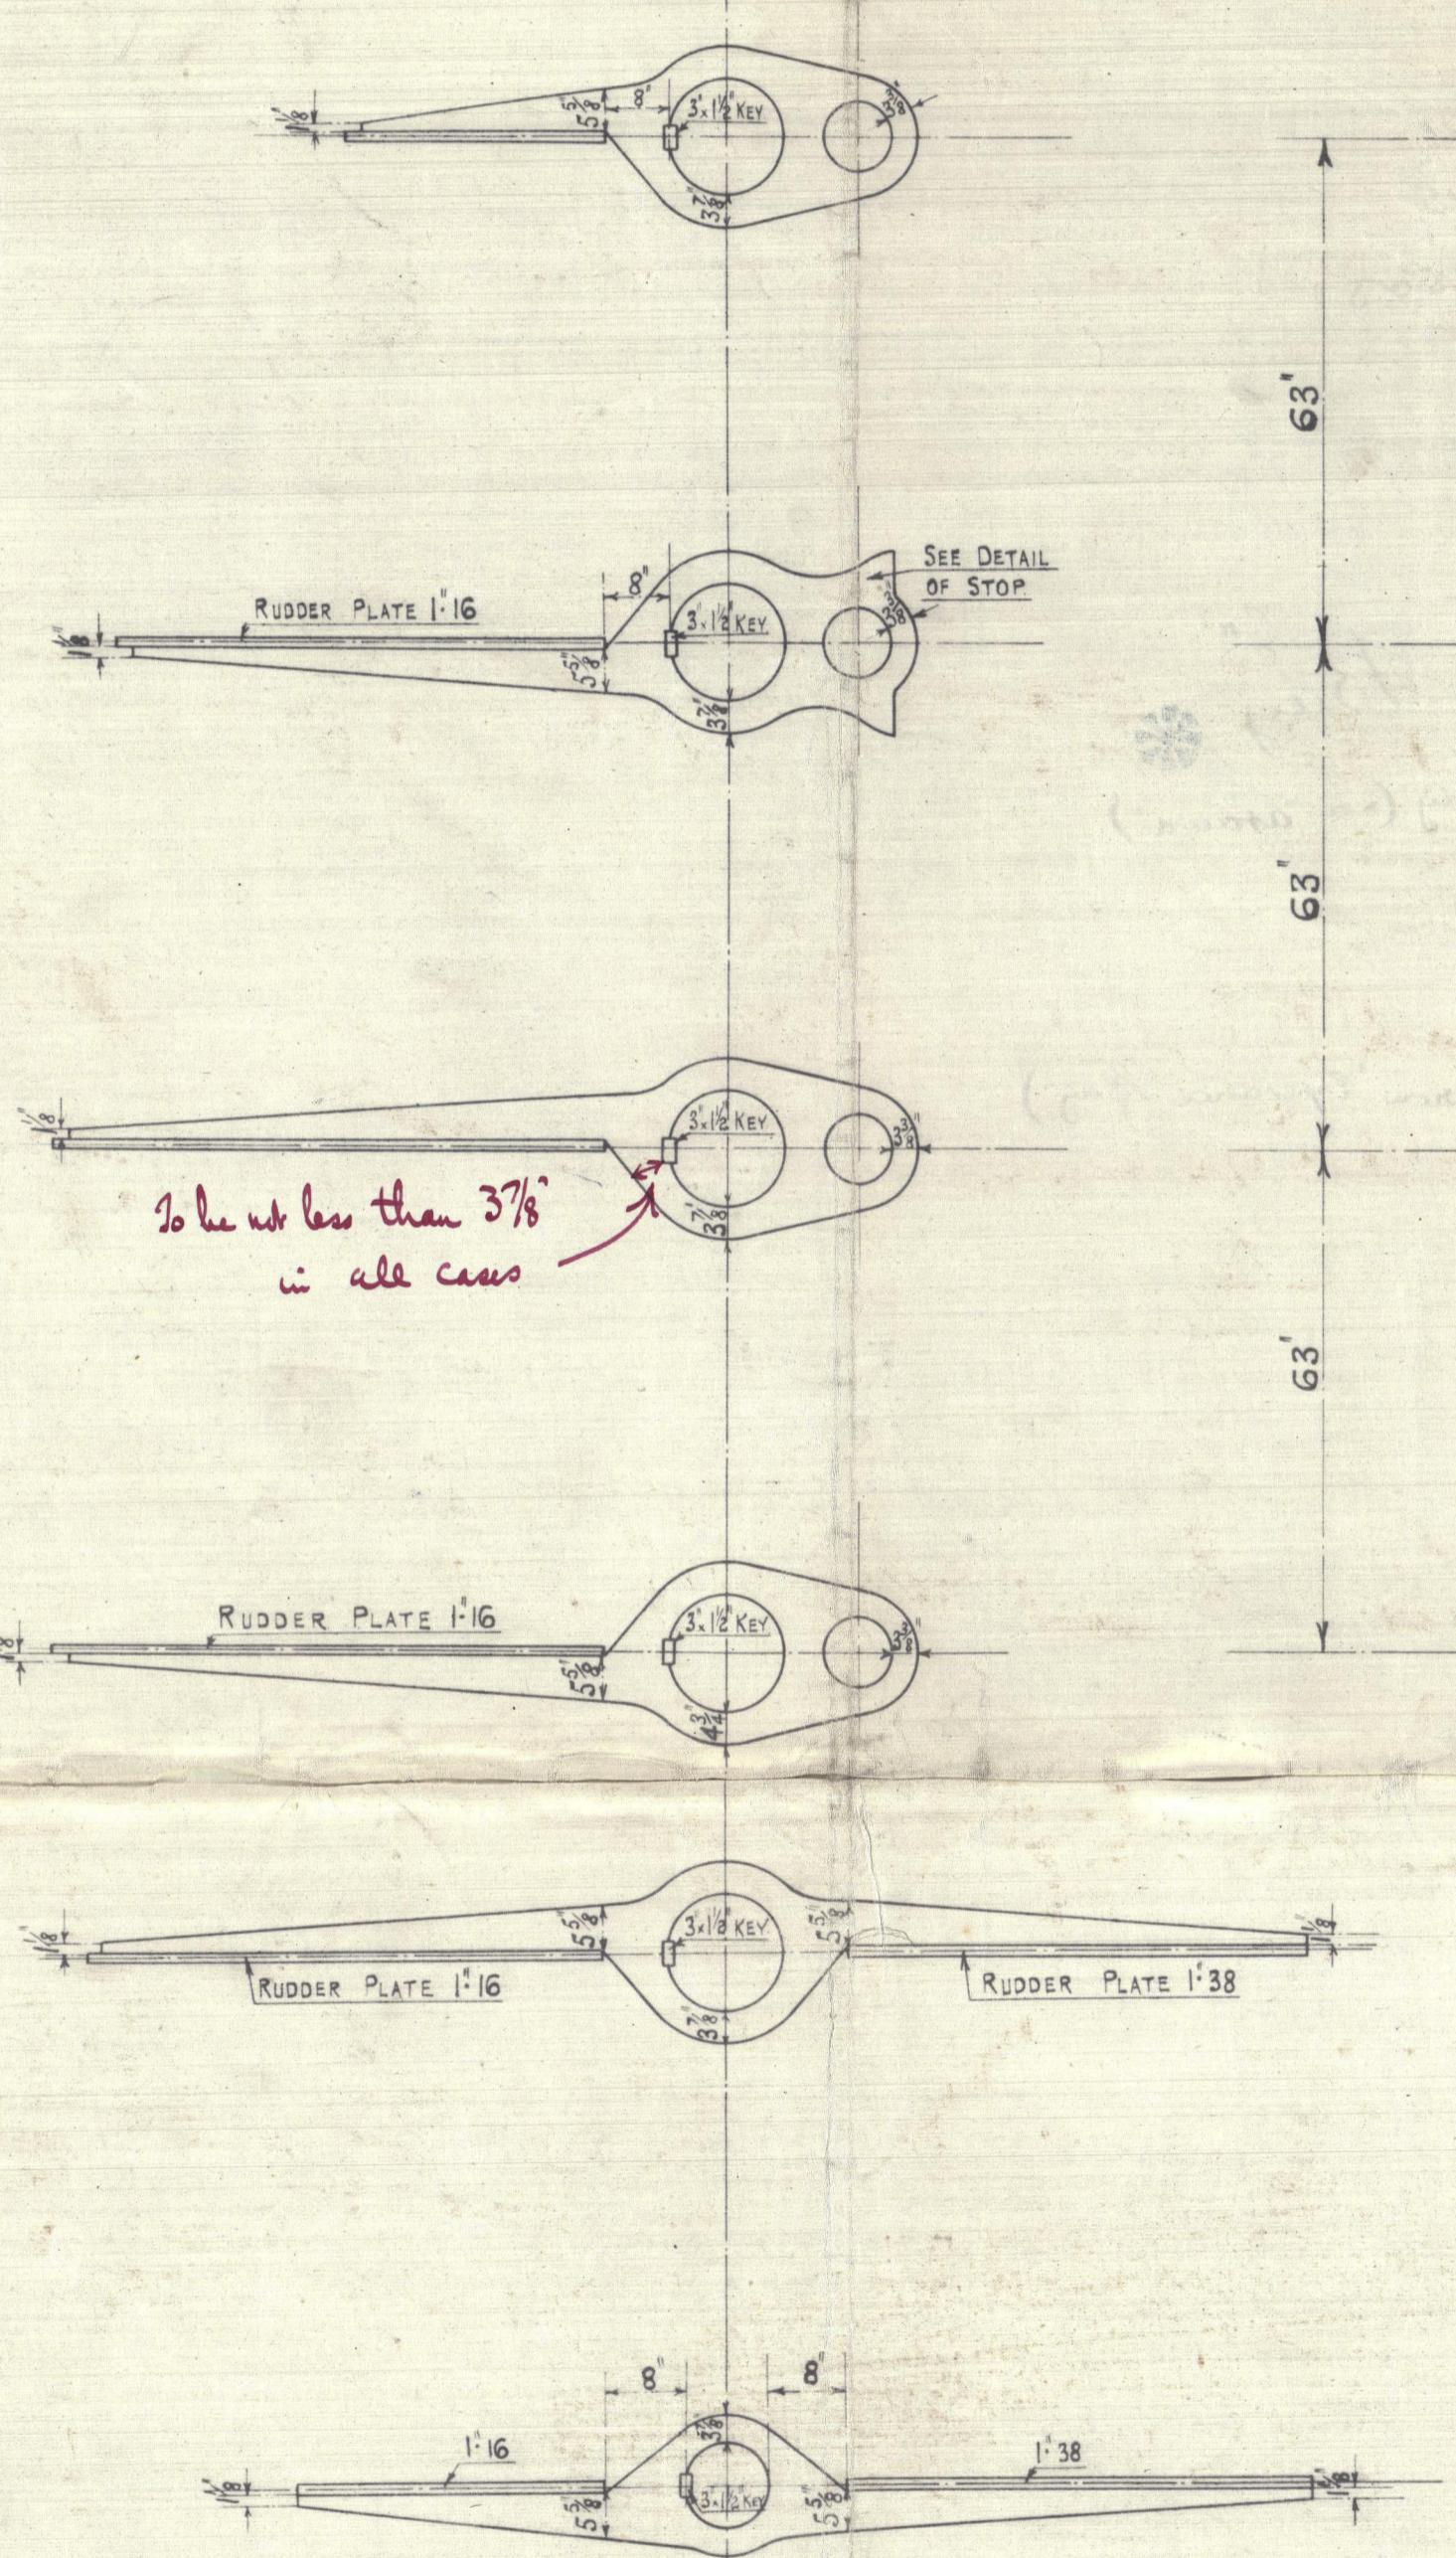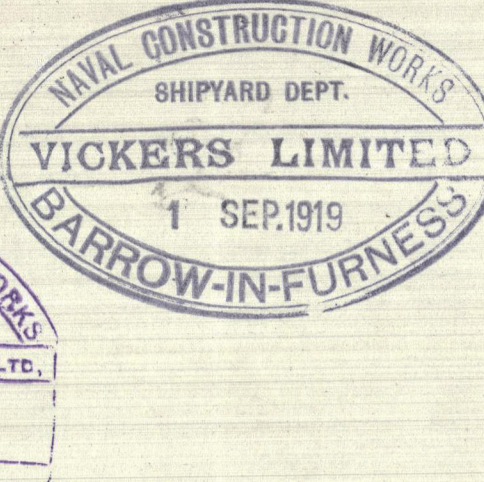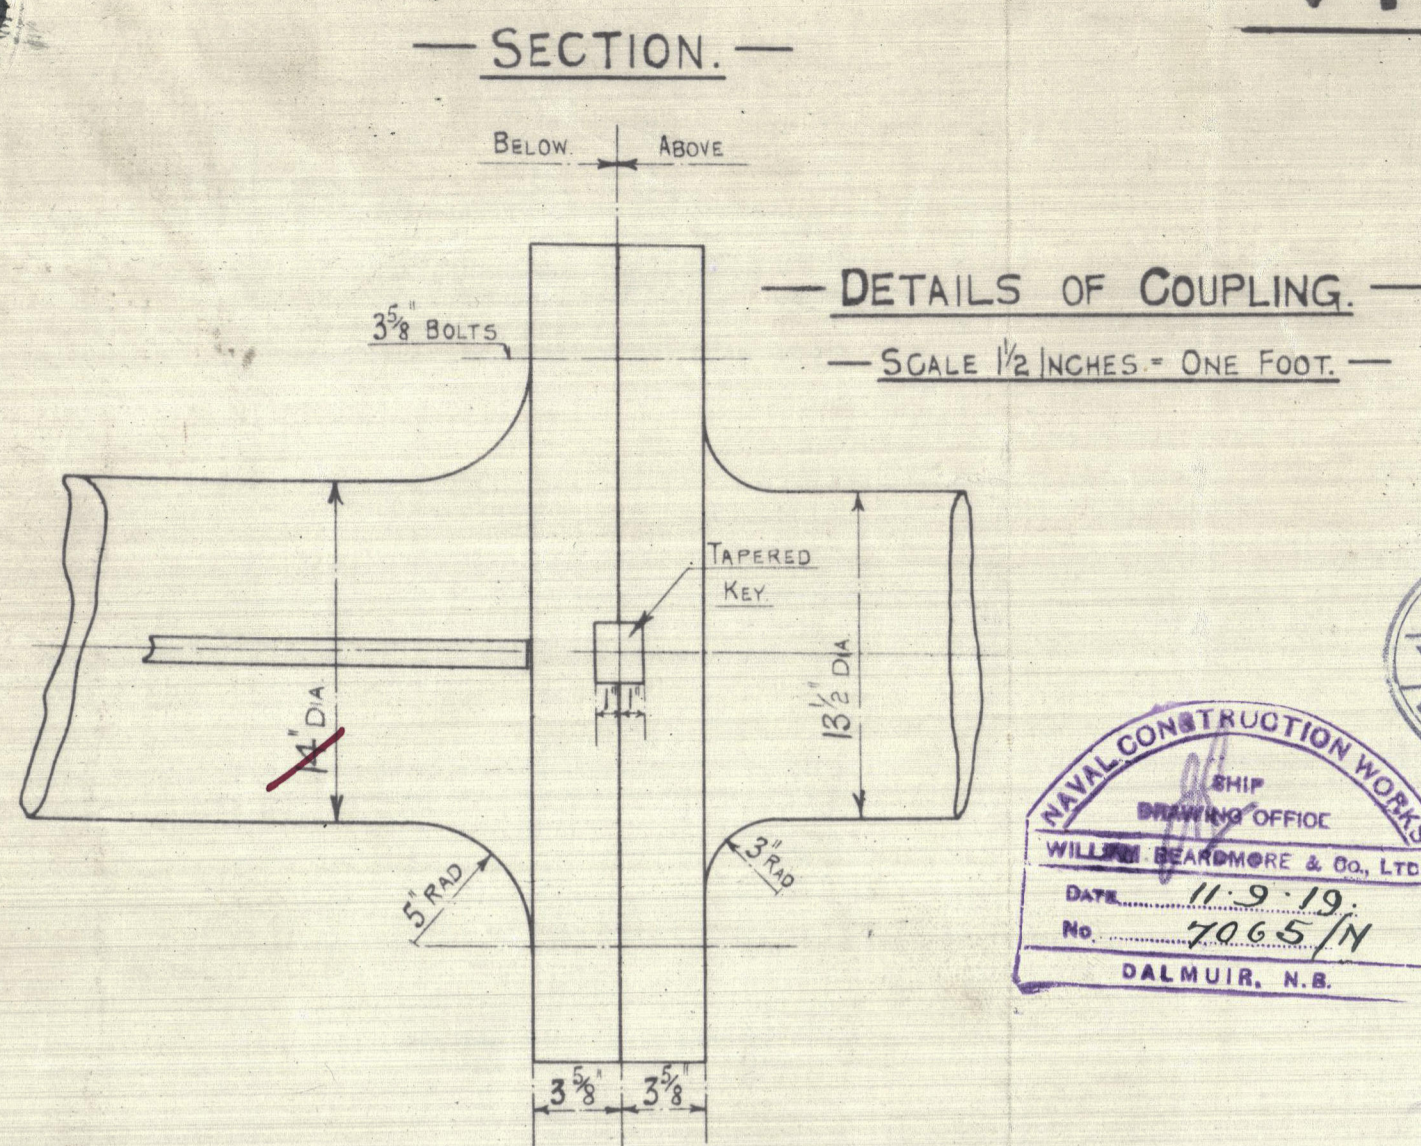

Beardmore's 616-17

Rudder & Sternpost

T.S.S. "Largs Bay" 

GLASGOW REPORT No. 41619


T.S.S. "Esperance Bay."

GLASGOW REPORT No. 42050.

Vickers Ltd
Nos 573, 445

Beardmore & Co's
Nos 616 & 17

Rudder & Sternpost

616 - "Largs Bay" 
617 - "Esperance Bay (now 'Atawa')"

Vickers, Ltd,

573 - Moten Bay.

574 - Holsons Bay (now 'Esperance Bay')

575 - Jervis Bay.



© 2020

Lloyd's Register
Foundation

003385-003390-0184