



# Lloyd's Register of Shipping.

Ship's Name NARVA Official No. 180728.

Memorandum of alterations reported since ship was surveyed for assignment of Load Lines in 1945.

CARGO HATCHES (MACGREGOR. PATENT).

RAISED QUARTER DECK ----->|<----- UPPER DECK.

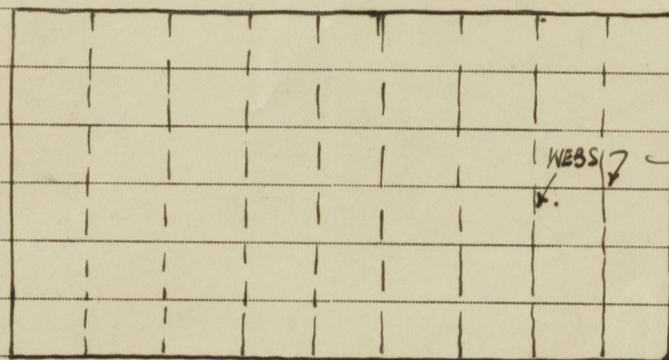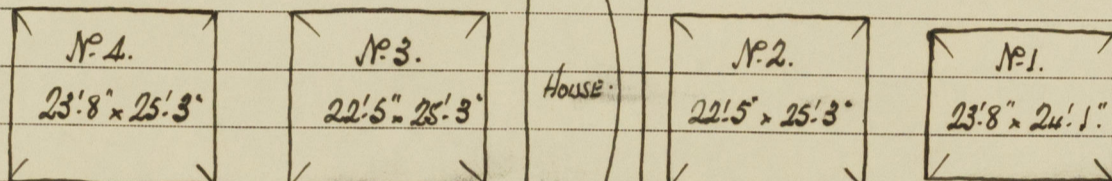


HATCH TOP.  
PLATE (TAPERED TO 6" AT SIDES)  
FLAT.  
ALL WELDED CONSTRUCTION.

PLAN OF STEEL COVERS.

	No. 1	No. 2	No. 3	No. 4
WEB. PLATE (AT CR.)	12" x 30	12 1/2" x 30.	12 1/2" x 30.	12 1/2" x 30
" FLAT.	7" x 64. 61. 58	7" x 57. 59. 64.	7" x 45. 48. 52	7" x 48. 51. 53.
" SPACING.	29 1/2" to 32 3/4"	27 1/2" to 31 1/2"	27 1/2" to 31 1/2"	29 1/2" to 32 3/4"
STEEL COVERS.	.31.	.30.	.26.	.27.
CLATS SPACED.	36" to 39"	36" to 39"	36" to 39"	36" to 39"
<----- NO TARPULINS ----->				
<----- LASHINGS AS PER RULE ----->				

## SECTION AT COAMINGS.

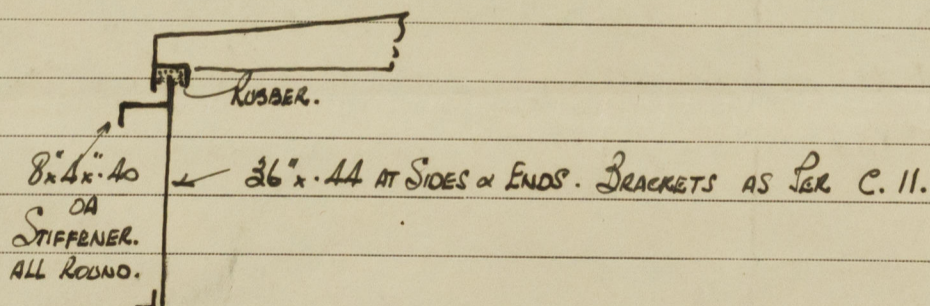

Constructed as per approved plans.

*[Signature]*  
6.6.49.