

Nº 696-7. 701-2 ^{24/11/5}

PROFILE & DECK PLAN.

DIMENSIONS: 117'-0" x 22'-0" x 13'-0".

SCALE: 1/4 IN. = 1 FOOT.




Lloyds.

RIVETING PARTICULARS			DIA	SPACING
RIVETS THRO	BEAMS AND STRINGER PLATES	DECK	5/8	5 DWS.
"	"	STRINGER ANGLE & DECK	"	7 "
"	"	GROUND BARS & DECK	"	4 1/2 "
"	"	STRINGER BUTTS	"	7 "
"	"	GROUND BARS & CASINGS	"	5 "
"	"	4 1/2 x 4 1/2 CASING GROUND BAR & CASINGS	5/8	As per sketch
"	"	DECK TIE PLATE BUTTS	5/8	4 DWS.
"	"	SEAMS OF DECK PLATING	"	6 1/2 " 6 dws when sheathed
"	"	STRINGER ANGLE TO SHELL	3/4	4 1/2 "

NOTE

ATHWARTSHIP PLANKS TO BE LAID AT THE FORE AND AFT ENDS OF ALL STEEL DECK HOUSES, HATCH COAMINGS, AND SKYLIGHTS.

MATERIAL (SECTIONS)					REMARK
MARK	NO. OF	LENGTH	SCANTLING		
D.G. 1	2	26'-0"	3" x 2 1/2" x 30		CHEQUERED PLATE GROUND BARS
D.G. 2	1	84'-6"	3 1/2" x 5" x 30		WHEELHOUSE & AFT END CASING
3	1	24'-0"	2 1/2" x 2 1/2" x 25		GALLEY GROUND BAR
4	2	37'-0"	4 1/2" x 4 1/2" x 40		GASING GROUND BAR
D.S. 1	2	50'-0"	5" x 3" x 30		AFT
2	2	32'-0"	"		FORO
3	4	31'-0"	3" x 3" x 36		AMIDSHIPS
D	2	40'-6"	2 1/2" x 2 1/2" x 30		GUTTER ANGLES

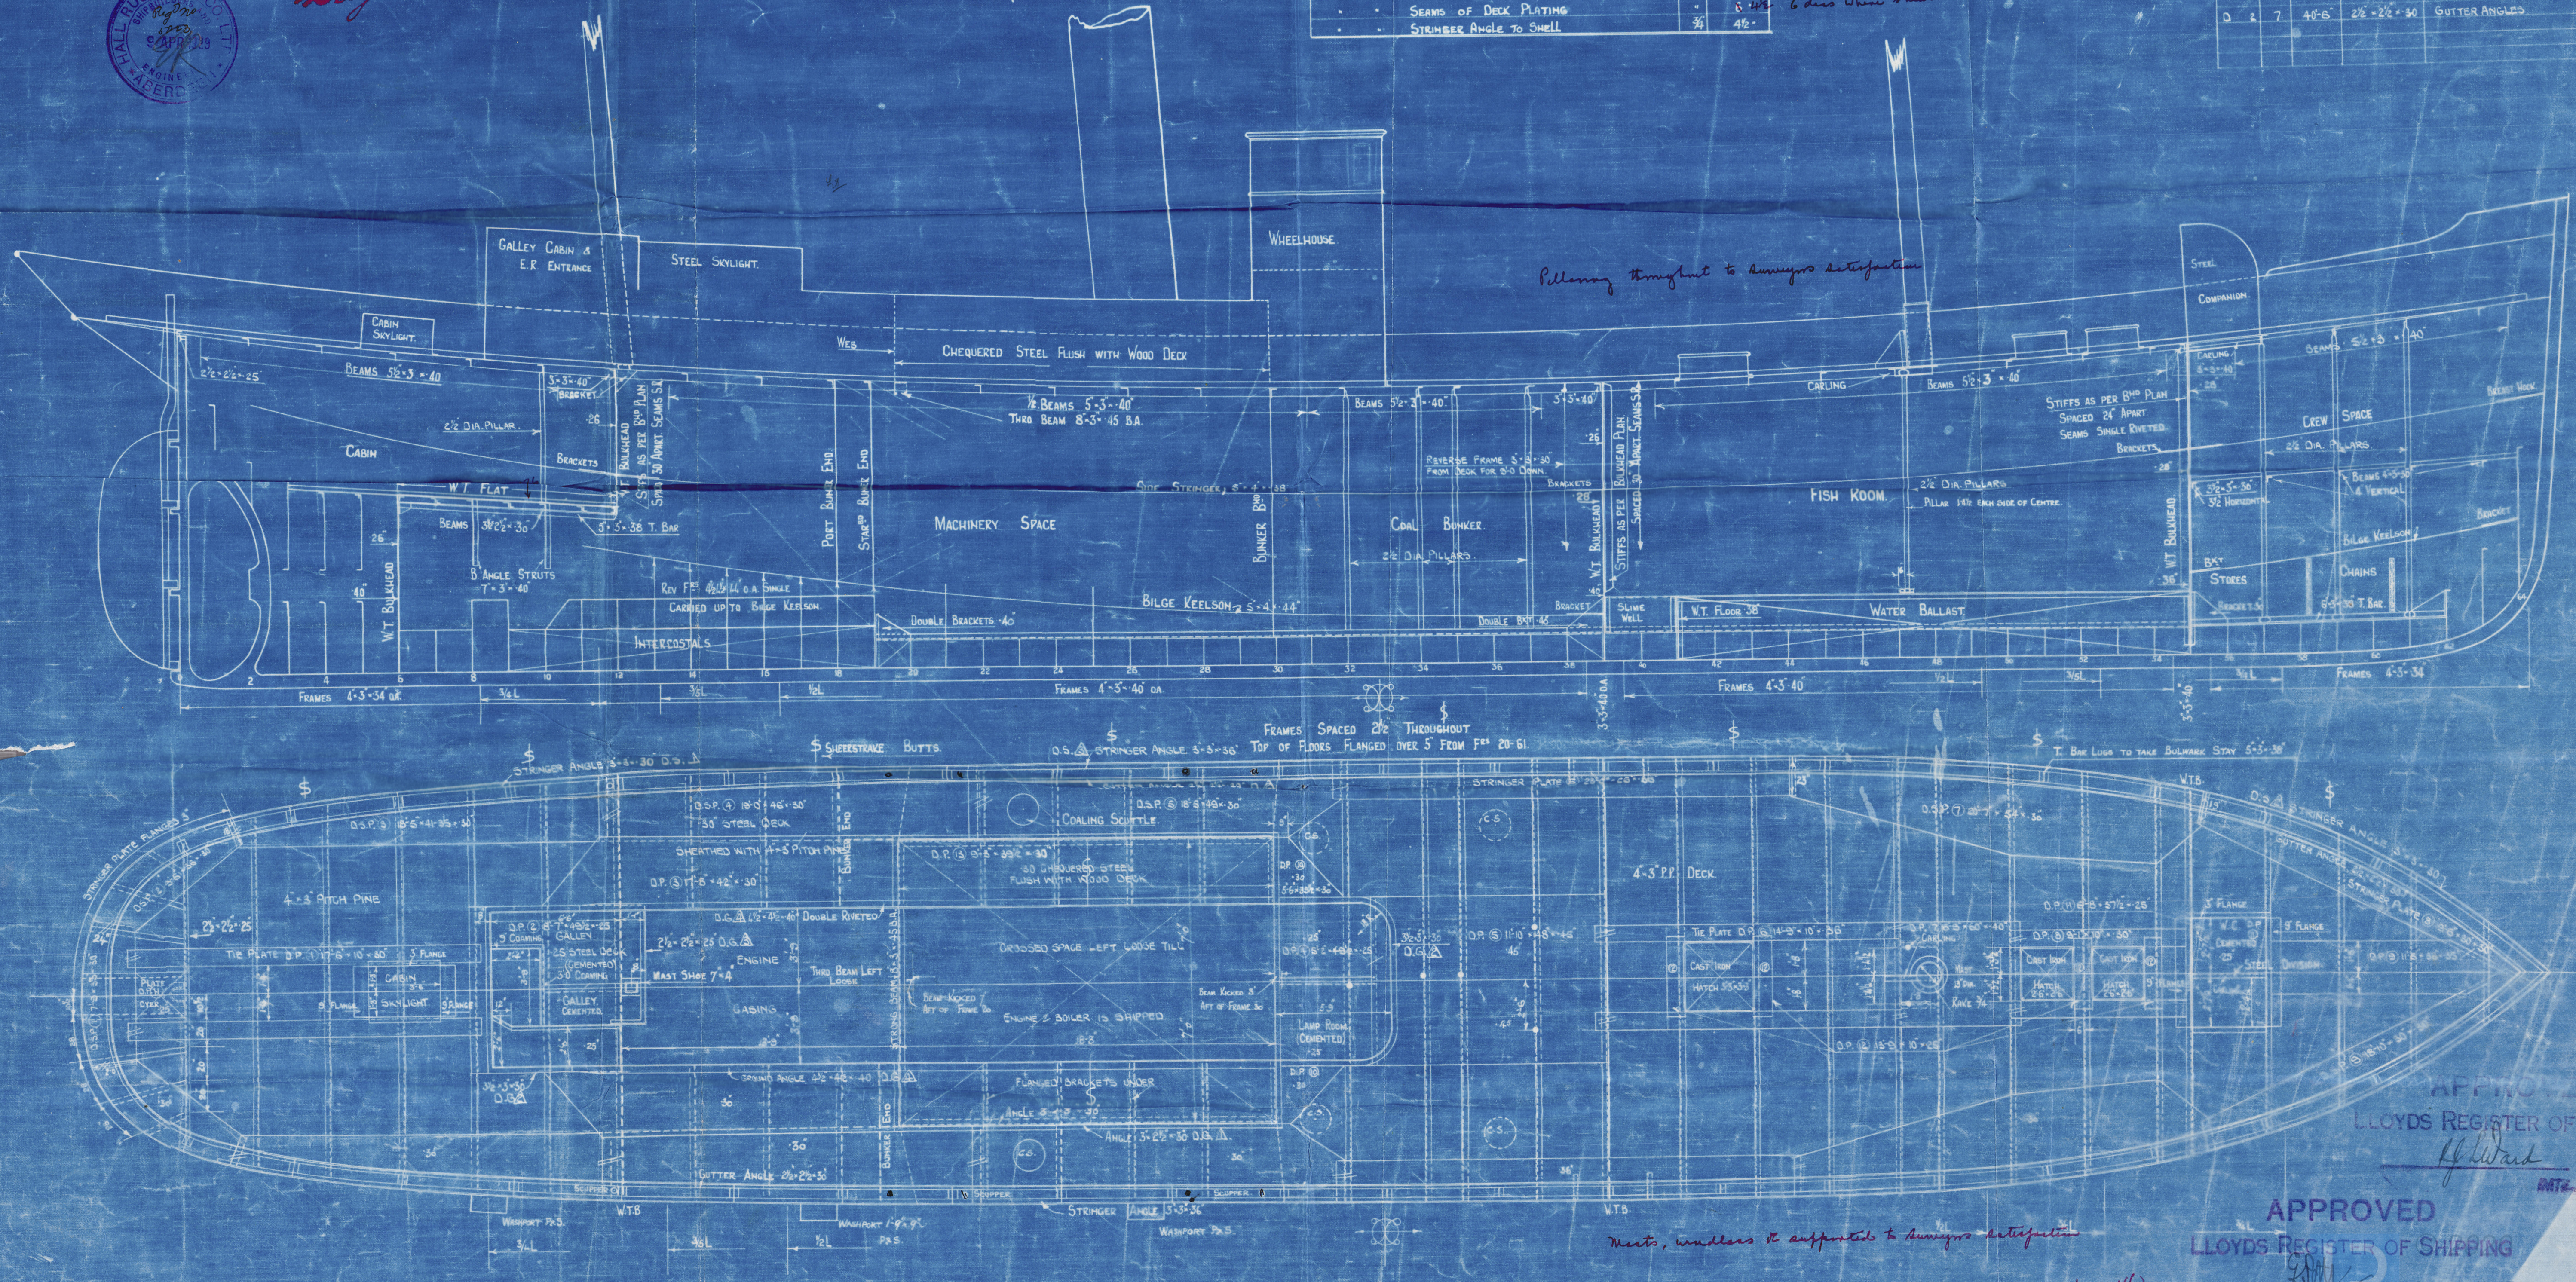

DRAWING Nº 3/696-701-2

APPROVED
LLOYDS REGISTER OF SHIPPING

see section 10 para 1(f)

003391-003400-0084

S.T. Nos. 701-702 ^{4/14/5}
Stall Russell & Co. Ltd.
Profile & Deck

No. 701 = "STRATHALBYN"
abu. Report. 15783. *

No. 702. "STRATHALFORD".
abu. Report. 15784.

No. 714. "STRATHBLAIR"
abu. Report. 16288.

No. 715. "STRATHBORVE"
abu. Report. 16289.

003391-003400-0084



© 2020

Lloyd's Register
Foundation