

N<sup>o</sup> 696-7

701-2 2 1/4" x 5" Lloyd's

# MIDSHIP SECTION.

SCALE:- 1/2 IN. = 1 FOOT

## DIMENSIONS.

LENGTH BETWEEN PERPENDICULARS  
FAIR SIDE OF STEM TO AFT SIDE OF STERNPOST  
MEASURED ON MAIN DECK  
BREADTH MOULDED

117'-0"

22'-0"

DEPTH MOULDED

13'-0"

1<sup>ST</sup> LONGITUDINAL N<sup>o</sup> L x D

1521

2<sup>ND</sup> LONGITUDINAL N<sup>o</sup> L x (B + D)

4095


L/D = 9 B/D = 1.69.

## EQUIPMENT

TO BE SUPPLIED BY OWNERS.

2 BOWER ANCHORS 5 CENTS. EX. STOCK  
1 KEDGE ANCHOR 2 1/2 CENTS. EX. STOCK  
90 FATHOMS 1 DIA. STUD CHAIN CABLE  
60 " HAWSER 5 1/2 MANILLA.  
60 " WARP 4 1/2 "

CLASS 100 A1 TRAWLER.

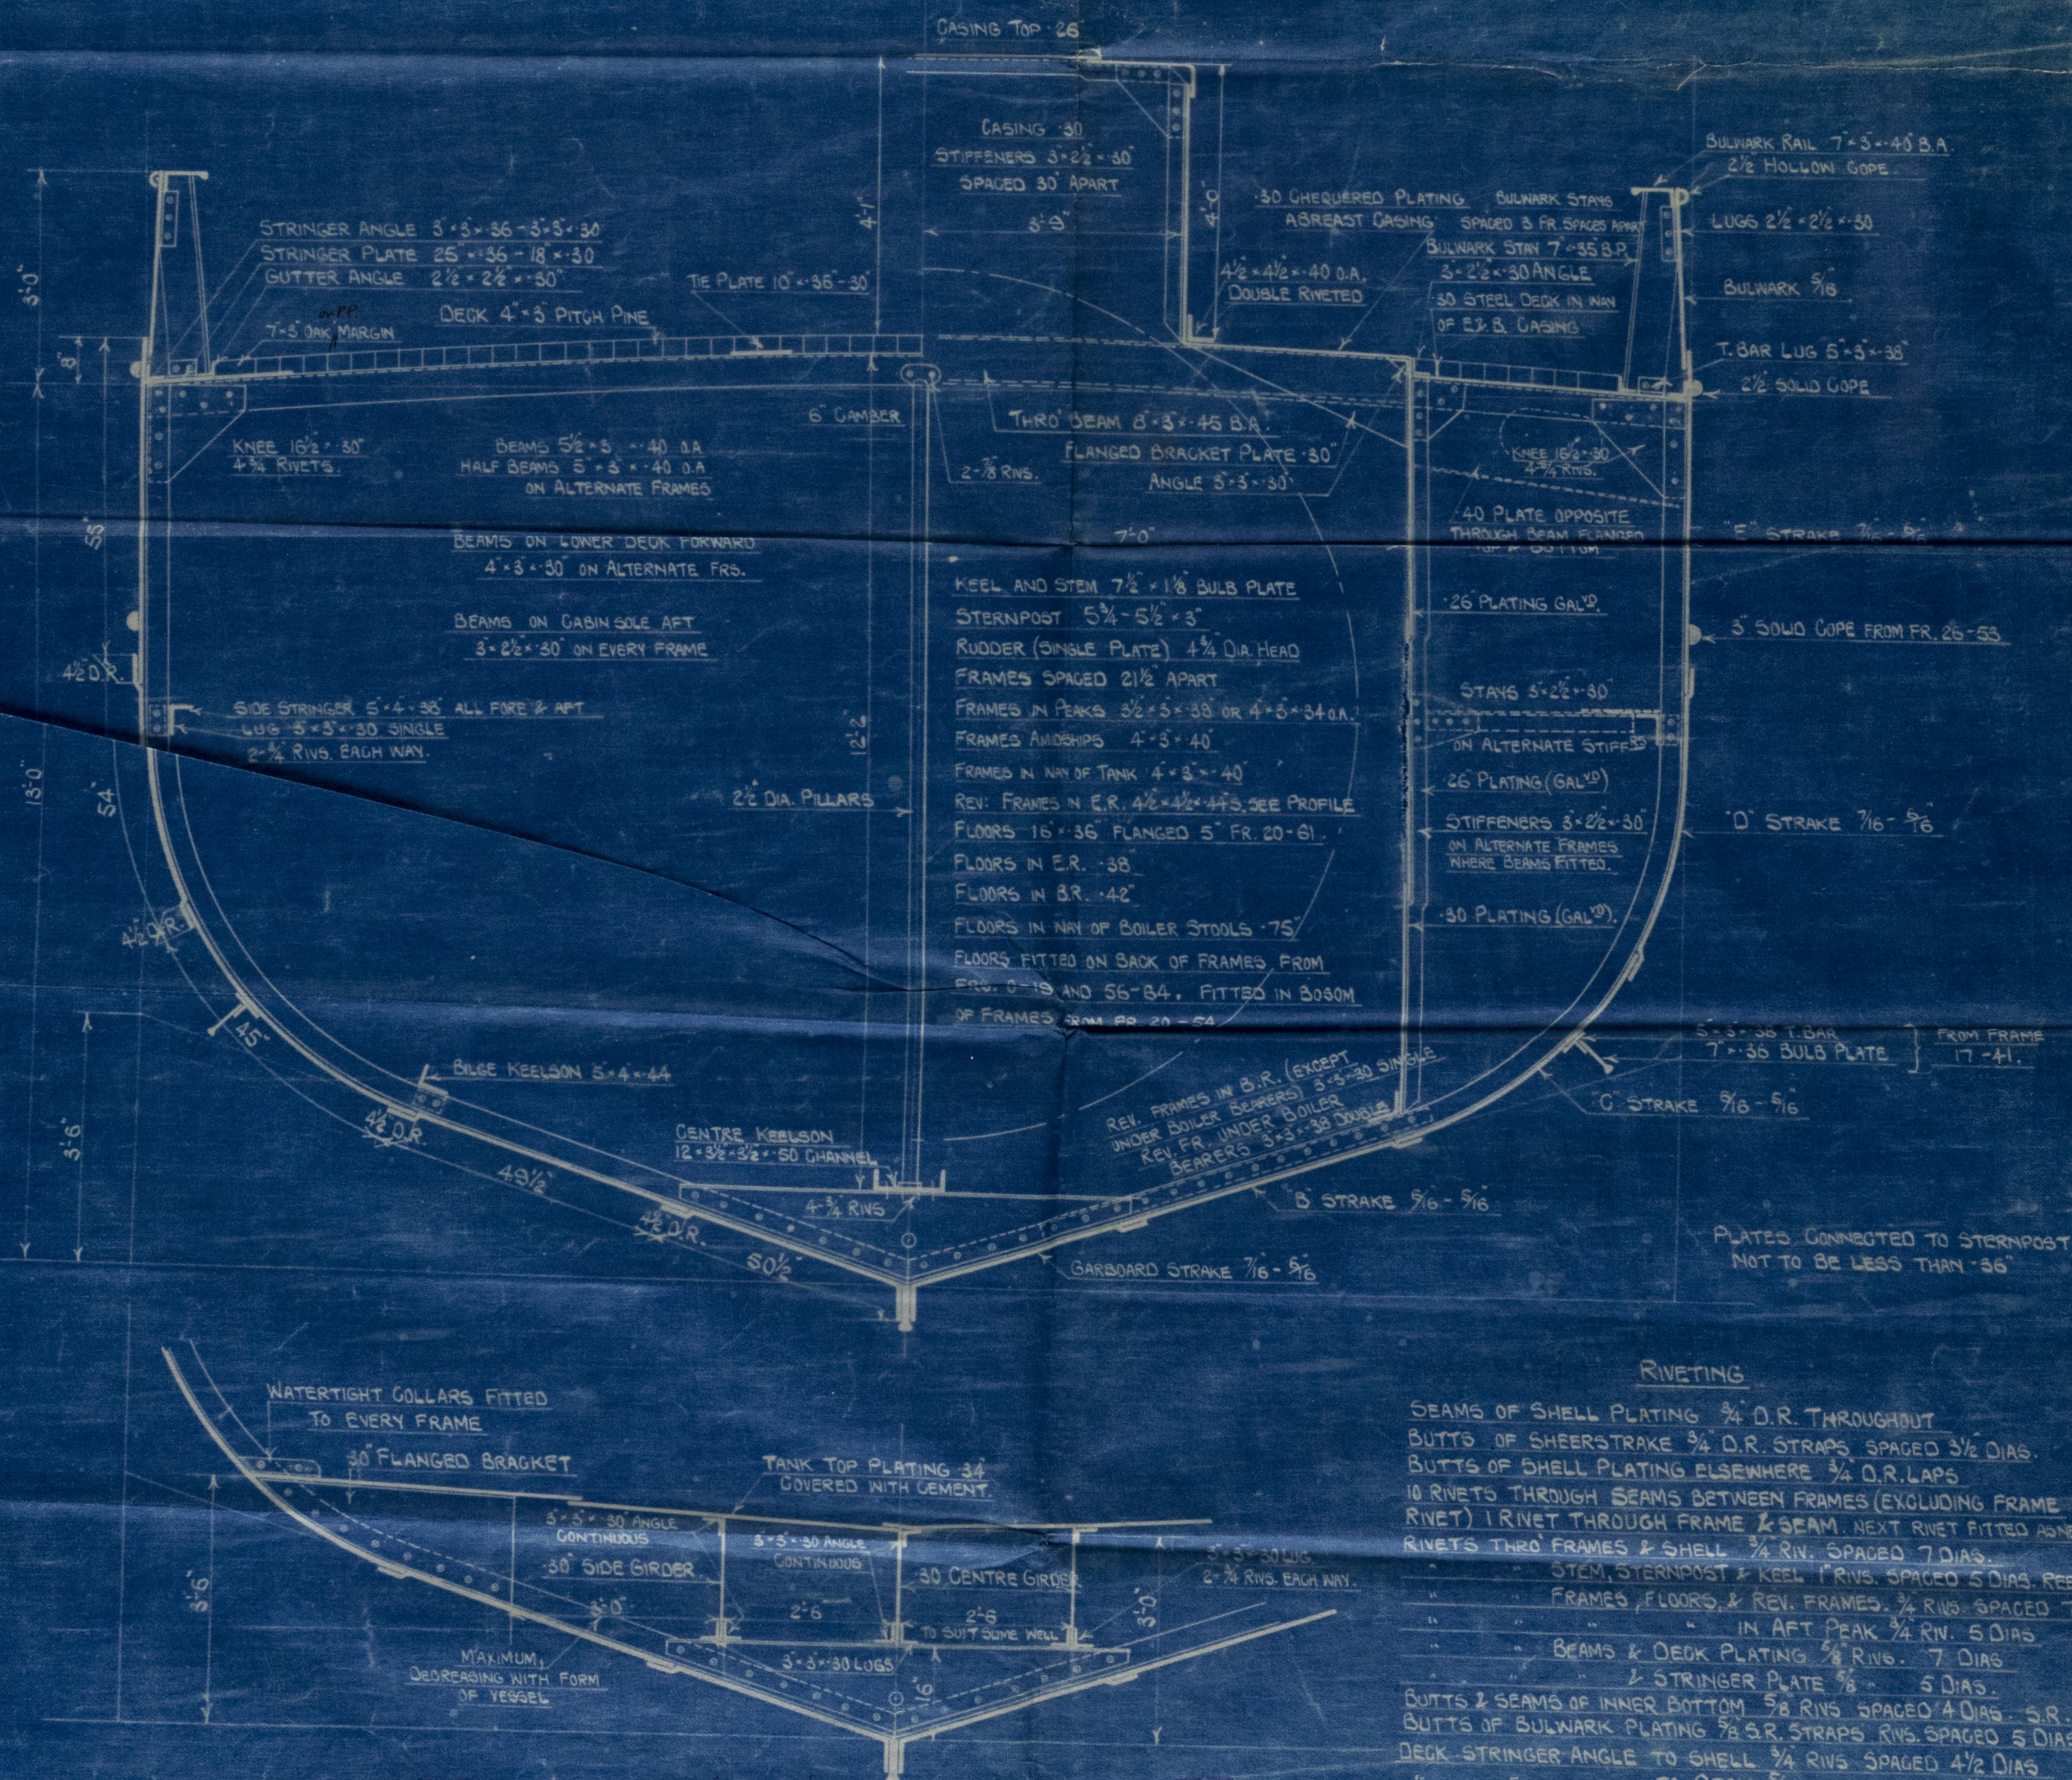

## RIVETING

SEAMS OF SHELL PLATING 3/4" O.R. THROUGHOUT  
BUTTS OF SHEERSTAKE 3/4" O.R. STRAPS SPACED 3 1/2" DIAS.  
BUTTS OF SHELL PLATING ELSEWHERE 3/4" O.R. LAPS  
10 RIVETS THROUGH SEAMS BETWEEN FRAMES (EXCLUDING FRAME RIVET) 1 RIVET THROUGH FRAME & SEAM. NEXT RIVET FITTED AS NEAR JOGGLE AS PRACTICABLE.  
RIVETS THRO FRAMES & SHELL 3/4" RIV. SPACED 7 DIAS.  
STEM, STERNPOST & KEEL 1" RIV. SPACED 5 DIAS. REEL  
FRAMES, FLOORS, & REV. FRAMES. 3/4" RIV. SPACED 7 DIAS.  
IN AFT PEAK 3/4" RIV. 5 DIAS  
BEAMS & DECK PLATING 5/8" RIV. 7 DIAS  
2 STRINGER PLATE 5/8" 5 DIAS.  
BUTTS & SEAMS OF INNER BOTTOM 5/8" RIV. SPACED 4 DIAS. S.R.  
BUTTS OF BULWARK PLATING 5/8" S.R. STRAPS RIV. SPACED 5 DIAS  
DECK STRINGER ANGLE TO SHELL 3/4" RIV. SPACED 4 1/2" DIAS  
TO DECK 5/8" 4 1/2"  
STRINGER PLATE BUTTS 5/8" O.R. SPACED 3 1/2" DIAS.  
DECK TIE PLATES BUTTS 5/8" O.R. 4 DIAS.  
BUTTS OF DECK PLATING 5/8" S.R. 4  
SEAMS " " 5/8" S.R. 4 1/2" 6 lines rivet stitched  
SHELL MOULDINGS 3/4" RIV. 4 RIV. IN EACH FR. SPACE, GSK. HEAD & POINT.

APPROVED

APPROVED

DRAWING N<sup>o</sup> 696-7 701-2

LOYDS REGISTER OF SHIPPING

LOYDS REGISTER OF SHIPPING

Ward

DATE 14.30

DATE 15.4.29

003391-003400-0085



S.T. Nos. 701-702. 4/4/5.

Hall Russell & Co. Ltd.

Midship Section.

No. 701 = STRATHALBYN \*  
abu. Report. 15783.

No. 702 = STRATHALFORD.  
abu. Report. 15784.

No. 714. "STRATHBLAIR"  
abu. Report. 16288.

No. 715. STRATHBORNE  
abu. Report. 16289.

© 2020  
LLOYD'S REGISTER  
FOUNDATION

003391-003400-0085