
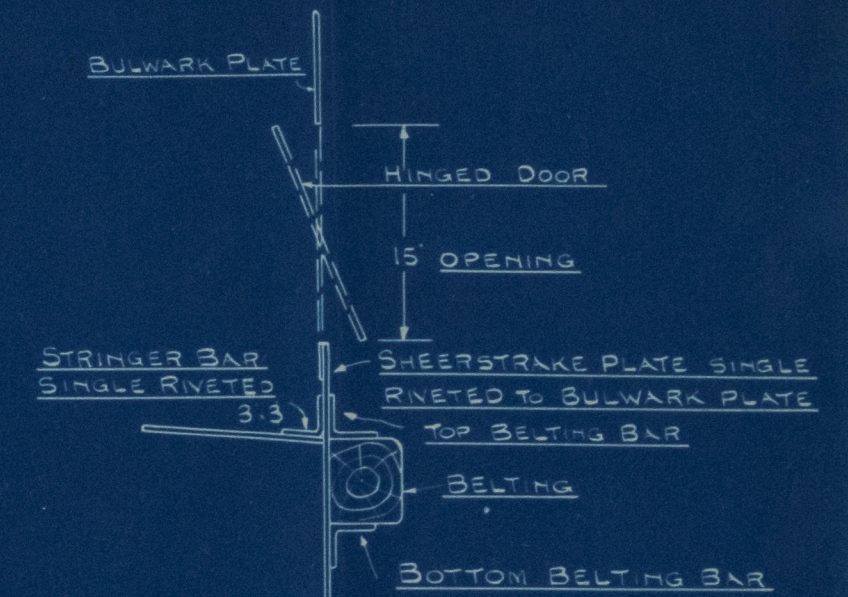


# S.S. "INVERTEST"



SKETCH SHOWING POSITION AND SIZE OF PROPOSED FREEING PORTS IN COMPARISON  
WITH EXISTING PORTS

SCALE 1/4" = ONE FOOT

5<sup>TH</sup> MAY 1931

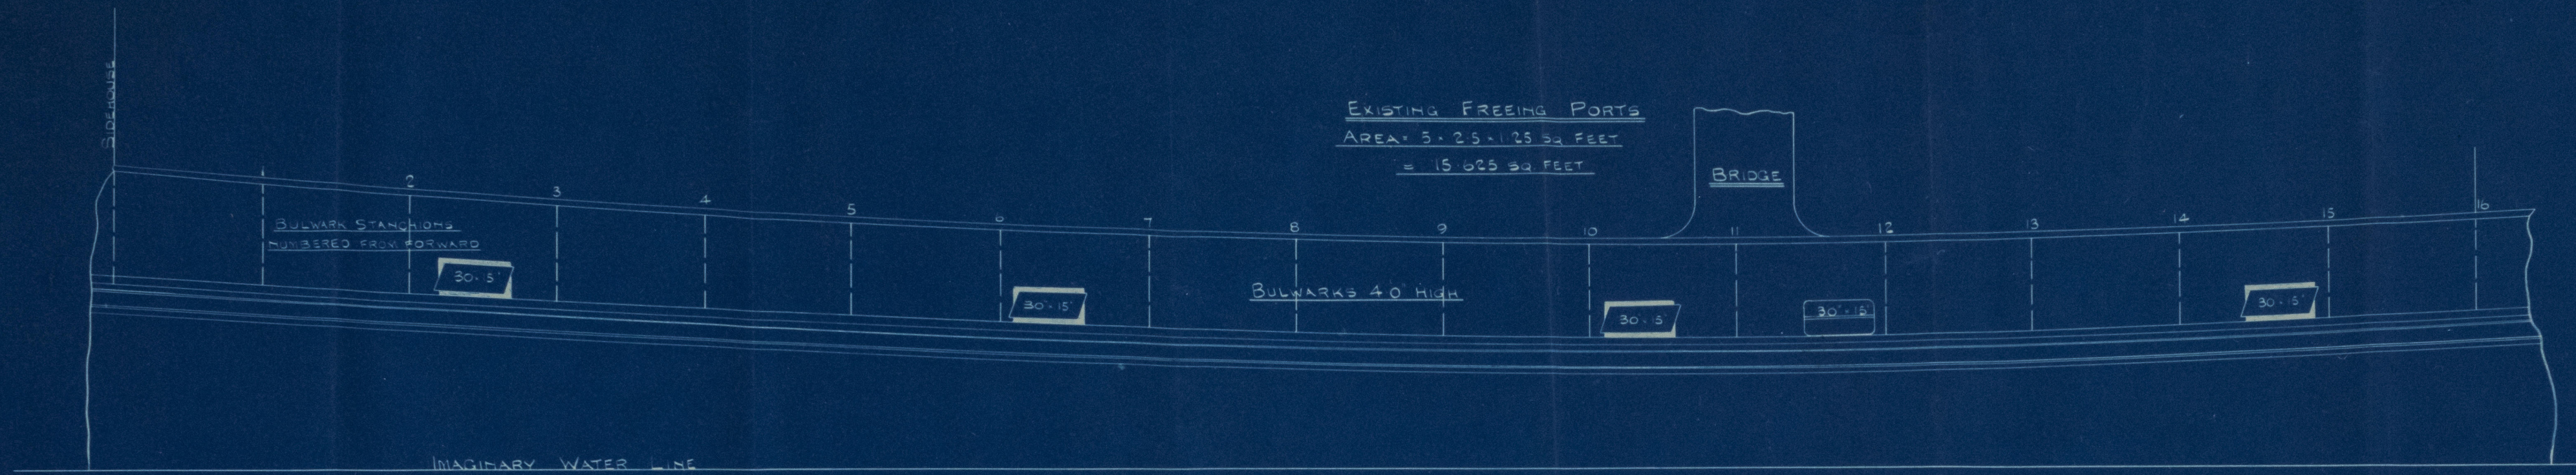

SCALE 1" = 1 FOOT

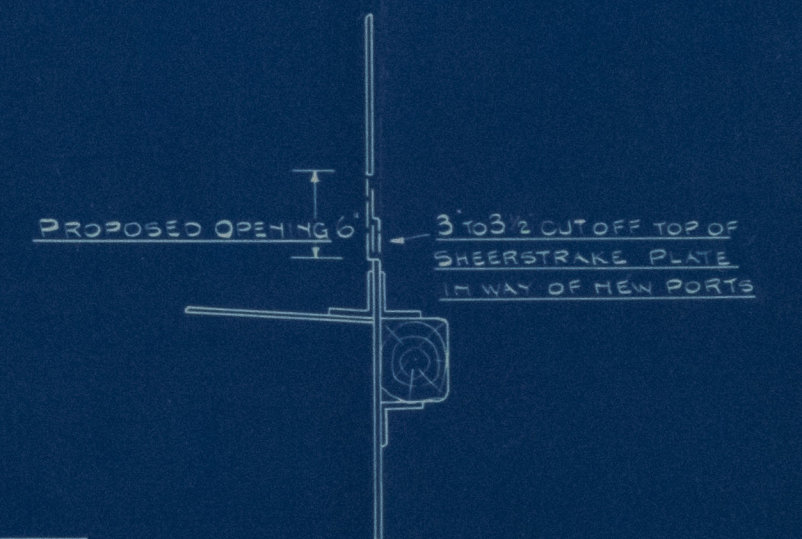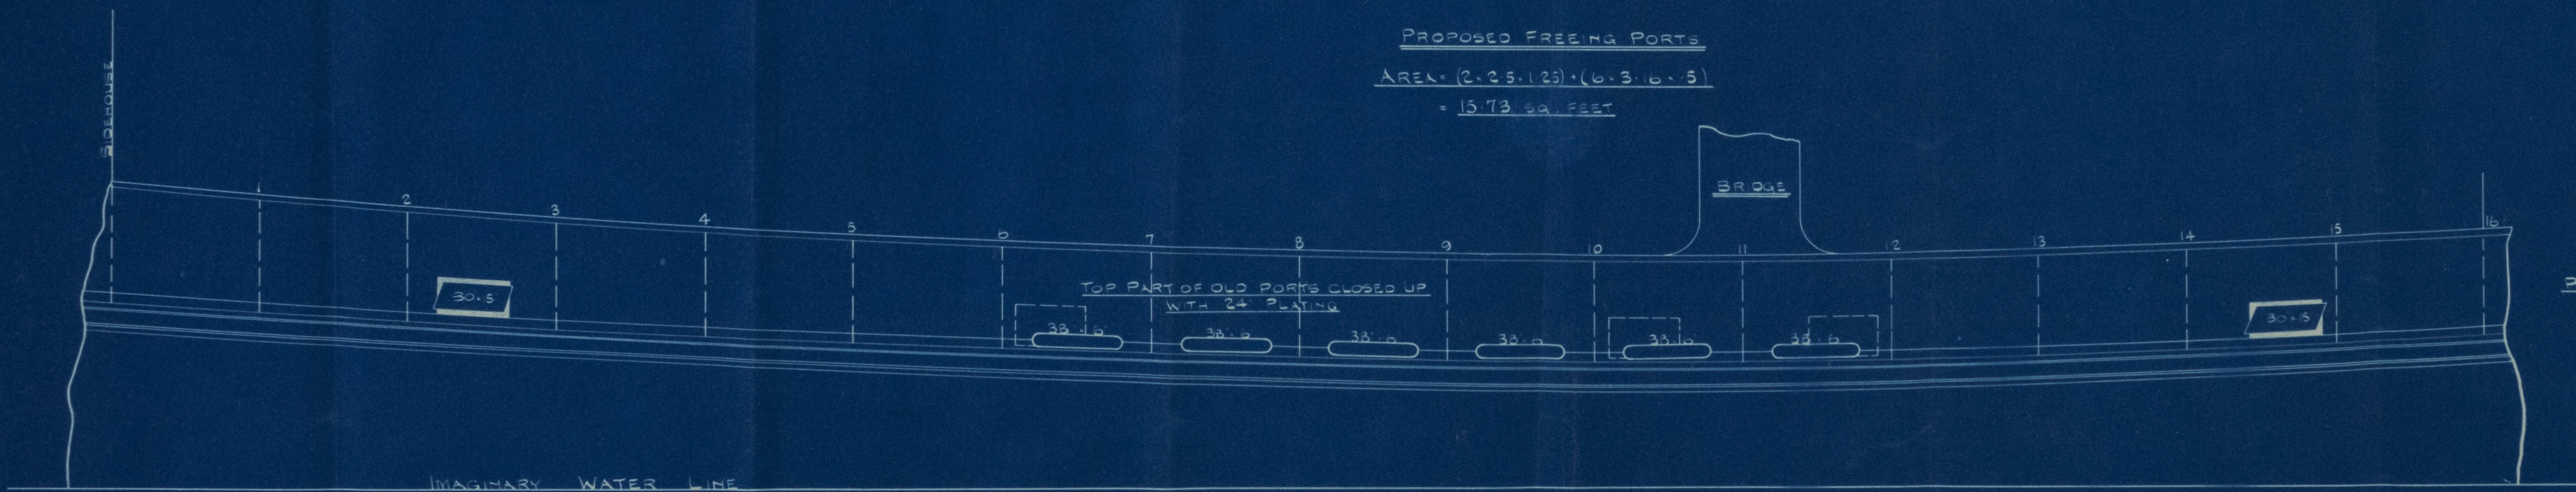

SCALE 1" = 1 FOOT



003401-003408-0037




Messrs Scott & Sons

'Invertest'

alterations

Plan of Freeing Ports

GLASGOW REPORT No. 51507

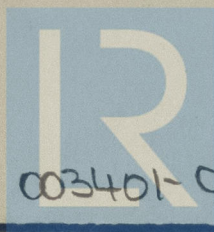

© 2020

003401-003408-0057

Lloyd's Register  
Foundation