


Lloyd's Register of Shipping.

SURVEYS FOR FREEBOARD. MOD. 18812. (CONDITIONS OF ASSIGNMENT.)

Ship's Name "GLESSULA" Port of Survey Middlesbrough.
 Official Number _____ Surveyor's Signature S.P. Scott.
 Nationality and Port of Registry Netherlands. Willmstad. Date of Survey Whitby-Building. 1949.

Disposition and dimensions of superstructures, trunks, deckhouses and machinery casings to be inserted in the diagrams and tabular statement :-

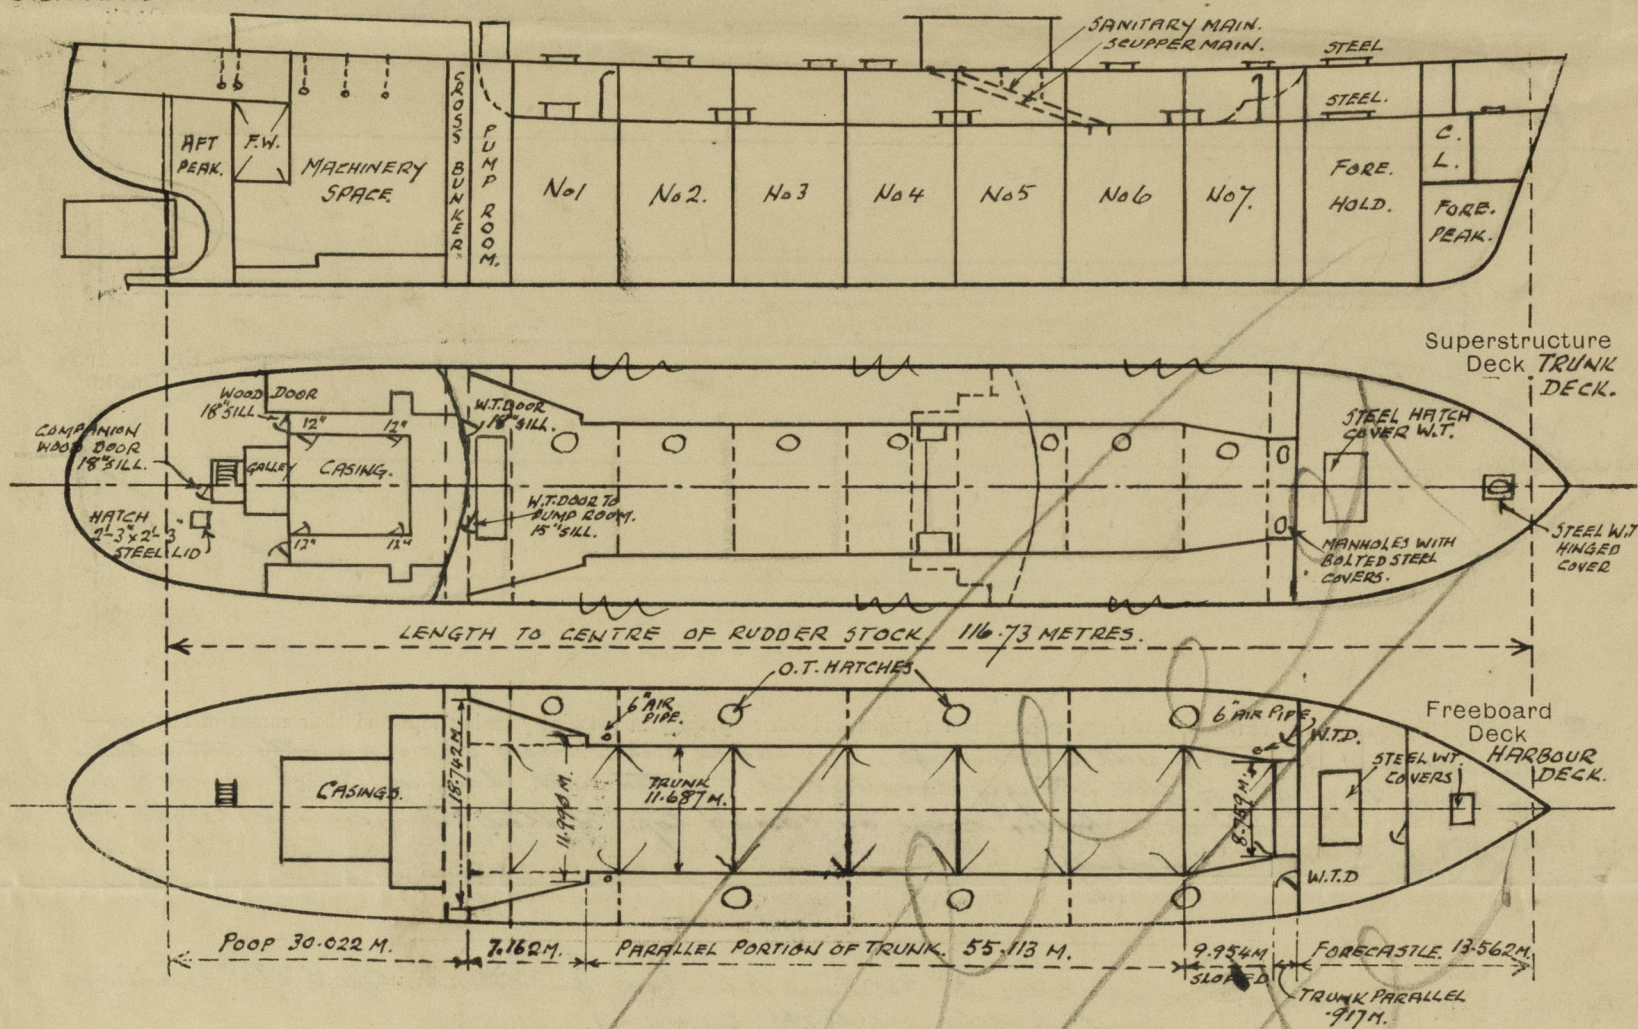


Particulars of Superstructures, Trunks, Casings, Deckhouses.

	Coaming	Plating	Stiffeners	Spacing	End Attachments of Stiffeners	Size of Openings	Height of Sills	Height of Casings
Poop Bulkhead <i>in SLOPING TRUNK</i>	✓	.44	<i>9x3 1/2 x 38 B.A. fore & aft.</i>	<i>2'-6"</i>	<i>Brackets.</i>	<i>none.</i>	✓	<i>7'-6"</i>
Raised Quarter Deck Bulkhead ...	✓							
Bridge, After Bulkhead ...	✓							
Bridge, Forward Bulkhead ...	✓							
Forecastle Bulkhead ...	✓	.34	<i>4 1/2 x 36 flat. welded.</i>	<i>2'-6"</i>	<i>Brackets top and bottom.</i>	<i>4'-10" x 2'-6"</i>	<i>21"</i>	<i>7'-6"</i>
Trunk, Aft ...	✓	.60	<i>7 x 3 1/2 x 40 O.A. welded T.T.P. fore and aft.</i>	<i>2'-6"</i>	<i>Brackets.</i>	<i>none.</i>	✓	<i>7'-6"</i>
Trunk, Forward ...	✓							
Exposed Machinery Casings on Freeboard or Raised Quarter Decks ...	✓							
Exposed Machinery Casings on Superstructure Decks ...	✓							
Machinery Casings within Superstructures not fitted with Class I Closing Appliances ...	✓							
Deckhouses on Flush Deck Ships ...	✓							

Particulars of Closing Appliances (state if capable of being manipulated from both sides).

Poop Bulkhead ...	<i>no openings.</i>
Raised Quarter Deck Bulkhead ...	✓
Bridge, After Bulkhead ...	✓
Bridge, Forward Bulkhead ...	✓
Forecastle Bulkhead ...	<i>Two openings with hinged steel watertight doors (opening both sides.)</i>
Exposed Machinery Casings on Freeboard or Raised Quarter Decks ...	✓
Exposed Machinery Casings on Superstructure Decks ...	✓
Machinery Casings within Superstructures not fitted with Class I Closing Appliances ...	✓
Deckhouses on Flush Deck Ships ...	✓

The following diagrams should be used to indicate the positions of cargo and coaling hatchways, gangway, cargo and coaling ports, ventilators, companionways, etc., which would affect the seaworthiness of the ship :—

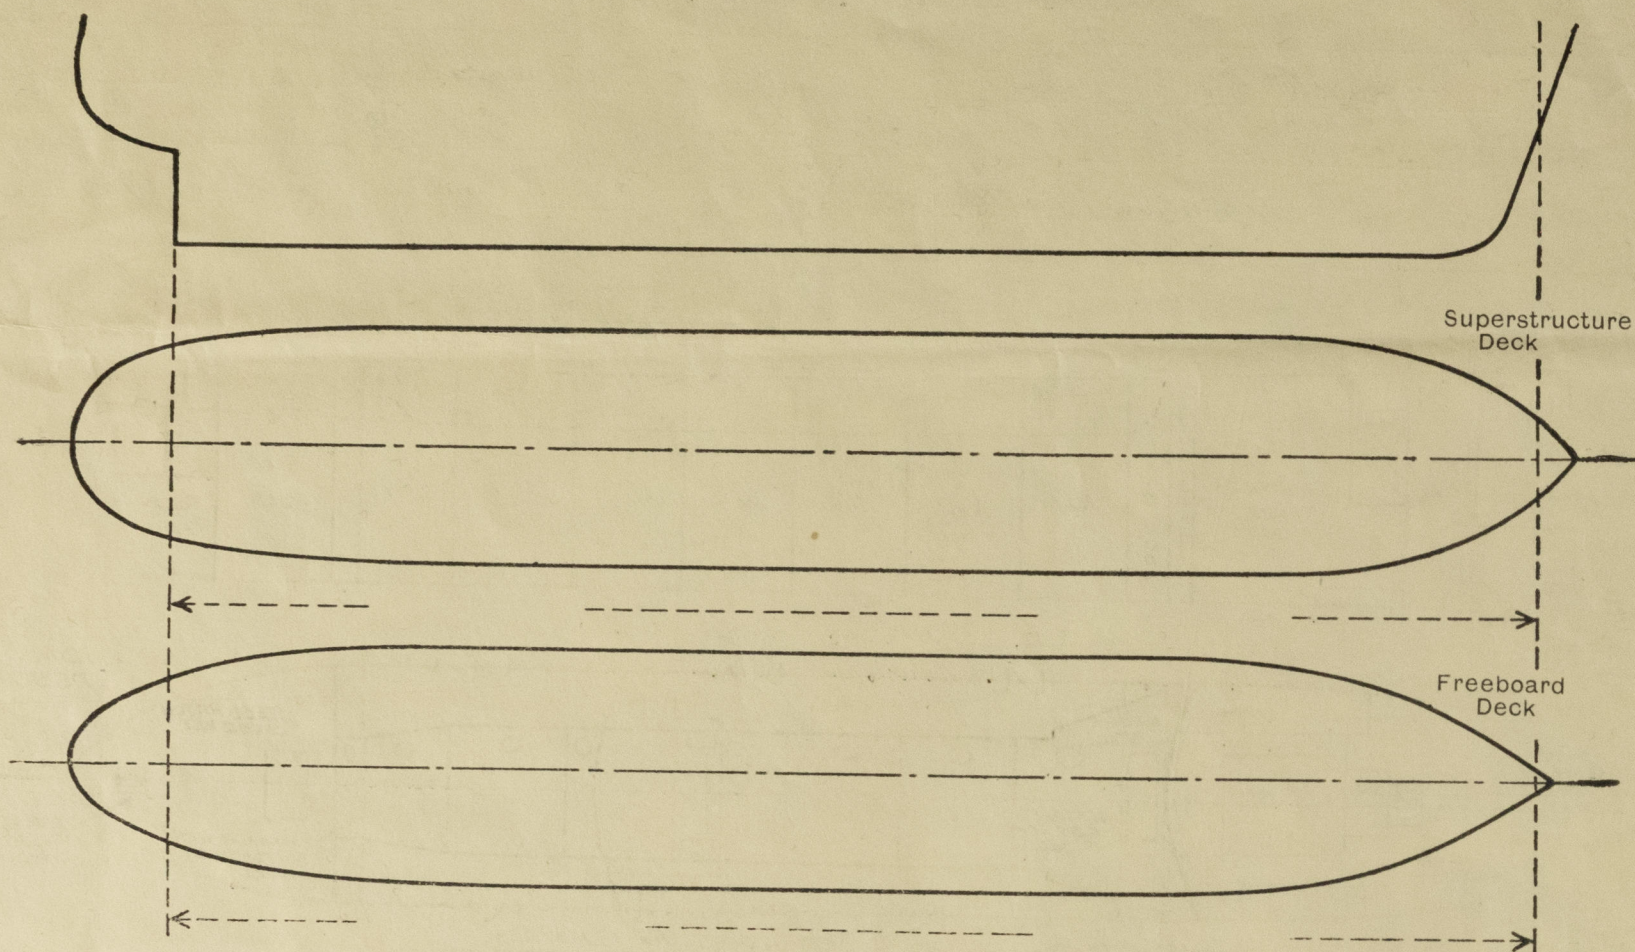

Particulars of Flush Bunker Scuttles:—

Particulars of Ventilators in exposed positions on freeboard and superstructure decks:— *no ventilators on exposed freeboard deck.*

100

Glossula. 16 NOV 1911


none.

Particulars of Scuppers and Sanitary Discharge Pipes:— No Scuppers or Sanitary discharges from spaces below the freeboard deck. No scuppers or sanitary discharges from enclosed poop. Sanitary discharges from after accommodation on poop discharge overboard above the freeboard deck with brass storm valves at shell. Scuppers from poop and boat-decks discharge overboard through open benches above freeboard deck. Sanitary discharges and scupper discharges from bridges discharge (6" oil) and (4" scupper) which are fed overboard above 12" above load line with brass storm valves at shell. Forecastle drained out on to harbour deck through drain plugs in wings of fore-castle pump.

Particulars of Side Scuttles:— no side scuttles to spaces below freeboard deck. ✓
 On some, side scuttles of brass of substantial construction
 and fitted with efficient inside hinged deadlights and
 secured watertight.

Vertical distance of Sill of lowest Side Scuttle above top of keel *Approximately 26'-0"* ✓

Particulars of Guard Rails :- Fitted all fore and aft on foreboard deck, trunk deck, poop and forecabin. Approx 5'-0" apart. 3 rows. 3 1/2" high.

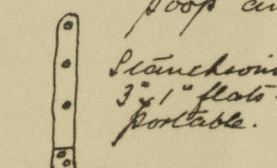

Particulars of Gangways, Lifelines, etc.:— *Trunk top, protected by stanchions and rails for 9 ft. board forms an efficient permanent gangway from poop to fore-castle which it connects.*

Particulars of Freeing Arrangements.						
	Length of Bulwark	Height of Bulwark	Size of Freeing Ports	Number each side	Area each side	Rule area each side
After Well	Open rails fitted for the whole length of the weather portions of the fore and deck except for rising plates at poop & forecabin breaks.					
Forward Well						

State position of each freeing port { After Well :— ✓
(F. and A. position and height above deck edge) { Forward Well :— ✓

State whether the freeing ports are fitted with shutters, bars, or rails, and give particulars of such :— ✓

Additional area where sheer is less than standard. ✓

PARTICULARS OF PROTECTION TO OPENINGS, ETC.

- * Are wood fore and afters steel-shod at all bearing surfaces? ✓
- Are battens and wedges efficient and in good condition? ✓
- Are tarpaulins in good condition and in accordance with rule requirements? ✓
- Are lashings provided in accordance with rule requirements? ✓

A few of the items herewith reported are not yet completed at this
but there will be finished before the handing over of certificates.
(Now completed. 10.2.50.)

This vessel is a sister ship to Messrs Smiths Dock Co. Jan. no 1184
M.V. "GASTRANA".