


Note. Shallow keyway cut in coupling & new key welded in position.

Old lower rudder post & old top arm worked in

Note. New Brass Bushed Pinke supplied & fitted to old top arm. 5 9/16 dia over brass bush

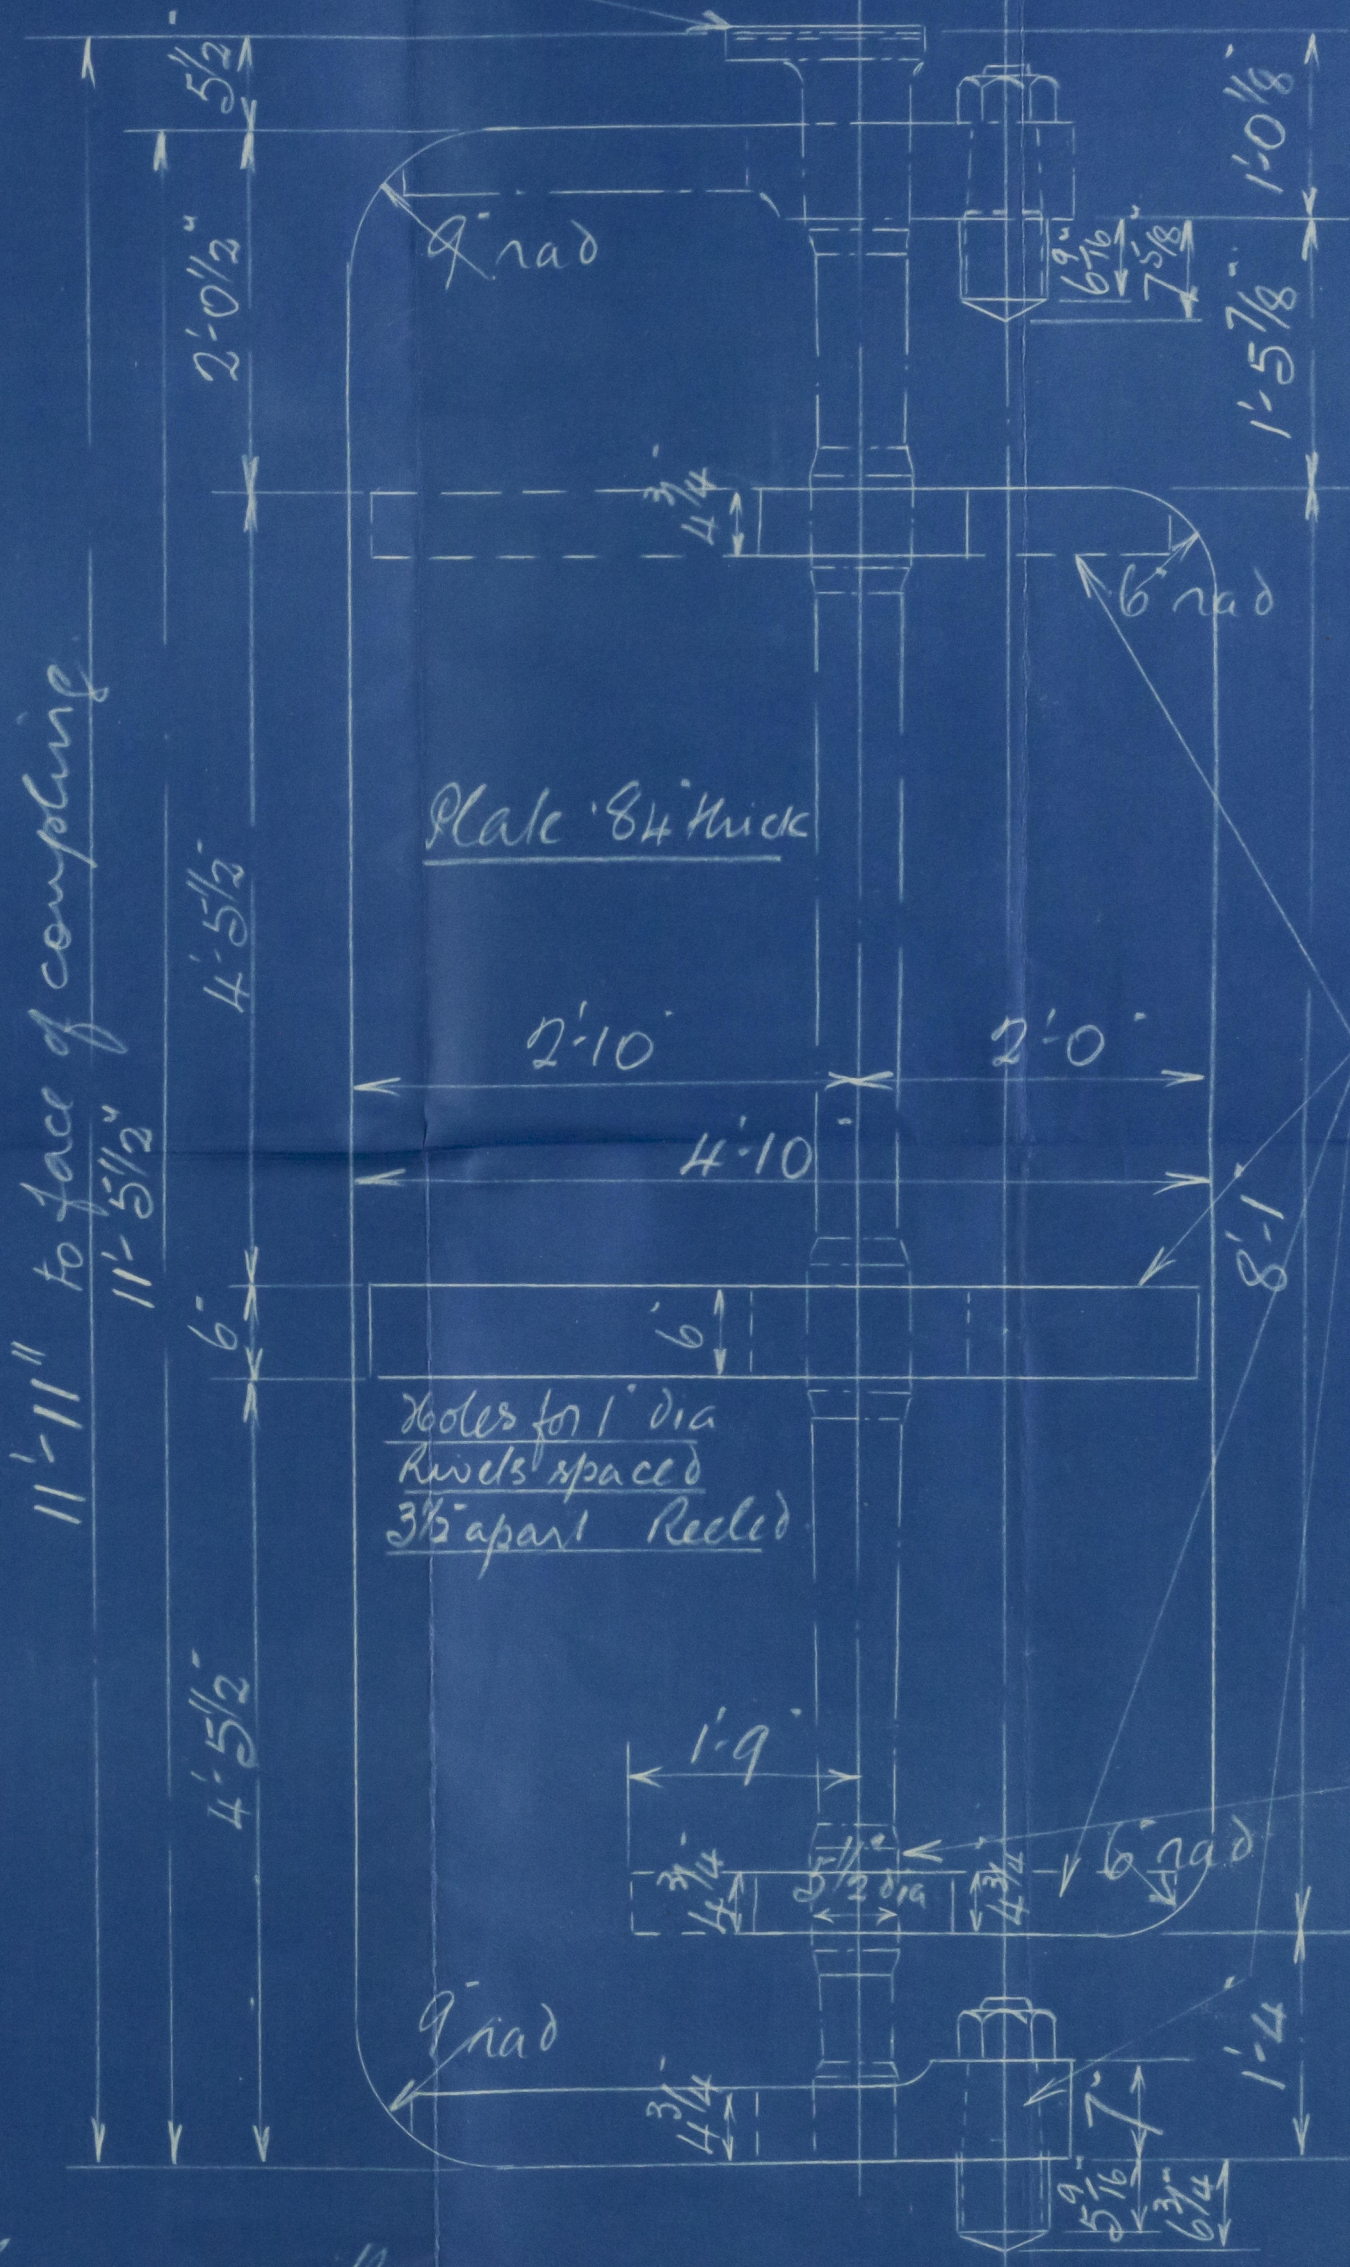


Four new arms supplied & fitted to old lower post

Note. Old post built up here by electric welding & skinned up to form swell for new arm

Note. New Brass Bushed Pinke supplied & fitted in new bottom arm. 5 9/16 dia over brass bush

5/5 Glengarriff
Conversion of Jatin lower rudder
to single plated balanced rudder
Lloyds Survey

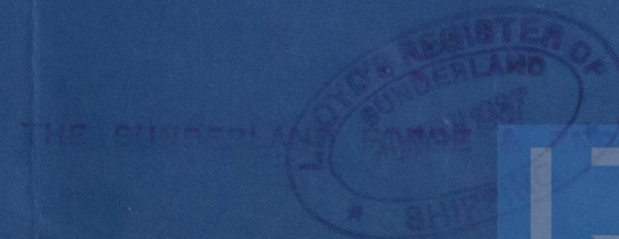

28.11.37
Lloyd's Register
Foundation

Plan showing:-

Conversion of. Tulin
lower rudder to single
plated balanced rudder.

s.s. "Glengarriff"

Belfast rpt. no:-

12046

depts.



© 2021

Lloyd's Register
Foundation

003409-003416-0120