


18/3/30

N<sup>os</sup> 663 - 4.

# STERN CASTINGS AND "CUT-UP."

SCALE 1/2 INCH = ONE FOOT.

MATERIAL OF CAST STEEL TO LLOYD'S AND BOARD OF TRADE TESTS AND REQUIREMENTS  
POSITION AND NUMBER OF TEST PIECES TO LLOYD'S AND BOARD OF TRADE SURVEYORS' SATISFACTION

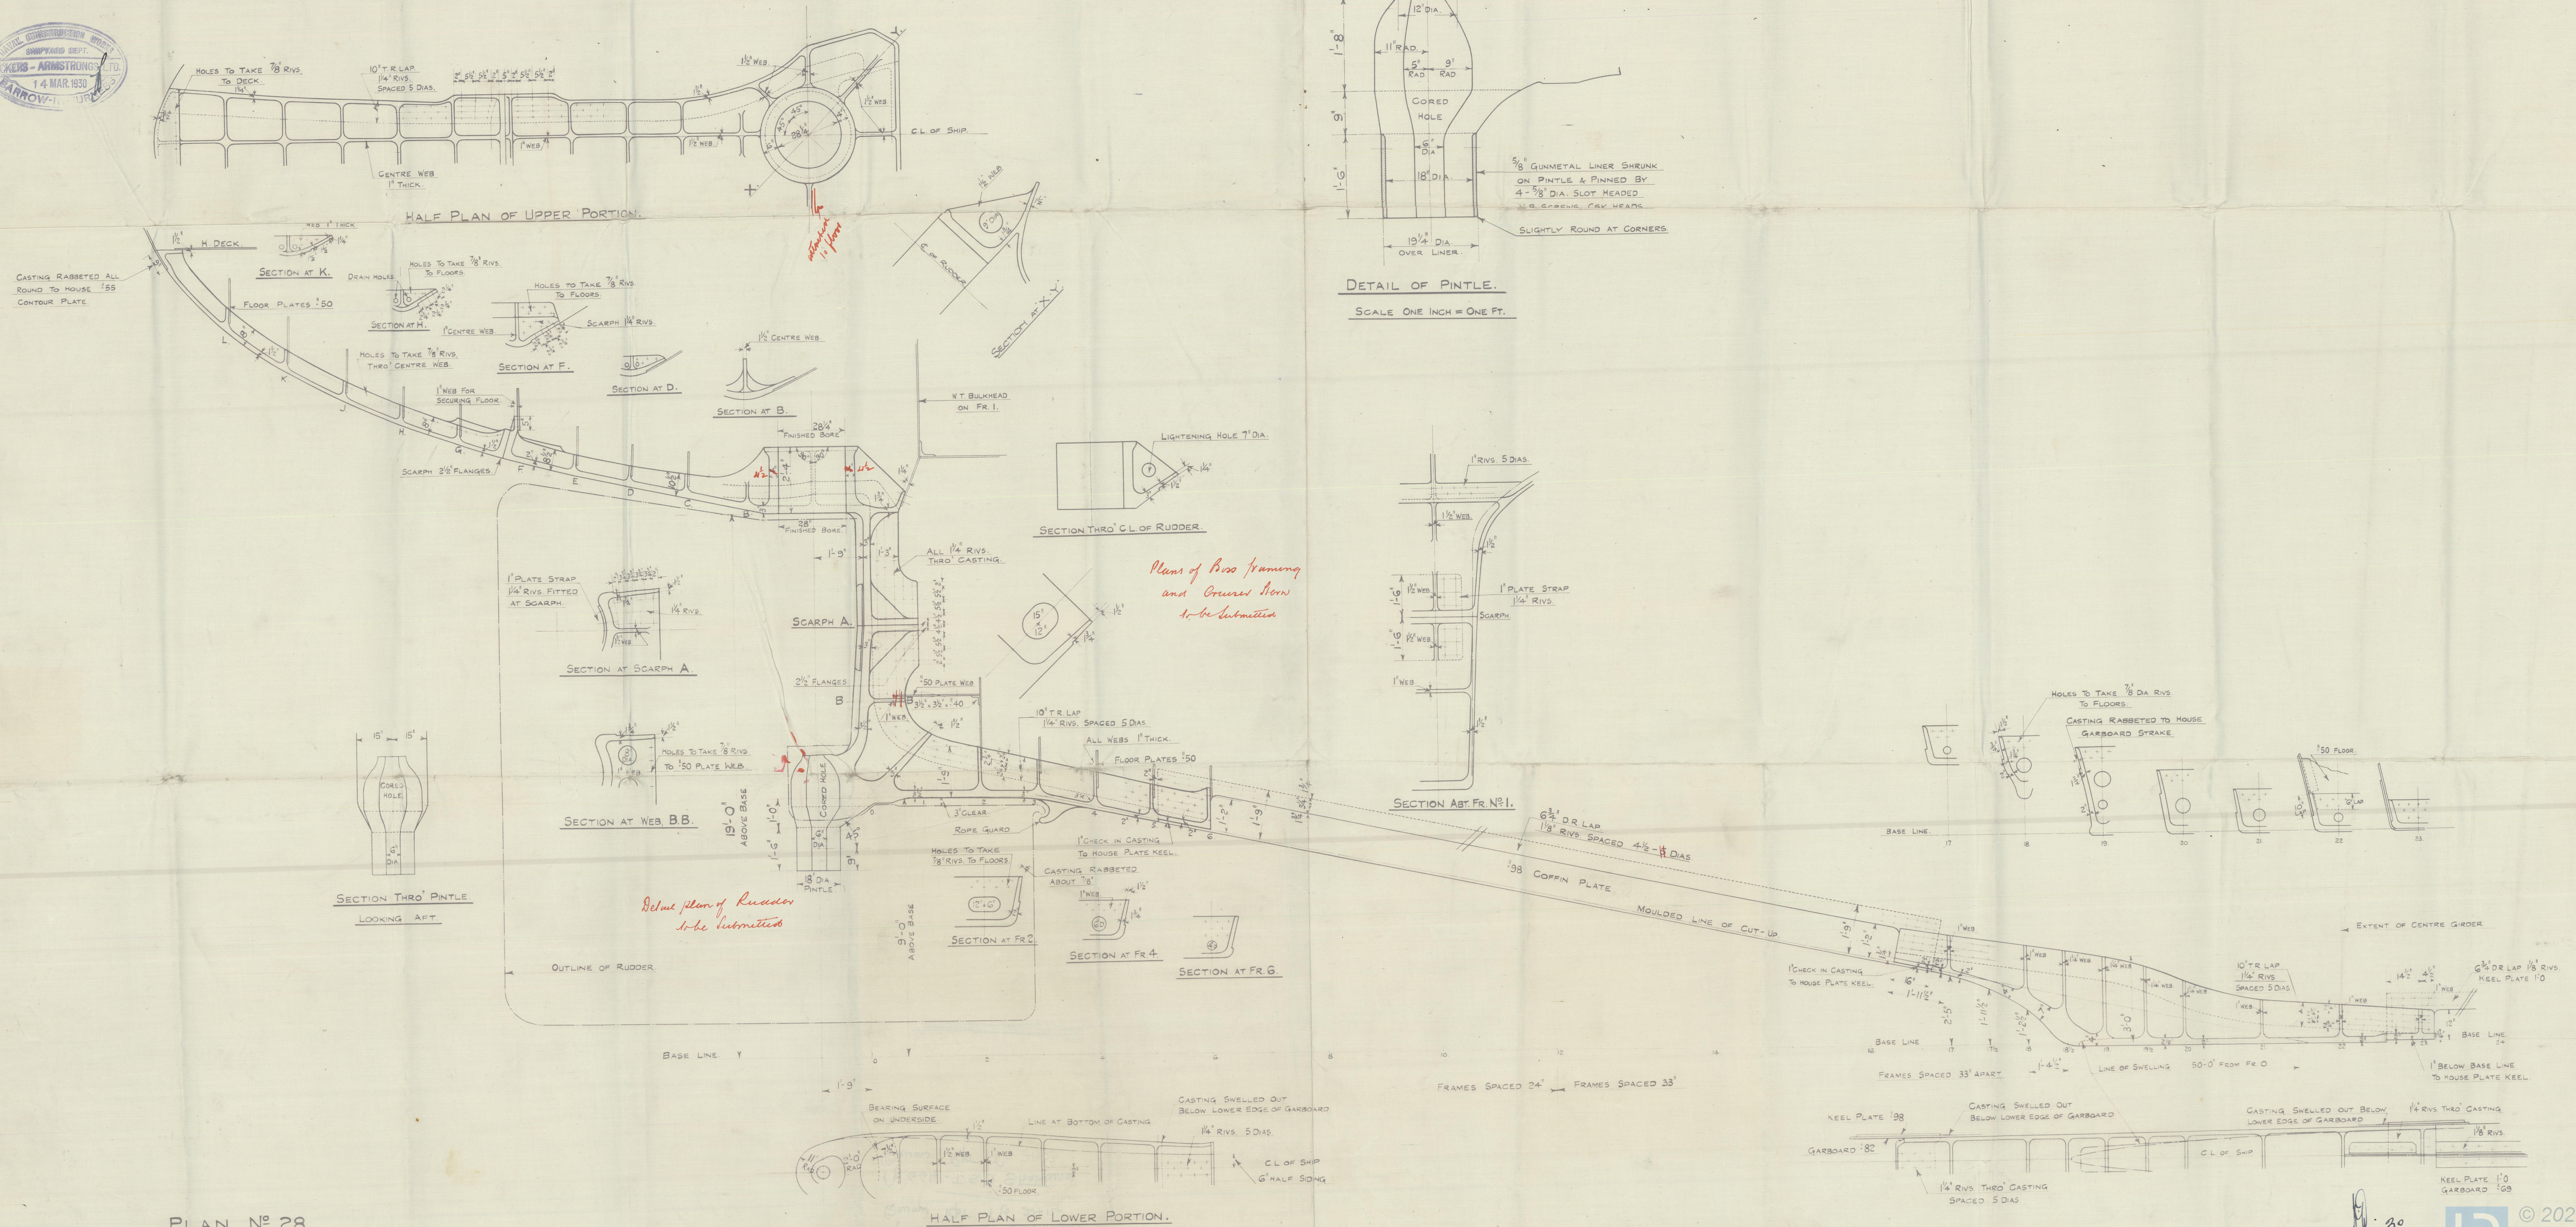

PLAN N<sup>o</sup> 28.



bickers. Armstrongs Ltd 663/664

Stem frame and "Cut-up"

No 663 - T. S. S. Strathairn  
Bawow Rpt No 2414

No 664 - T. S. S. Strathairn  
Bawow Rpt No 2433

5

~~Unclass Box 148~~



© 2020

Lloyd's Register  
Foundation

003418-003420-0009