


27 FEB 1941

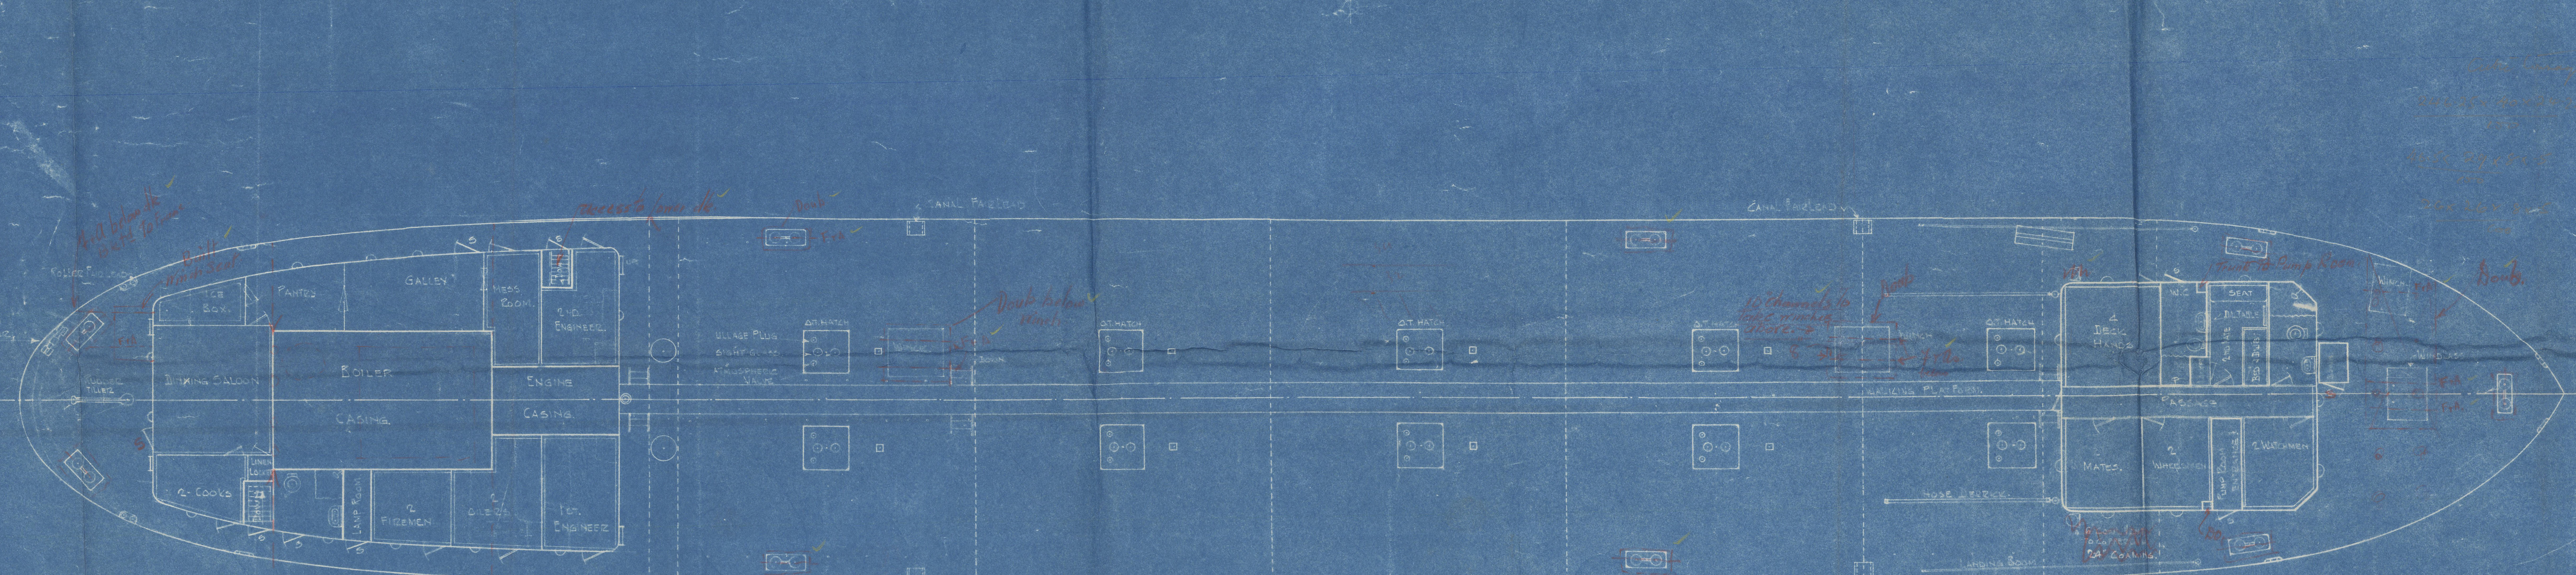

NOTE:
HINGED STEEL FLAPS TO BE FITTED AT THE DECK LEVEL AS A SECONDARY MEANS OF CLOSING THE ENGINE AND BOILER ROOM OPENING, AND HATCHES.

Initial E.R.M.
May 28/40.

GENERAL DIMENSIONS:
LENGTH OVERALL 256'-2"
LENGTH B.P. 246'-3"
BREADTH MLD. 40'-0"
DEPT. MLD. 24'-9"
CONVERSION OF A BULK FREIGHTER TO AN OIL TANKER.

MARINE INDUSTRIES LIMITED SOREL, P. Q.	
S. S. THUNDER BAY GENERAL ARRANGEMENT	
Made	Approved
Drawn	Checked
Contract No. 38	May 28/40

APPROVED BY BRITISH CORPORATION 28-5-40.
APPROVED BY BOARD OF STEAMSHIP INSPECTION-28-5-40.



General Arrgt.

½ PINEBRANCH.

27. 2. 41.



© 2020

Gen Arrgt

Lloyd's Register
Foundation

003418-005420-0053