
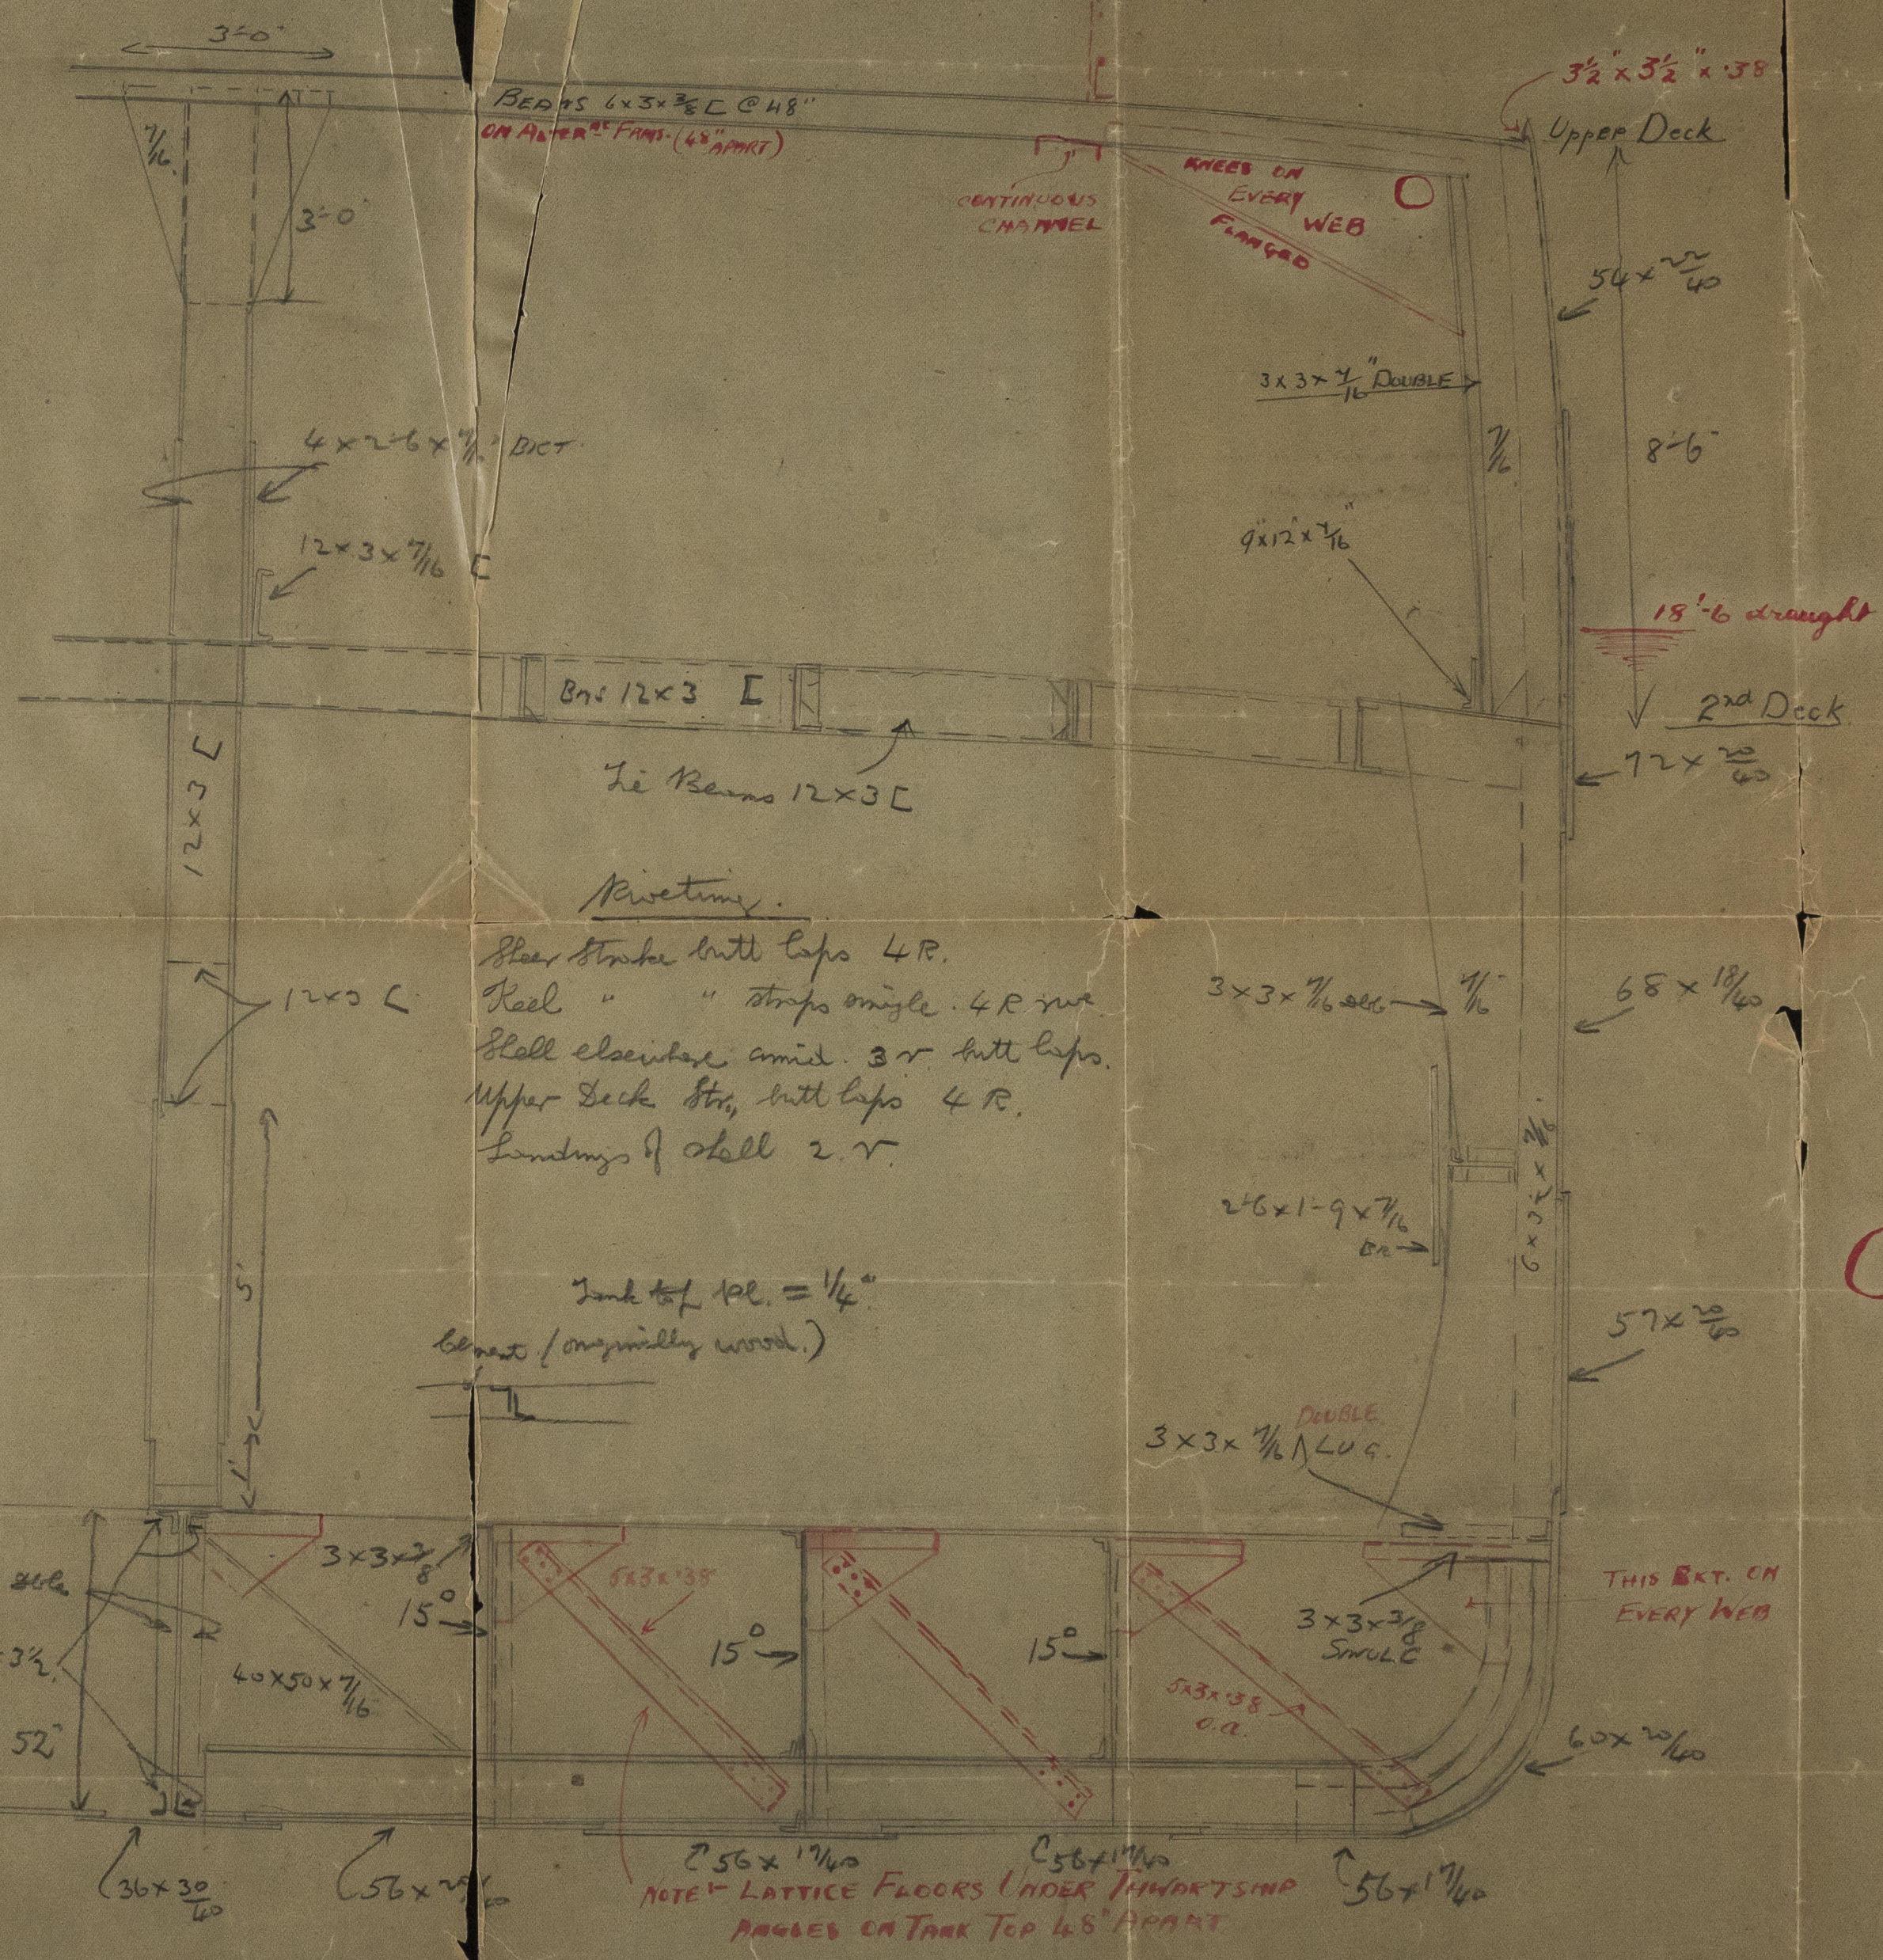


COP THUNDER BAY 302 x 40 x 25.

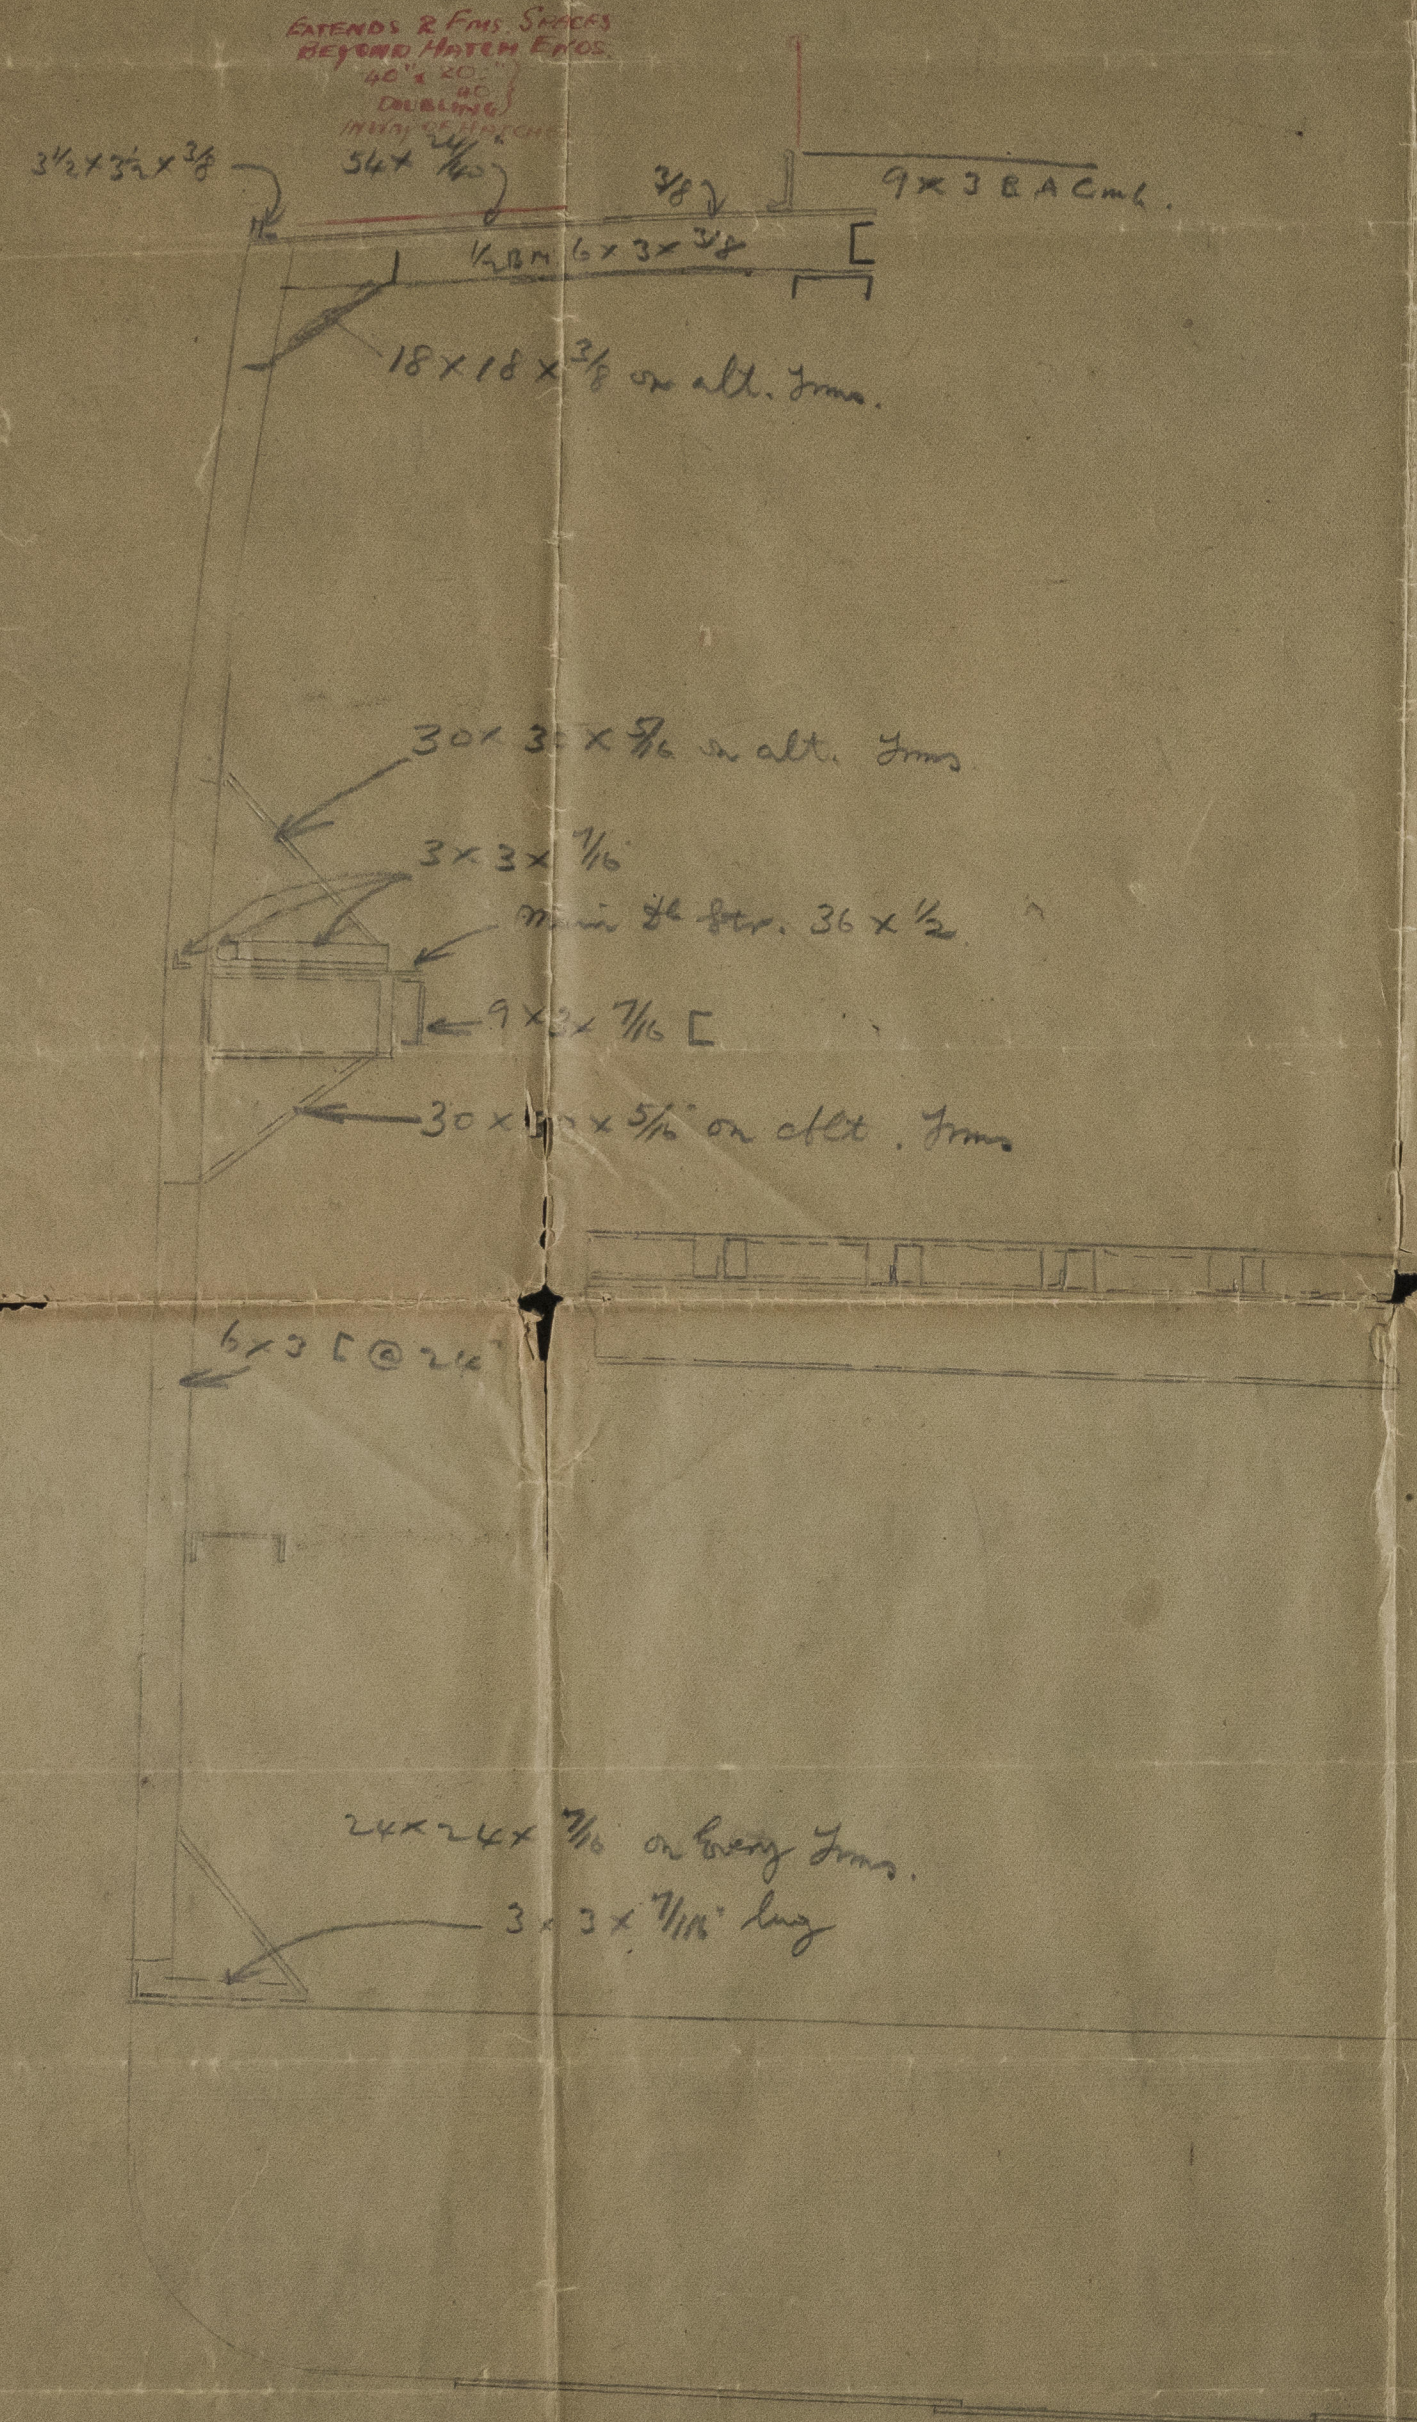

Riveting.
 Shear Strake butt laps 4 R.
 Keel " " strips single 4 R. riv.
 Shell elsewhere amid. 3 r. butt laps.
 Upper Deck Str. butt laps 4 R.
 Bindings of shell 2 r.

Tank top pl. = $\frac{1}{4}"$
 Cleat (originally wood.)


CLASS B. 5 (Barge)

S. S. "Thunder Bay"
Copy of Midship Section



© 2020

Lloyd's Register
Foundation

003418-003420-0088