

84-633

84-633

27/6/18.


# ~ MIDSHIP SECTION ~ STEEL SCREW TRAWLERS. ~ "MERSEY" CLASS ~

138' 4 BP. x 23' 9" EX x 13' 6" MLD.

N<sup>os</sup> 874 TO 933 INCLUSIVE.

COMPLETE STEEL DECK FITTED THROUGHOUT SHIP  
 ENGINE AND BOILER CASING AS PREVIOUSLY APPROVED.

PLAN No. 2349  
 FOR ENCLOSURE TO  
 MESSRS LLOYDS SURVEYORS.  
 HULL FROM  
 COCHRANE & SONS, LTD.  
 SHIPBUILDERS, SELBY.  
 DATE 14/6/18

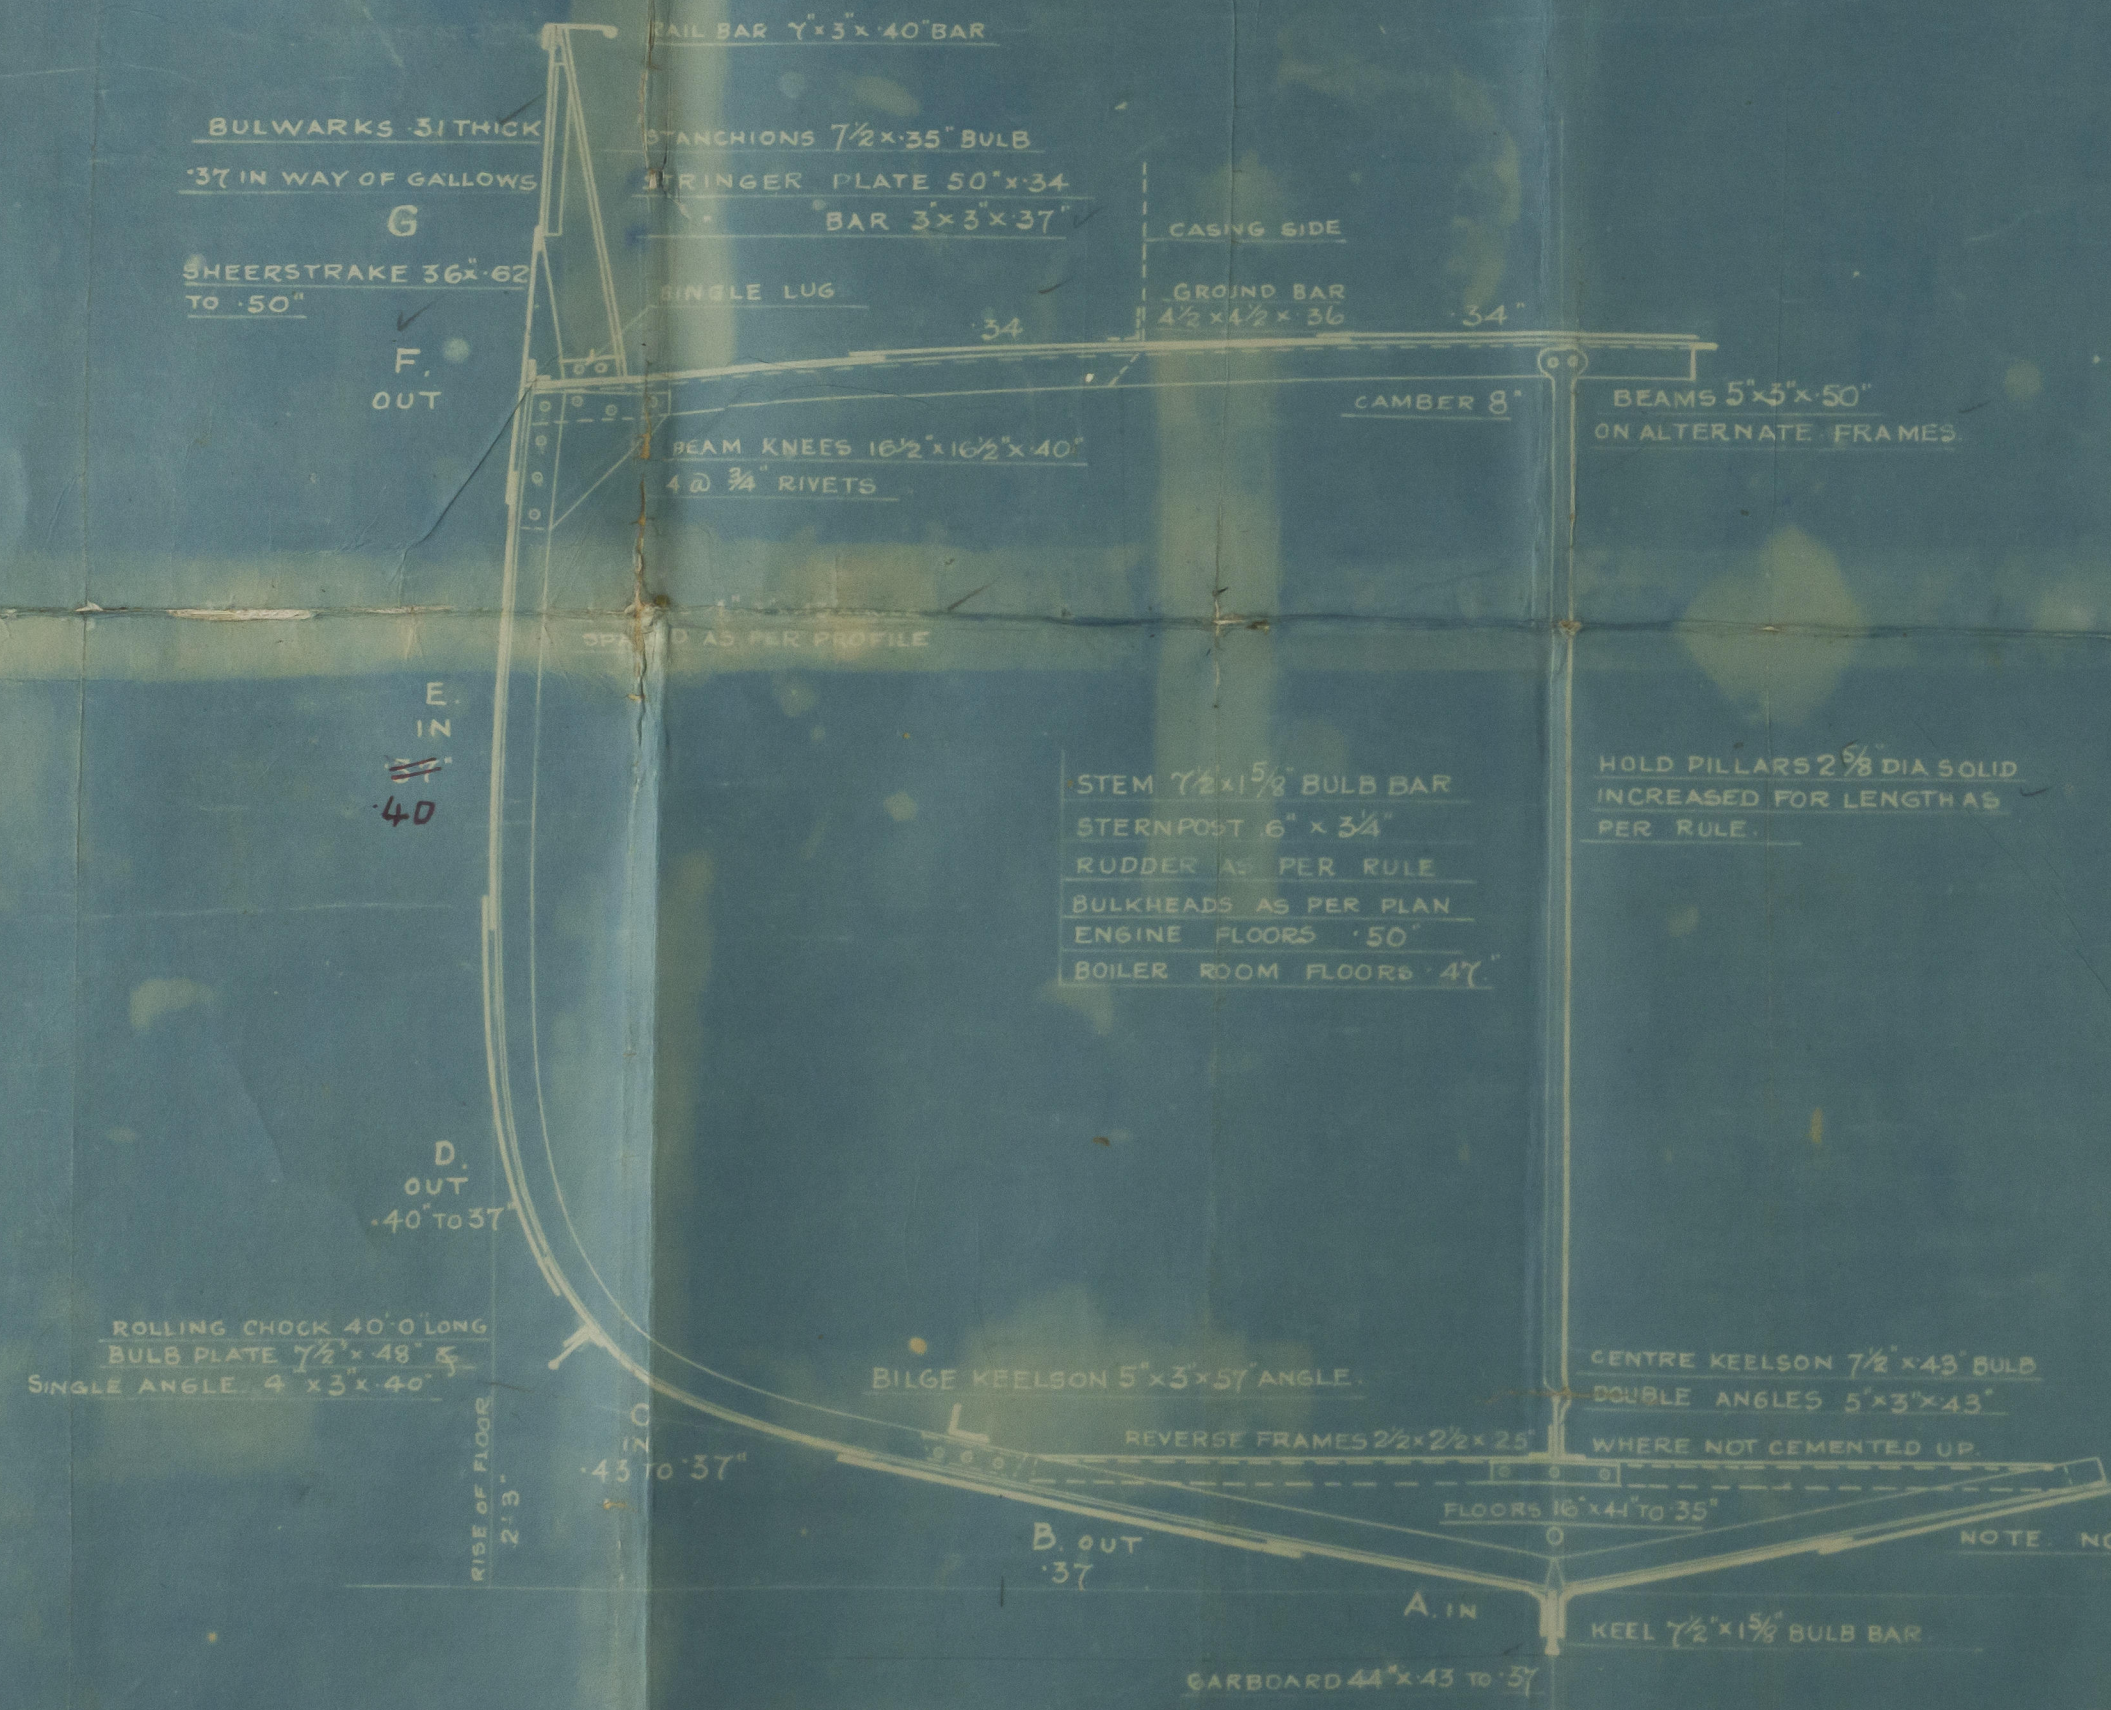

NUMERALS  
 TRANSVERSE B+D 37-12  
 LONGITUDINAL (B+D) XL 5134-80


PROPORTIONS  
 BREADTHS IN LENGTH 5-85  
 DEPTHS IN LENGTH 10-24  
 DEPTH "d" 12-17

EQUIPMENT  
 1ST BOWER ANCHOR 9 CWTs - STOCKLESS  
 2ND " " 7 1/2 " " "  
 KEDGE ANCHOR 2 1/2 CWTs - EX STOCK  
 120 FMS 1 3/16 STUD LINK CABLE  
 80 " 6" HAWSER  
 60 " 5" WARP

RIVETING  
 BUTTS OF SHELL PLATING LAPPED AND DOUBLE RIVETED, EXCEPT GARBOARD AND SHEERSTRAKE WHICH WILL BE STRAPPED AND DOUBLE RIVETED  
 SHELL LANDINGS DOUBLE RIVETED  
 BULWARK LANDING SINGLE RIVETED  
 SHELL RIVETS 3/4 DIA IRON  
 KEEL, STEM AND STERNFRAME RIVETS 1 DIA IRON

~ SCALE 1/2 IN = 1 FT. ~

Ct.  
 27-6-18

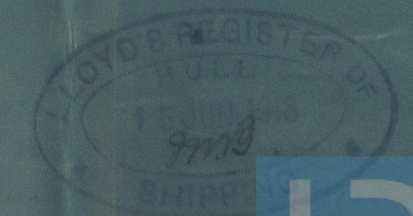

© 2020  
 Lloyd's Register  
 Foundation

003421-003428-0120

WIDSHIP SECTION



HANSTEIN  
Mersey Trawlers.

—  
Bochrane + Sons.  
nos 874-933

—  
"Excellent"  
ex "William Leech"

—  
Midship Sec.

D. 190



© 2020

Lloyd's Register  
Foundation

003421-003428-0120