

27.2.19.
30.5.19.


LONGITUDINAL SECTION AND DECK PLAN.
S.S. RAISED QUARTER DECK CARGO COASTING STEAMER N^o 372.

DIMENSIONS:- 143'-0" B.P. x 25'-0" B.M.D. x 12'-9" TO UPPER DK. 16'-9" TO QUARTER DK.

TO CLASS 100 A.I. LLOYDS.

NO HOLD PILLARS.

SCALE 1/4" = 1 FOOT.

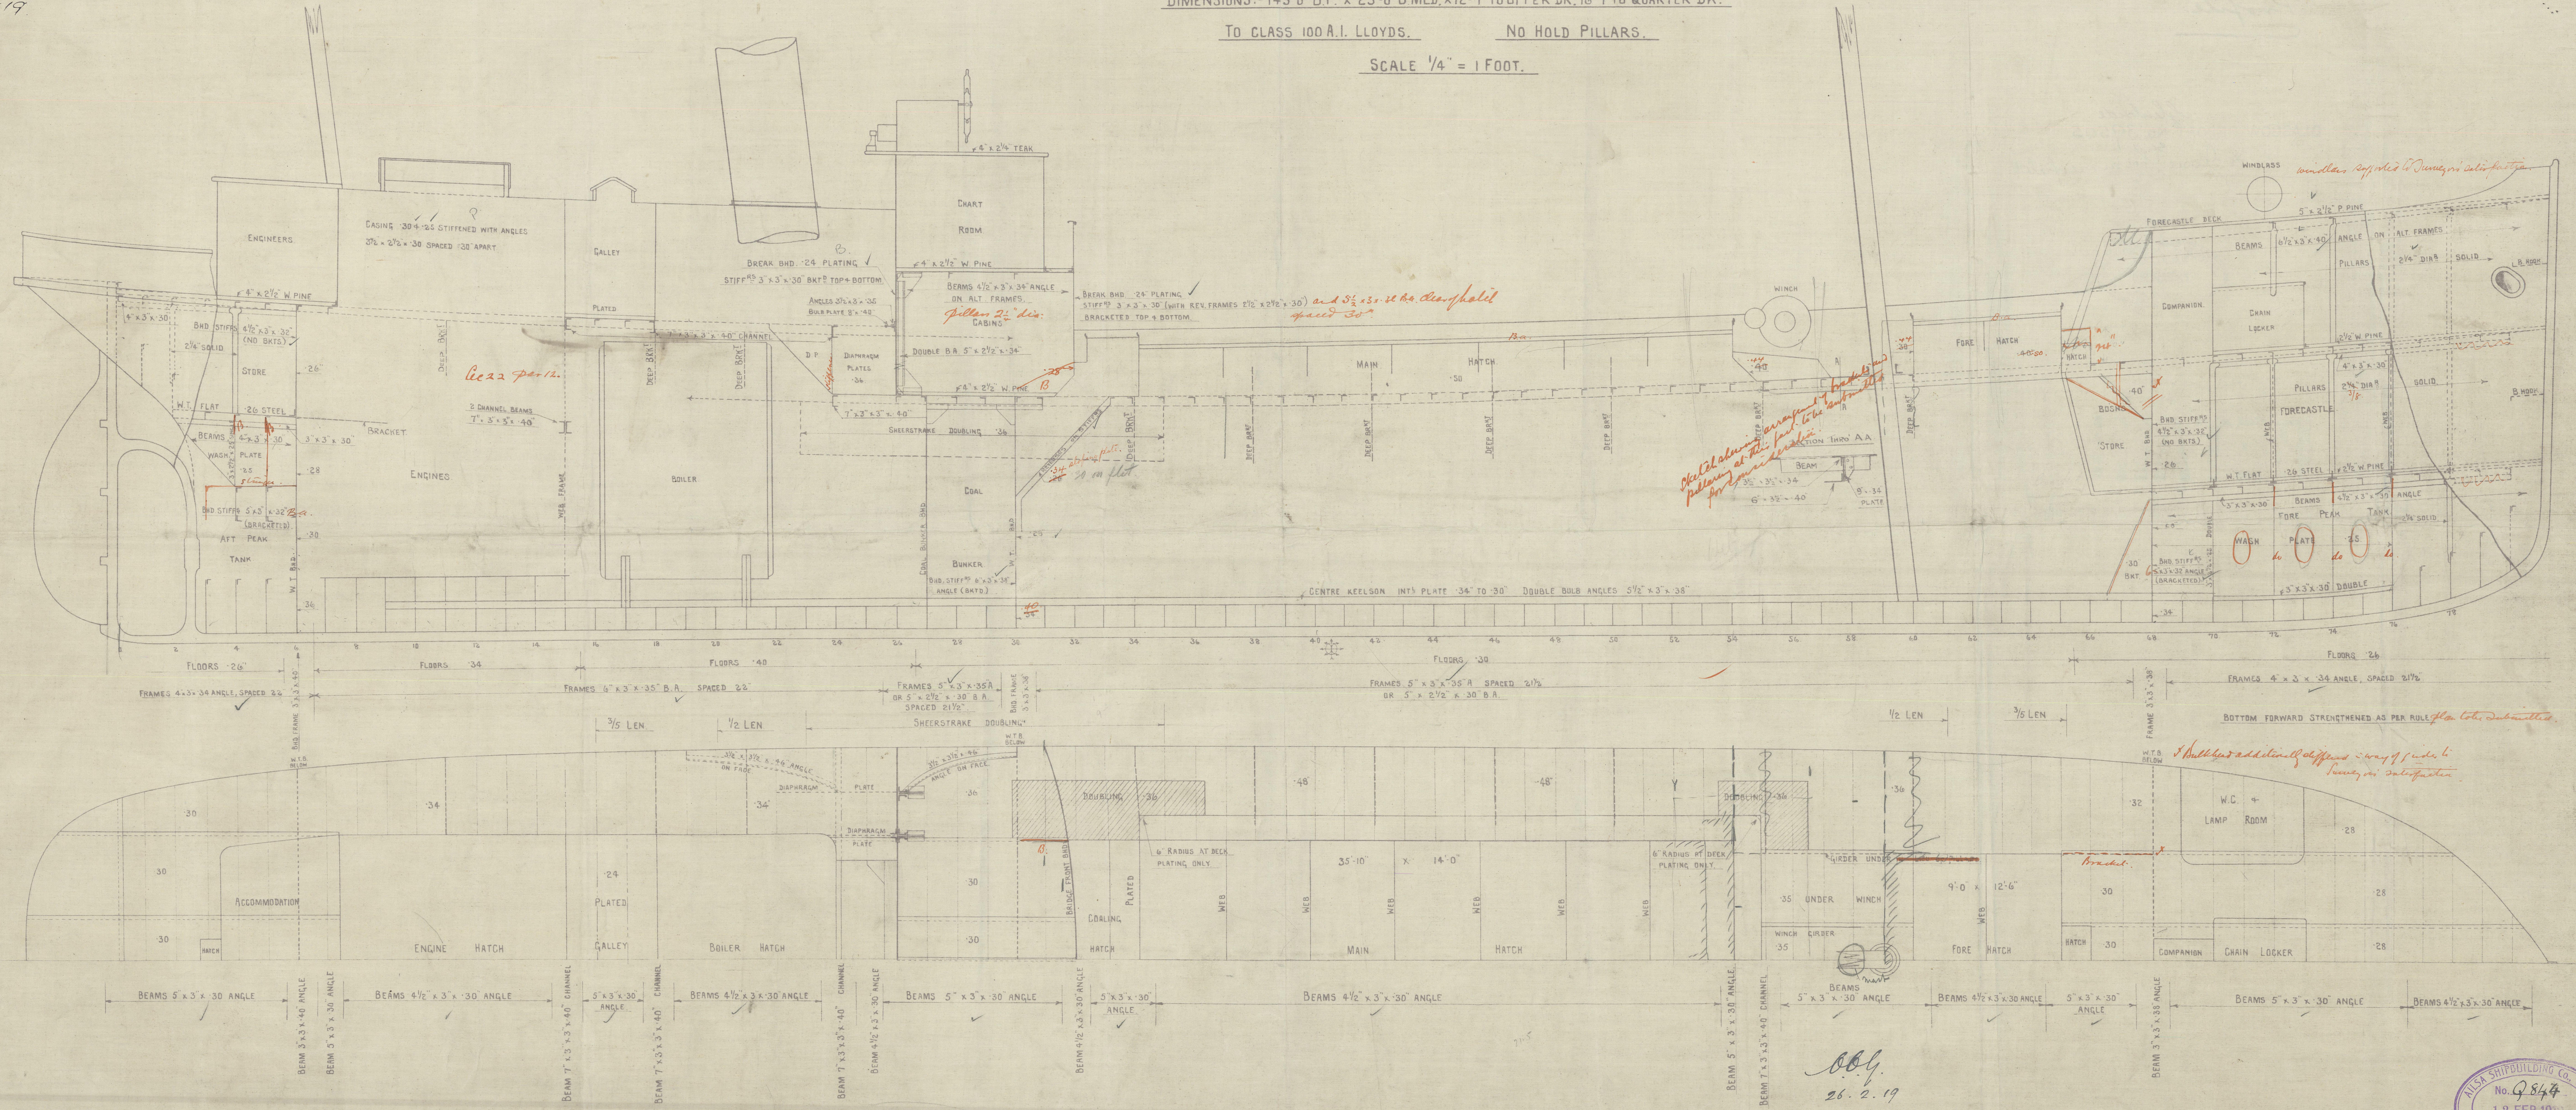

26.2.19

Ailsa Coe

ho 3 1/2



© 2020

Lloyd's Register
Foundation

003421-003428-0199

Ailsa Cos.

No. 372

Profile.

Glentworth
GLASGOW REPORT No. 39505

By Jessie Summerfield



© 2020

Lloyd's Register
Foundation

003421-003428-0199