

11 FEB 1955

M.V. "AVON VENTURER"
 CONVERSION TO IRON ORE CARRIER
 TRANSVERSE SECTION.
 PLAN N° A.V. 4
 SCALE: 1/2" = ONE FOOT

See also late plan
 22/3/53

EXISTING SCANTLINGS MARKED THUS X

TRANSVERSES 9'-8" APART
 LONGITUDINALS AT DK 2'-7" APART



SUMMER DRAUGHT 27'-8 1/4"
 Class: 100 A1 "Longitudinal framing at
 bottom and at deck"

UPPER DECK LONGITUDINALS 12"x4"x4"x1/8" C/S
 EXCEPT WHERE MARKED X

BKT'S AT TRANSVERSE B¹⁰
 39"x39"x50" FLANGED 4"
 15-7/8" RIVS IN EACH ARM
 16


Increased scantlings to extend from within the poop
 to the 1/2 L forward. Beyond the 1/2 L forward, scantlings
 to taper gradually to existing structure.

Compensation to be provided for access
 openings to wing tanks in way of main
 cargo hatches.

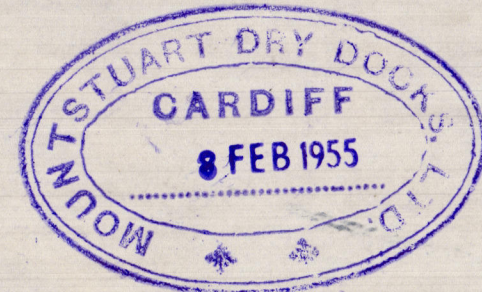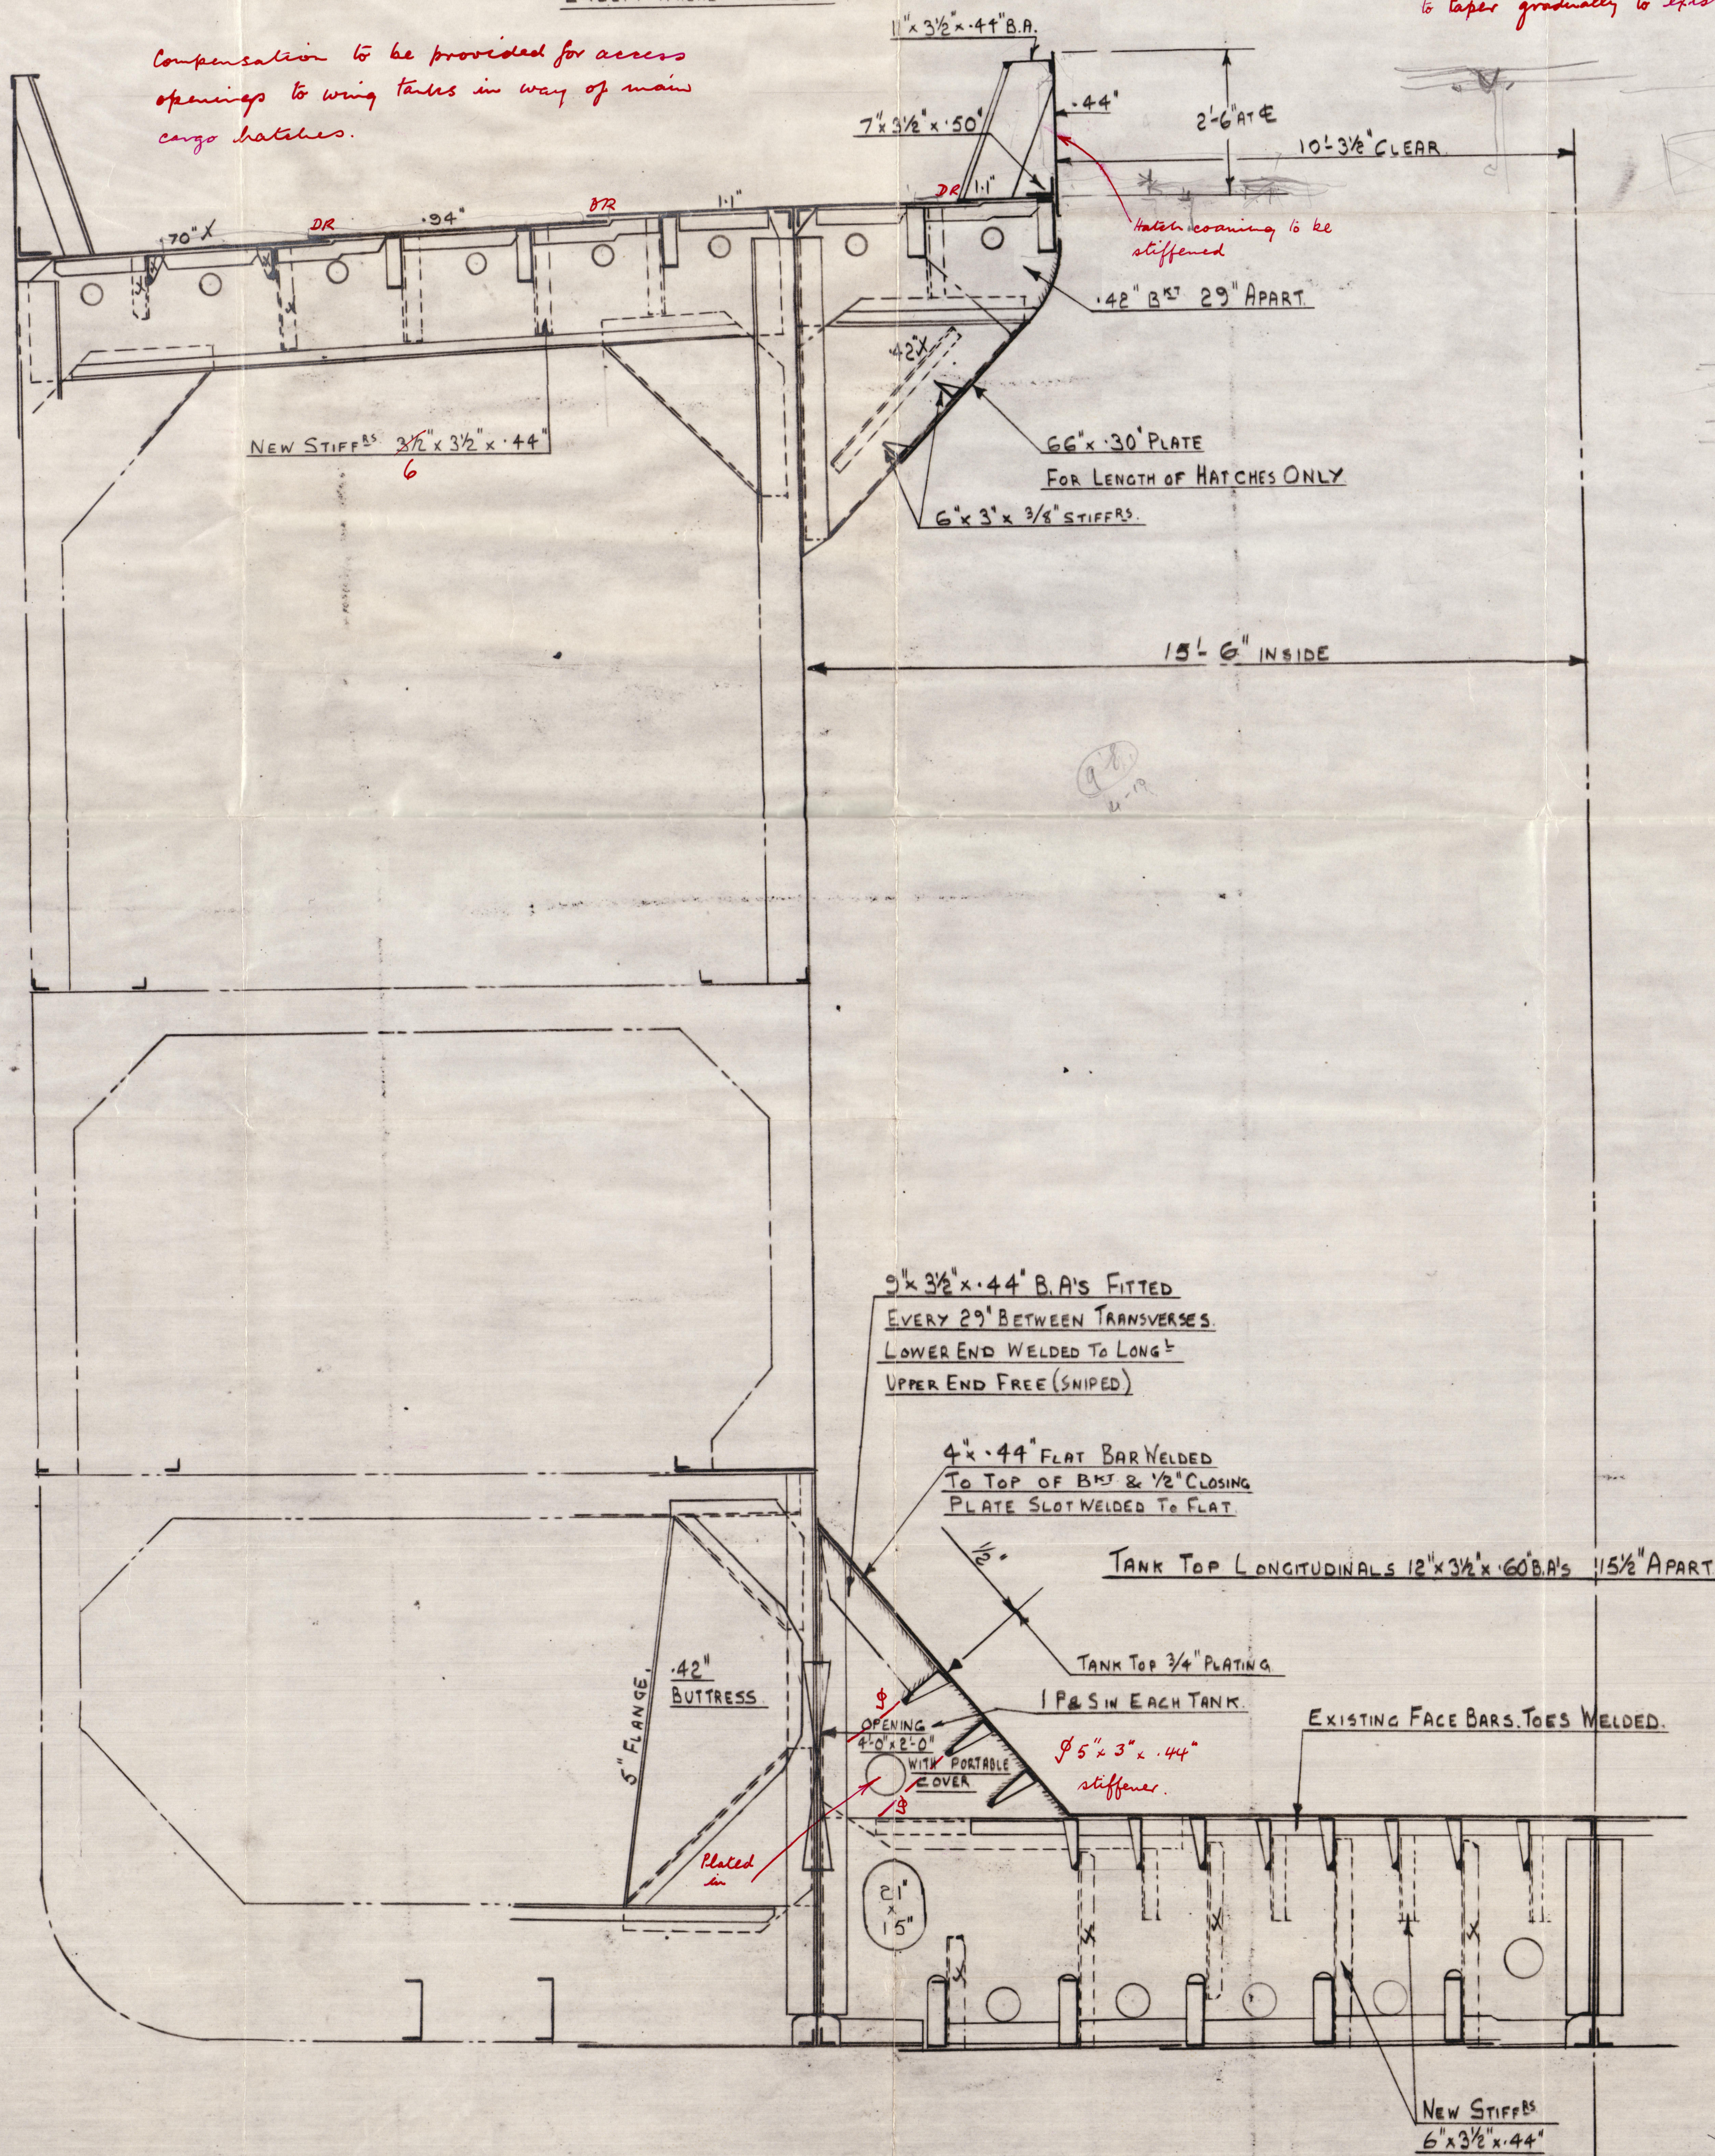

See also late plan
 22/3/53

RECORDS DEPT.
LONDON.

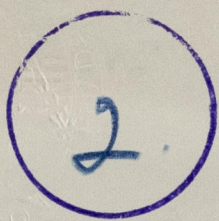

AVON VENTURER

CARDIFF

REPORT No: 59508

TRANSVERSE SECTION



© 2020

Lloyd's Register
Foundation

003429-003433-0006