

11 DEC 1927




Approved *[Signature]*
See also "11" 22

RUDDER PLAN.

S. S. N° 348

SCALE 1/2 INCH = ONE FOOT
RUDDER TO BE FORGED OF BEST SCRAP IRON. RIVET HOLES 15/16 DIA.
SPACED AS SHOWN ON PLAN. AREA OF RUDDER 85.99 SQ. FT.

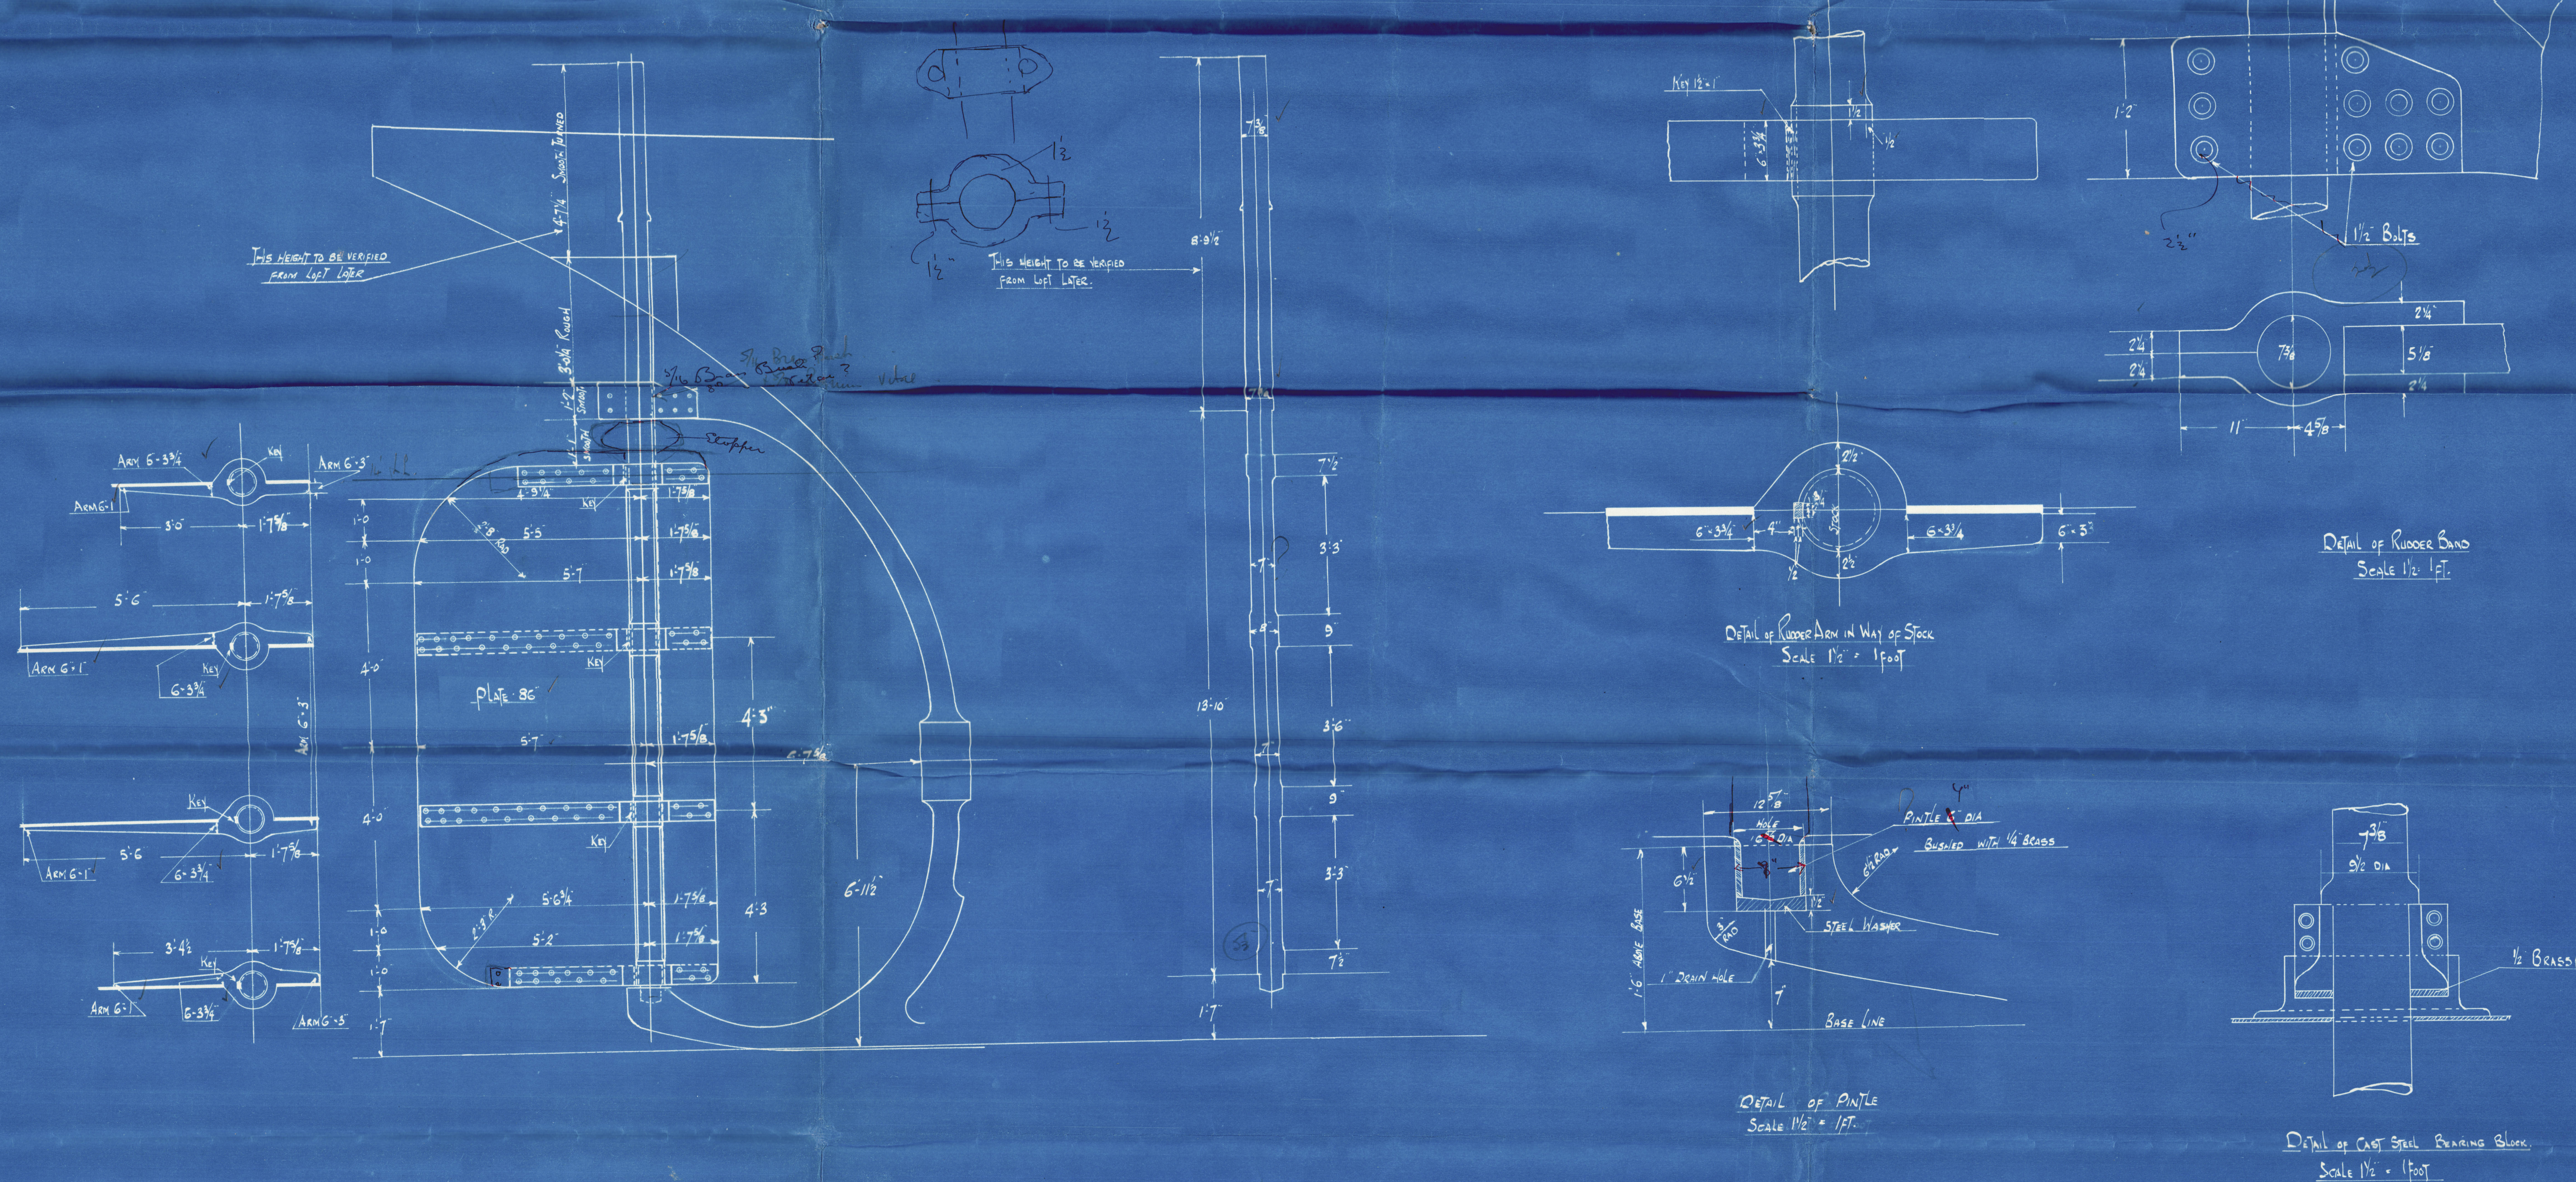

DUNLOP BRENNER & CO. LTD.

Shipbuilders, Engineers and Dockers.

11th FLOORS, PORT-GLASGOW

11th FLOORS, PORT-GLASGOW

Dunlop Bremner
Ridder plan

Bag

Dunlop. Bremner & Co
N^o 348

Ridder plan

11-12-32

Starmount
"Pabjune"
38.



© 2020

Lloyd's Register
Foundation

003429-003433-0042